



TERAVALIS PHASE 1 SOILS CEMENT & RIPRAP INFRASTRUCTURE CFD

ADDENDUM NUMBER: 02

FOR

SOIL CEMENT AND RIPRAP

The following changes shall become part of the bid documents for the above referenced project:

1. Included in this addendum is a revised bid schedule. This Addendum No.2 bid schedule must be submitted with your bid.
2. Included in this addendum is the soil cement mix design for this bid.
3. Included in this addendum is the typical detail for the construction of the access roads.
4. Included in this addendum is a revised mass grading sheets DC01 through DC21.
These plans show limits of soil cement and riprap areas to be included in this bid.
 - a. Sheet DC01 - Added station and offset at the start and end of the soil cement. for construction of the access road see Floreo at Teravalis.
 - b. Sheet DC10 – Added to show stations to show start and end of soil cement for access road.
 - c. .On sheet DC11 - Fixed rip-rap, stops at the top of the slope. rip-rap at station 0+00 is d50=9", 24" thickness loose rip-rap.
5. All riprap shall be angular
6. Riprap spec is Rock Pro's – Color shall be Carmel 3" – 8" size material.

**Trillium Community Facilities District
BUCKEYE, ARIZONA**

TERAVALIS PHASE 1 SOIL CEMENT & RIPRAP INFRASTRUCTURE CFD

ADDENDUM NO. 2

Bid Schedule

<u>ITEM #</u>	<u>ITEM DESCRIPTION</u>	<u>UNIT</u>	<u>QUANTITY</u>	<u>UNIT PRICE</u>	<u>TOTAL PRICE</u>
<u>TERAVALIS PHASE 1 SOIL CEMENT & RIPRAP INFRASTRUCTURE CFD</u>					
TERAVALIS PHASE 1 SOIL CEMENT & RIPRAP INFRASTRUCTURE CFD - SWPP					
1	Install and maintain SWPP per plans	LS	1	Lump Sum	\$
TERAVALIS PHASE 1 SOIL CEMENT & RIPRAP					
2	Install soil cement per MAG Specification 311 per detail Sheet DC21	SY	70,750	\$	\$
3	Install loose riprap D50=9" thickness 18" with filter fabric - Mirafi erosion geo-textile	SY	990	\$	\$
4	Install loose riprap D50=9" thickness 24" with filter fabric - Mirafi erosion geo-textile	SY	2,009	\$	\$
5	Install loose riprap D50=6" thickness 12" with filter fabric - Mirafi erosion geo-textile	SY	6,876	\$	\$
6	Install grouted riprap D50=15" thickness 30" with filter fabric - Mirafi erosion geo-textile	SY	2,988	\$	\$
7	Install launchable riprap D50=12", 24" Thick with 6" ABC Cover	SY	9,210	\$	\$
8	Install 20' wide all-weather access road - 6" thick stablized DG 1/4" minus slope to be 10:1 max	SY	1,528	\$	\$
9	Install 20' wide , 9" thick Class A concrete access ramp. Slope to be 10:1 Max	SY	589	\$	\$
TERAVALIS PHASE 1 SOIL CEMENT & RIPRAP : General Items					
9	Mobilization	LS	1	LUMP SUM	\$
10	AZPDES Permit Compliance/Dust Control	LS	1	LUMP SUM	\$
11	Construction Survey and Staking	LS	1	LUMP SUM	\$
12	Off-Duty Police Officer (Contingency Item)	HRS	40		\$ -
13	Buckeye Police Department Patrol Car (Contingency Item)	HRS	40		\$ -
TOTAL TERAVALIS PHASE 1 SOIL CEMENT & RIPRAP INFRASTRUCTURE CFD: BASE BID (Sum of Items 1 to 13)					\$

Memorandum Letter



geotechnical

Project No.: 220748-G

survey

Date: September 21, 2023

environmental

Client: Howard Hughes Corporation
4150 North Drinkwater Boulevard, Suite 101
Scottsdale, Arizona 85251

special
inspections

Project: Trillium Village 3 – Drainage Channel
Buckeye, AZ

material
testing

Regarding: Soil Cement Recommendations

civil

At the request of our client, Alta Arizona presents the following design recommendations regarding mixing cement into the existing site soil at the above referenced project. The recommendations are based on the specification provided in the Soil Cement Mix Design provided by Hilgart Wilson dated September 7, 2023 (mix design). This letter is intended to summarize our efforts, present laboratory test results, and provide recommendations.

Alta created a composite sample of six samples along the channel alignment. The samples were relatively similar in soil classification. These samples consisted primarily of medium plasticity Clayey Sand (SC) with an AASHTO classification of A-2-6(0). Based on the mix design, a cement content range of 7-11% is recommended for this spoil type. The sample was mixed with 7, 9 and 11 percent of Type 2 Portland cement (by weight) in accordance with test method ARIZ-241.

Phoenix

Tucson

Benson

Flagstaff

Tabulated below is a summary of the compressive strength of each mixture after 7 days of being cured. For additional information refer to the attached laboratory test results. The specified minimum compressive strength according to the mix design is 750 psi, exceeded by each specimen.

Test Results		
Cement Content (by weight)	Age (Days)	Compressive Strength (psi)
7%	7	1,432
9%	7	1,542
11%	7	1,853

Based on the results of the laboratory analysis, we recommend treating the exposed subgrade soils with 7% Portland cement.

We appreciate the opportunity of providing our services for this project. If you have questions regarding this report or if we may be of further assistance, please contact the undersigned.

Cordially,
Alta Arizona



Sean P Fabor, P.E.
Principal

1800 W Broadway
Rd, Suite 5
Tempe, AZ 85282

2025 W Ruthrauff Rd
Suite 125
Tucson, AZ 85710

480.656.1517
520.398.6651

SUMMARY OF RESULTS

Alta Arizona
1800 W Brodaway Rd, Suite 5
Tempe, Arizona 85282


PROJECT: Trillium at Douglas Ranch
CLIENT: Howard Hughes Corporation
MATERIAL: Un Treated Native
SAMPLE SOURCE: Untreated Composite sample of 6 locations
PROPOSED USE: Soil Cement Design

PROJECT NO: 220748
LABORATORY NO: 23-39921
SAMPLE DATE: 9/11/2023
SAMPLED BY: OA

LABORATORY COMPACTION CHARACTERISTICS OF SOILS USING STANDARD PROCTOR (12,400ft-lb-ft/cu.ft) (ASTMD698A) SIEVE ANALYSIS OF FINE AND COARSE AGGREGATES (ASTM C136/C117) LIQUID LIMIT, PLASTIC LIMIT, AND PLASTICITY INDEX OF SOILS (ASTM D4318) (DRY PREP)

CURVE: 23-39921
Maximum dry density:
Optimum moisture (%):

English (pcf)	Metric (kg / cu.m.)	Rock Correction for + #4 material
119.3	1911	125.8
13.1	13.1	10.4

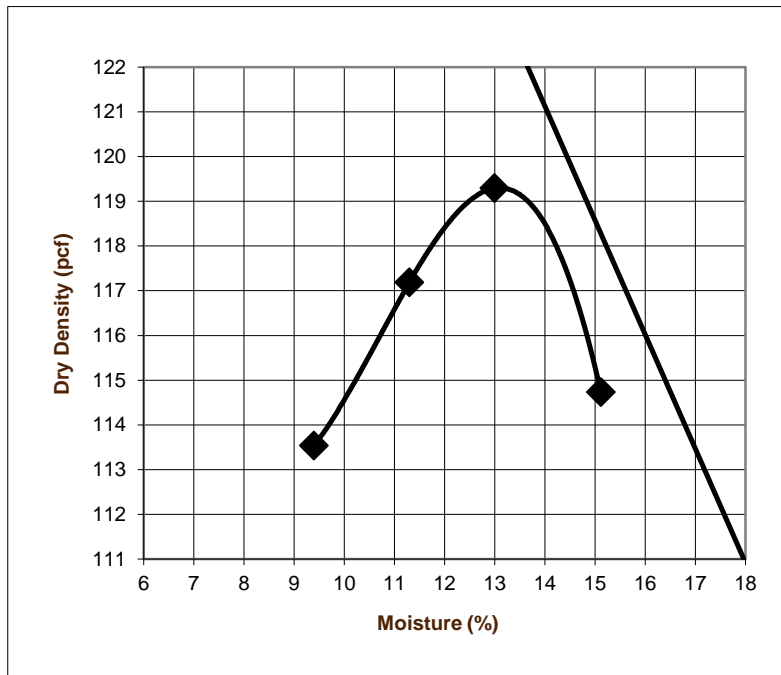

SIEVE SIZE PERCENT PASSING

6 in / 152mm	100
4 in / 100mm	100
3 in / 75mm	100
2 in / 50mm	100
1 1/2 in / 37.5mm	100
1 1/4 in / 32 mm	100
1 in / 25 mm	98
3/4 in / 19 mm	97
1/2 in / 12.5 mm	92
3/8 in / 9.5 mm	89
1/4 in / 6.4 mm	83
#4, 4.75mm	78
#8, 2.36mm	71
#10, 2.00mm	68
#16, 1.18mm	56
#30, 0.60mm	45
#40, .425mm	40
#50, .300mm	35
#100, .150mm	28
#200, .075mm	22

LL: 34

PI: 12

USCS: SC
AASHTO: A-2-6(0)

NOTES:

- The zero air void curve represents a specific gravity of: 2.65 assumed for the -#4 material.
- This is a summarized report of the referenced procedures. Additional data can be provided at clients request.

Description: Clayey gravel and sand

Signature:



Name:

J Baer



PROCTOR TEST

Alta Arizona
1800 W Broadway Rd, Suite 5
Tempe, Arizona 85282

PROJECT: Trillium at Douglas Ranch
CLIENT: Howard Hughes Corporation
MATERIAL: Cement Treated Native with 9% Cement Added
SAMPLE SOURCE: Cement Treated Native Composite sample of 6 locations
PROPOSED USE: Soil Cement Design


PROJECT NO: 220748
LABORATORY NO: 23-39921
SAMPLE DATE: 9/11/2023
SAMPLED BY: OA

LABORATORY COMPACTION CHARACTERISTICS OF SOILS USING STANDARD PROCTOR (12,400ft-lb-ft/cu.ft) (ASTMD698A)

CURVE: 23-39921
Maximum dry density:
Optimum moisture (%):

English (pcf)	Metric (kg/ cu.m.)	Lab Rock Correction for + #4
115.7	1853	123.0
14.0	14.0	11.2

**SIEVE
SIZE** **PERCENT
PASSING**
#4, 4.75mm 78.0

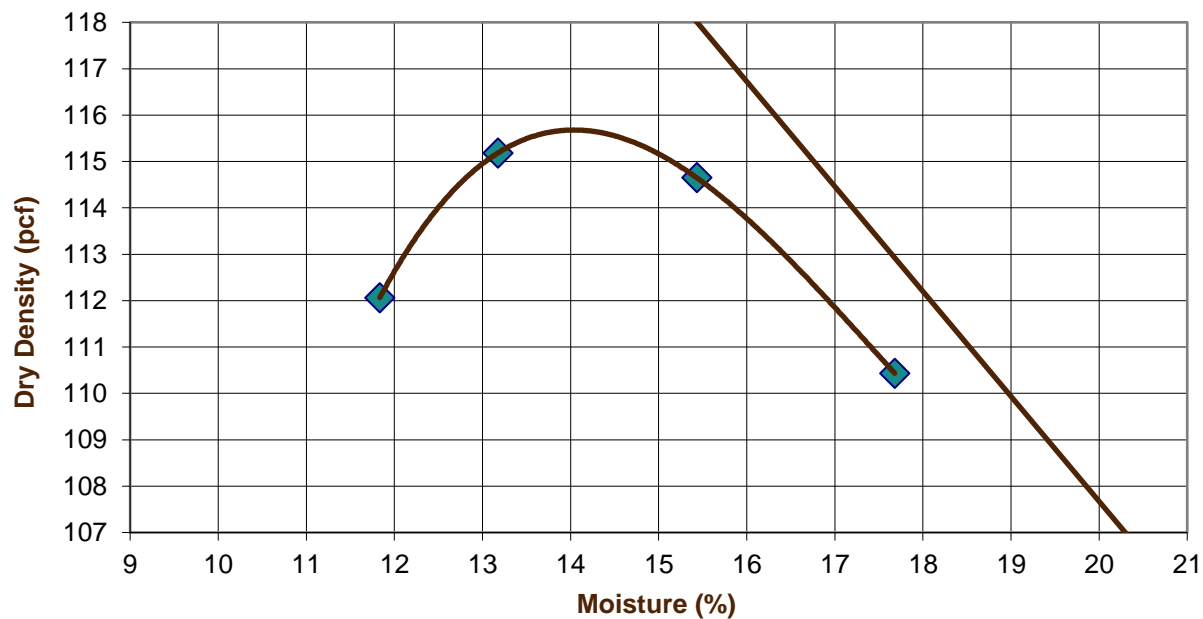

NOTES:

- The zero air void curve represents a specific gravity of: 2.65 (assumed).
- This is a summarized report of the referenced procedures. Additional data can be provided at clients request.

Signature:

Name:

J Baer



Compression Results

Alta Arizona
1800 W. Broadway Rd, Suite 5
Tempe, Arizona 85282

PROJECT: Trillium at Douglas Ranch
CLIENT: Howard Hughes Corporation
SAMPLE DATE: 9/13/2023

PROJECT NO: 220748
LABORATORY NO: 39921
REPORT DATE: 09/20/23

SPECIMEN TYPE												
SPECIMEN TYPE:		Soil Cement (ASTM 5102) Method A										
MIX & FIELD DATA												
Placement Area:		7% Cement Added to Native Compositite Sample										
Sample Storage Location:		Cured in sealed container until break date										
Design Strength (psi):		750		@ 7 days								
Specified Strength (psi):		750		@ 7 days								
Mix ID #:				Specified Measured								
Supplier:				Slump (inches) ASTM C-143:				<table border="1"><tr><td></td><td></td></tr></table>				
Load #:				Air Content (%) ASTM C-231:				<table border="1"><tr><td></td><td></td></tr></table>				
Truck #:				Unit Wt. (pcf) ASTM C-138:				<table border="1"><tr><td></td><td></td></tr></table>				
Ticket #:				Weather:								
Batch Size				Ambient Temp (°F):								
Water added:				Concrete Temp (°F) ASTM C1064:								
Admixtures:				Date Received:								
Batch time:				LAB Technician: J Baer								
Sample time:												
TEST RESULTS												
Lab No	Spec No.	Date Tested	Age (Days)	Spec Size	Area (sq. in)	Comp Strength (lbs.)	Comp Strength (psi)	Break Type	% of Design	% of Specified		
39921	A	09/18/23	5	3.99	12.50	12680	1014	2	135%	135%		
39921	B	09/20/23	7	3.99	12.50	18250	1460	2	195%	195%		
39921	C	09/20/23	7	3.99	12.50	17900	1432	2	191%	191%		
Notes/Remarks: Samples remolded based on ASTM D698 Proctor Value and Moisture %												
Type of Fracture: (1) Brittle (2) Cylindrical (3) Barrel												
Lab Signature: _____							Average 7 DAY BREAK (psi)					
							<table border="1"><tr><td>1432</td></tr></table>				1432	
1432												



Compression Results

Alta Arizona
1800 W. Broadway Rd, Suite 5
Tempe, Arizona 85282

PROJECT: Trillium at Douglas Ranch
CLIENT: Howard Hughes Corporation
SAMPLE DATE: 9/13/2023

PROJECT NO: 220748
LABORATORY NO: 39921
REPORT DATE: 09/20/23

SPECIMEN TYPE												
SPECIMEN TYPE:		Soil Cement (ASTM 5102) Method A										
MIX & FIELD DATA												
Placement Area:		9% Cement Added to Native Composite Sample										
Sample Storage Location:		Cured in sealed container until break date										
Design Strength (psi):		750		@ 7 days								
Specified Strength (psi):		750		@ 7 days								
Mix ID #:				Specified Measured								
Supplier:				Slump (inches) ASTM C-143:				<table border="1"><tr><td></td><td></td></tr></table>				
Load #:				Air Content (%) ASTM C-231:				<table border="1"><tr><td></td><td></td></tr></table>				
Truck #:				Unit Wt. (pcf) ASTM C-138:				<table border="1"><tr><td></td><td></td></tr></table>				
Ticket #:				Weather:								
Batch Size:				Ambient Temp (°F):								
Water added:				Concrete Temp (°F) ASTM C1064:								
Admixtures:				Date Received:								
Batch time:				LAB Technician: J Baer								
Sample time:												
TEST RESULTS												
Lab No	Spec No.	Date Tested	Age (Days)	Spec Size	Area (sq. in)	Comp Strength (lbs.)	Comp Strength (psi)	Break Type	% of Design	% of Specified		
39921	A	09/18/23	5	3.99	12.50	14200	1136	2	151%	151%		
39921	B	09/20/23	7	3.99	12.50	19140	1531	2	204%	204%		
39921	C	09/20/23	7	3.99	12.50	19280	1542	2	206%	206%		
Notes/Remarks: Samples remolded based on ASTM D698 Proctor Value and Moisture %												
Type of Fracture: (1) Brittle (2) Cylindrical (3) Barrel												
Lab Signature: _____							Average 7 DAY BREAK (psi)					
							<table border="1"><tr><td>1542</td></tr></table>				1542	
1542												





Compression Results

Alta Arizona
1800 W. Broadway Rd, Suite 5
Tempe, Arizona 85282






PROJECT: Trillium at Douglas Ranch
CLIENT: Howard Hughes Corporation
SAMPLE DATE: 9/13/2023

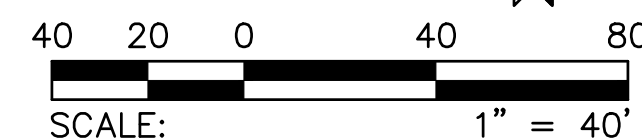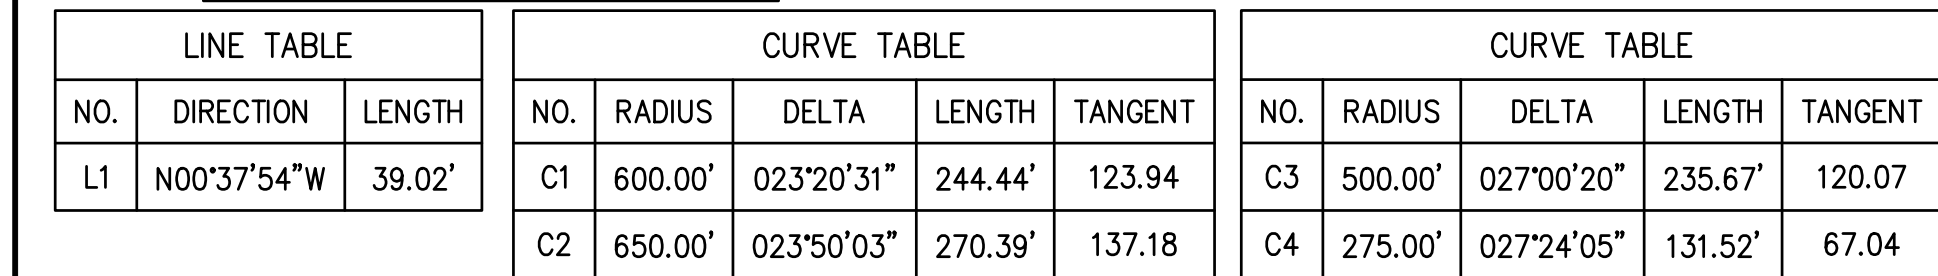PROJECT NO: 220748
LABORATORY NO: 39921
REPORT DATE: 09/20/23

SPECIMEN TYPE												
SPECIMEN TYPE:		Soil Cement (ASTM 5102) Method A										
MIX & FIELD DATA												
Placement Area:		11% Cement Added to Native Compositite Sample										
Sample Storage Location:		Cured in sealed container until break date										
Design Strength (psi):		750		@ 7 days								
Specified Strength (psi):		750		@ 7 days								
Mix ID #:				Slump (inches) ASTM C-143:				Specified Measured				
Supplier:				Air Content (%) ASTM C-231:				<table border="1"><tr><td></td><td></td></tr></table>				
Load #:				Unit Wt. (pcf) ASTM C-138:				<table border="1"><tr><td></td><td></td></tr></table>				
Truck #:				Weather:								
Ticket #:				Ambient Temp (°F):								
Batch Size:				Concrete Temp (°F) ASTM C1064:								
Water added:				Date Received:								
Admixtures:				LAB Technician: J Baer								
Batch time:												
Sample time:												
TEST RESULTS												
Lab No	Spec No.	Date Tested	Age (Days)	Spec Size	Area (sq. in)	Comp Strength (lbs.)	Comp Strength (psi)	Break Type	% of Design	% of Specified		
39921	A	09/18/23	5	3.99	12.50	16930	1354	2	181%	181%		
39921	B	09/20/23	7	3.99	12.50	21060	1685	2	225%	225%		
39921	C	09/20/23	7	3.99	12.50	23160	1853	2	247%	247%		
Notes/Remarks: Samples remolded based on ASTM D698 Proctor Value and Moisture %												
Type of Fracture: (1) Brittle (2) Cylindrical (3) Barrel												
Lab Signature: _____							Average 7 DAY BREAK (psi)					
							1853					



2 CHANNEL ALIGNMENT AND CHANNEL SECTION WIDTH CHANGED. SECTION A HAS BEEN DELETED. GRADING AND WSE WERE REVISED. SOIL CEMENT AND GROUTED RIPRAP ADDED. DROP STRUCTURES WERE REMOVED.

- | | |
|---|---|
|  | Soil Cement Areas |
|  | Riprap Areas |
|  | Access Road Areas 9" MAG A
concrete ramp |
|  | Access Road Areas Stabilized
Granite |
|  | Areas not included in bid |

LEGEND


- | | |
|--|--|
| | VILLAGE 3 BOUNDARY |
| | EROSION HAZARD SETBACK |
| | RIGHT OF WAY |
| | LOT LINE |
| | CENTER LINE |
| | EASEMENT LINE |
| | FLOW DIRECTIONAL INDICATOR |
| | FINISH PAD ELEVATION (FINISH FLOOR IS 1' ABOVE FP) |
| | EMERGENCY OUTFALL ARROW |
| | HIGH POINT |
| | LOW POINT |
| | DUAL CHAMBER DRYWELL |



U:\1100\1175\ENGR\VILLAGE 3\MASS GRADING\CHANNEL\1175_DC01.dwg 9/7/2023 8:56 AM

STORM DRAIN CONSTRUCTION

- | | | |
|----|--|----------|
| 83 | INSTALL LOOSE ANGULAR RIP-RAP PER MAG SPEC SEC. 220, D50=6", 12" THICK ON MIRAFI EROSION PROTECTION GEO-TEXTILE OR APPROVED EQUIVALENT. FABRIC TO HAVE APPARENT OPENING SIZE OF 0.425MM, PERMITTIVITY OF 50 GAL/MIN/FT AND WOVEN. SEE SHEET DC21 FOR DETAIL AND PLAN SHEET FOR QUANTITY. COLOR PER DEVELOPER. | 103 SY |
| 91 | INSTALL ANGULAR LOOSE RIP-RAP PER MAG SPEC SECTION 220 D50=6" 6" THICK ON MIRAFI EROSION PROTECTION GEO-TEXTILE OR APPROVED EQUIVALENT. FABRIC TO HAVE APPARENT OPENING SIZE OF 0.425MM, PERMITTIVITY OF 50 gal/min/ft and WOVEN. SPECIFIC WEIGHT = 165 lb/ft ³ . GRADATION PER TABLE 6.4 OF 2013 DRAINAGE DESIGN MANUAL FOR MARICOPA COUNTY, ARIZONA (HYDRAULICS). | 10981 SY |
| 96 | INSTALL SOIL CEMENT PER MAG SPEC 311; SEE DETAIL 1 ON SHEET DC21. | 4561 SY |

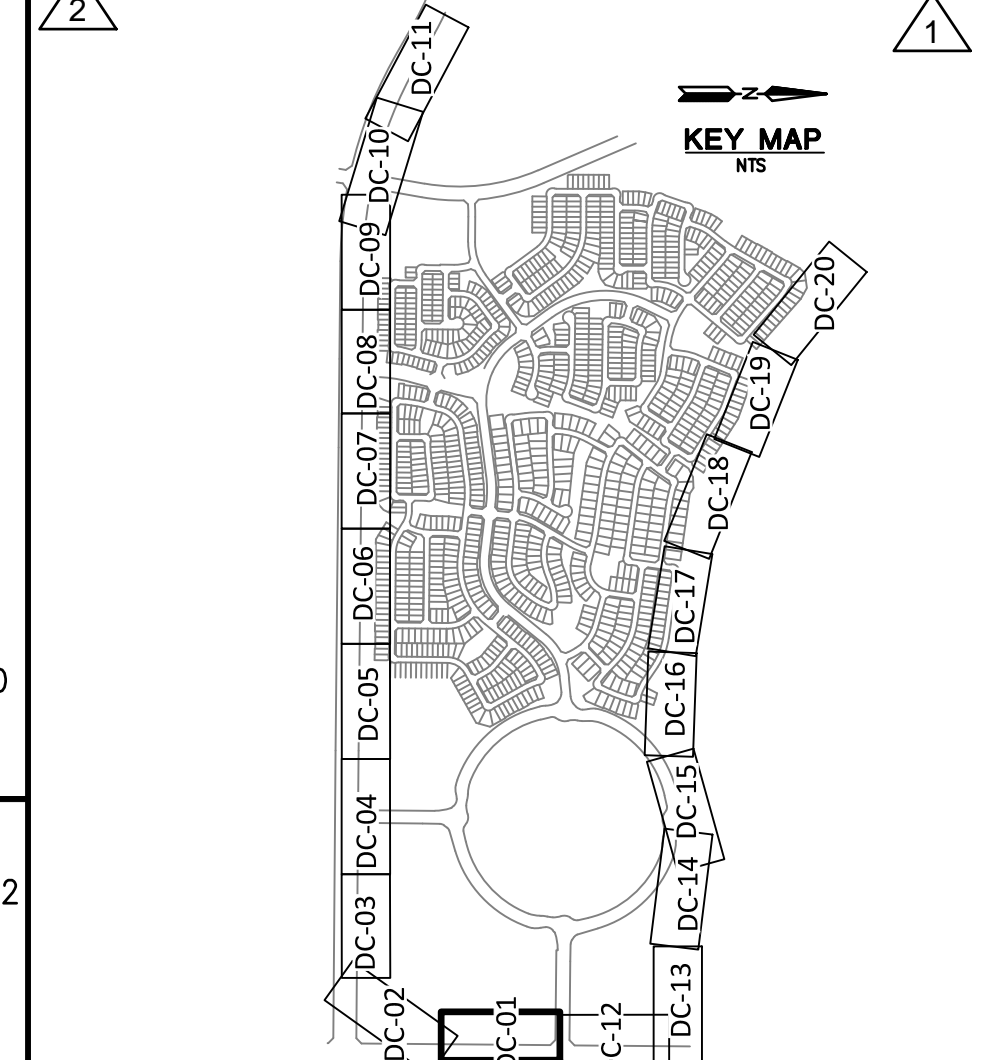

REVISIONS:

- | | | |
|---|---|--|
| 4 | 1 | 12/27/2022 – ROSEWOOD AVENUE WAS EXTENDED AND GRADING REVISED. CHANNEL WAS REVISED ALONG SUN VALLEY PARKWAY TO ACCOMMODATE AN ADDED SIDEWALK. GRADING FOR APS SUBSTATION ADDED & FIRE STATION. THE EROSION HAZARD SETBACK ALONG WAGNER WASH WAS REVISED. |
| | 2 | 8/23/2023 – REVISION TO CHANNEL ALIGNMENT AND REPLACE RIPRAP WITH SOIL CEMENT. |


PLAN NAME

TRILLIUM

VILLAGE 3 - UNITS 1 & 2

DRAINAGE CHANNEL PLAN



ENGINEER INFORMATION

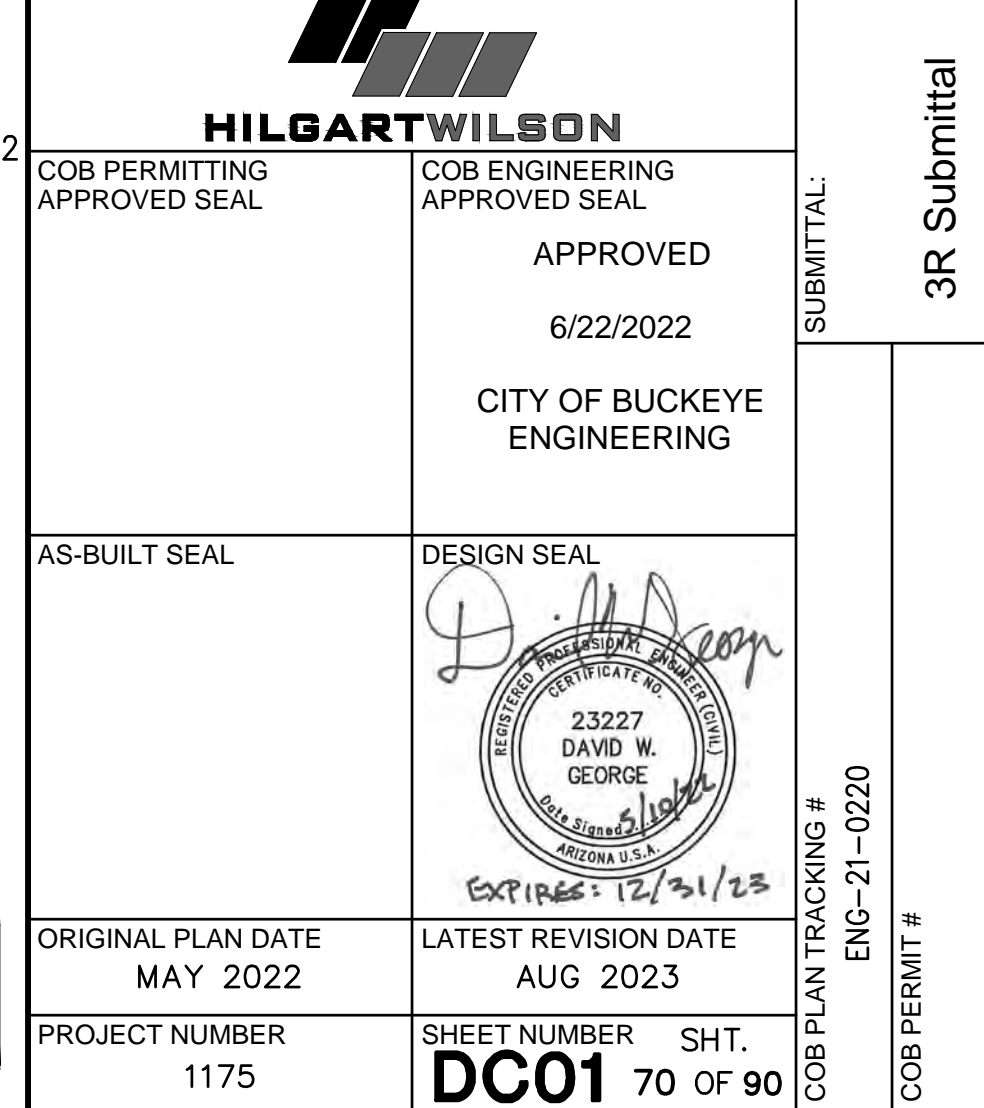


3B Submittal:

COB PLAN TRACKING #	ENG-21-0220
COB PERMIT #	

Copyright, Hilgartwilson. This plan document set is the sole property of Hilgartwilson. No alterations to these plans, other than adding "as-built" information, are allowed by anyone other than authorized Hilgartwilson employees.


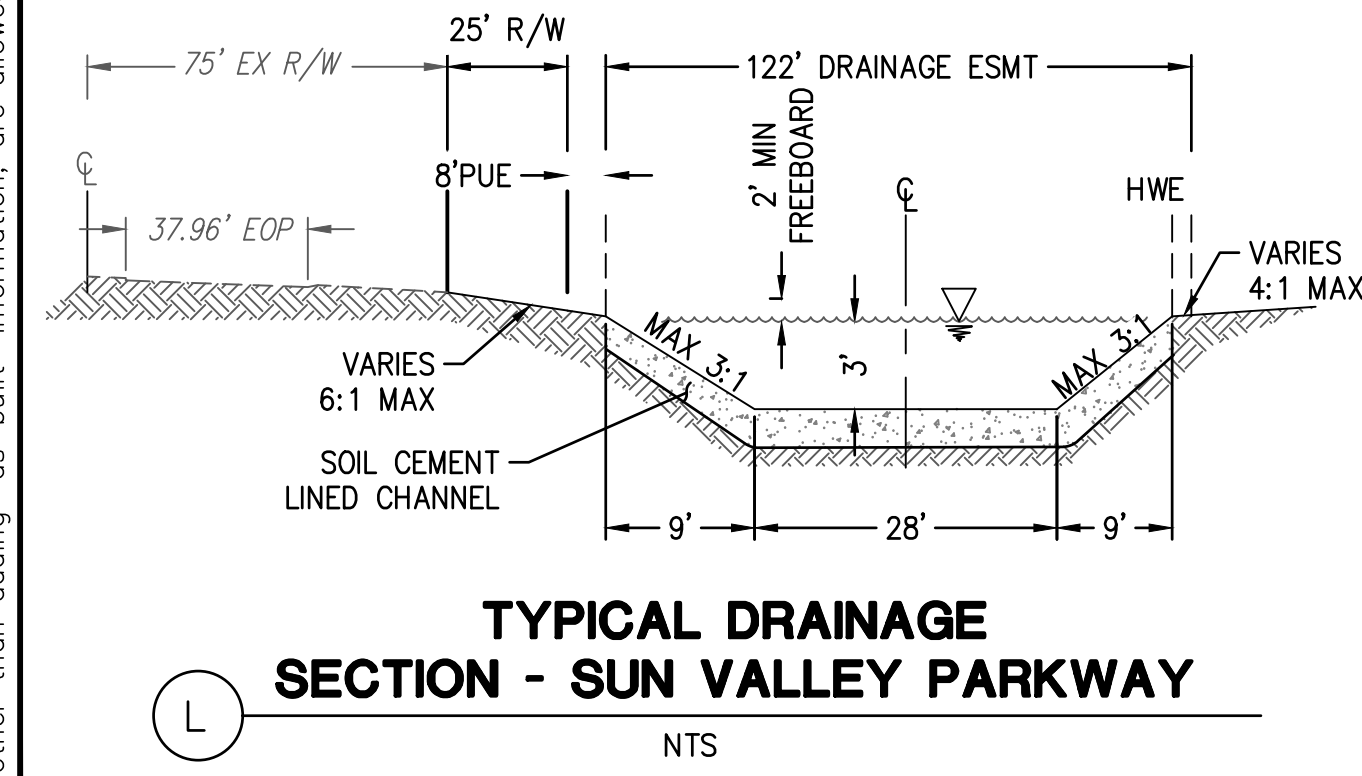
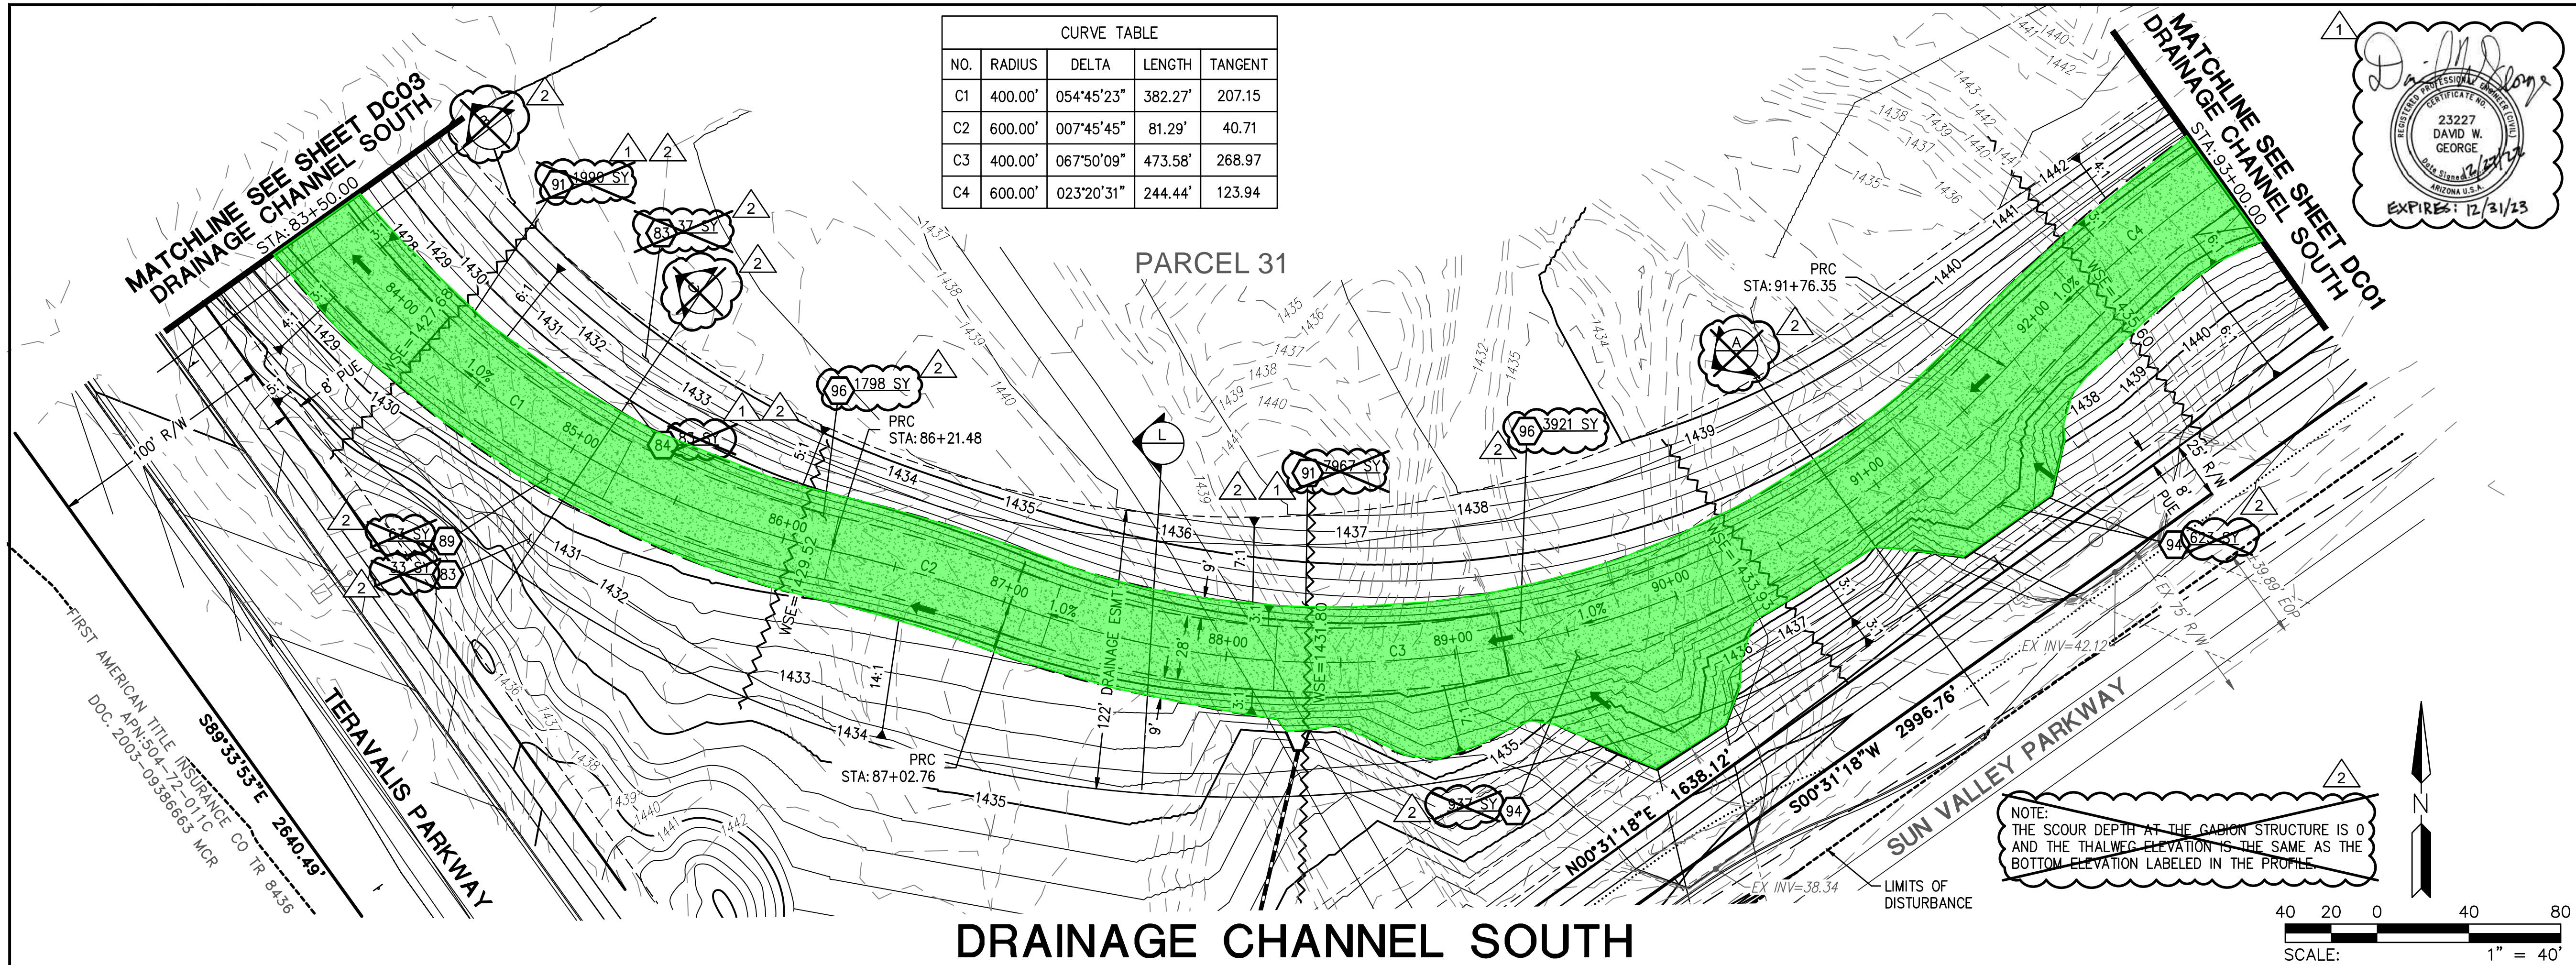


Copyright, Hilgartwilson. This plan document set is the sole property of Hilgartwilson. No alterations to these plans, other than adding "as-built" information, are allowed by anyone other than authorized Hilgartwilson employees.

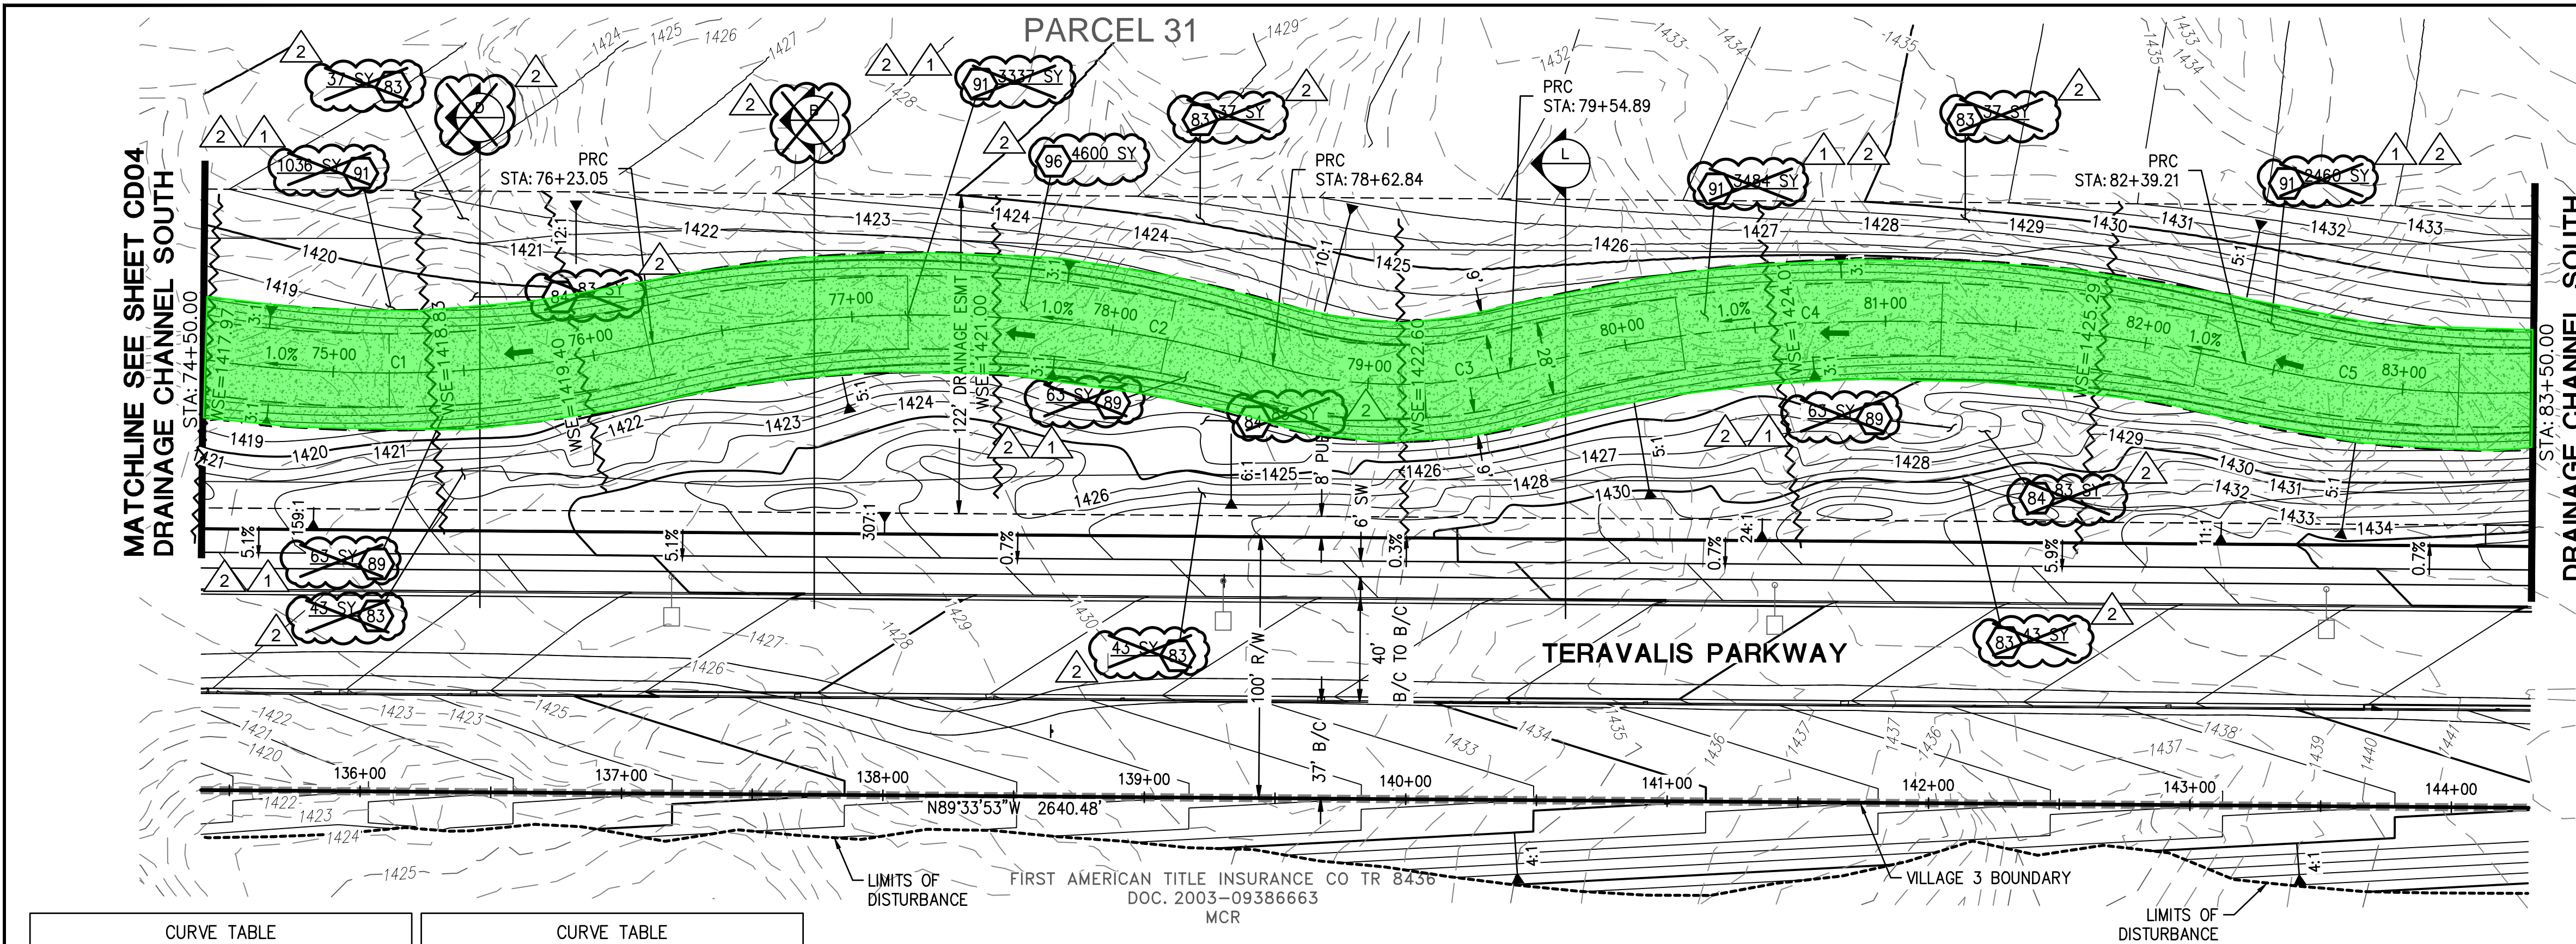

CURVE TABLE					CURVE TABLE				
NO.	RADIUS	DELTA	LENGTH	TANGENT	NO.	RADIUS	DELTA	LENGTH	TANGENT
C1	475.00'	027°32'18"	228.30'	116.40	C4	575.00'	028°19'51"	284.32'	145.13
C2	475.00'	028°55'25"	239.79'	122.51	C5	400.00'	054°45'23"	382.27'	207.15
C3	170.01'	031°01'21"	92.05'	47.18					

DRAINAGE CHANNEL SOUTH

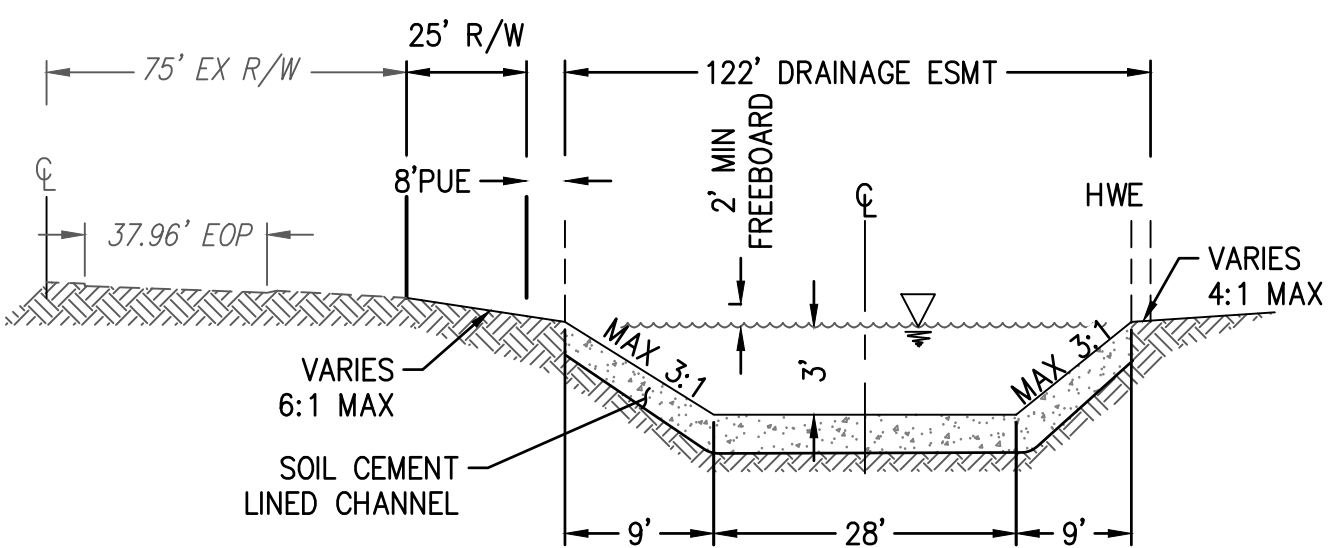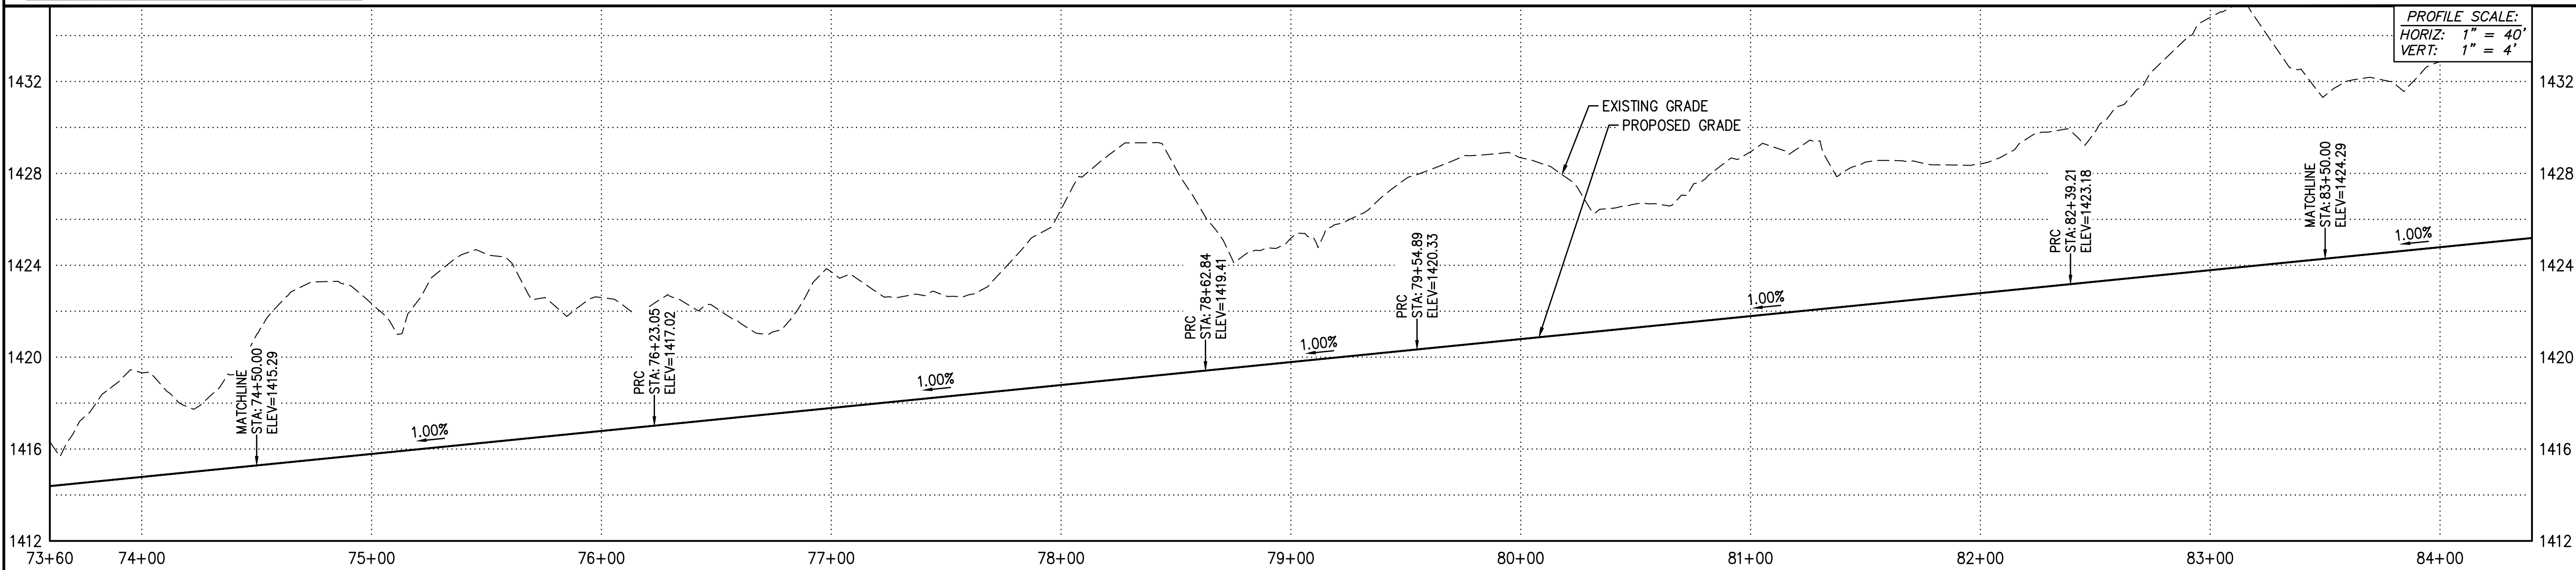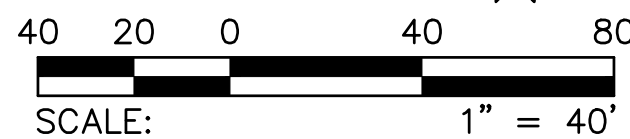

TYPICAL DRAINAGE SECTION - SUN VALLEY PARKWAY

NTS

CHANNEL ALIGNMENT AND CHANNEL SECTION WIDTH CHANGED. SECTION B & C HAVE BEEN DELETED. GRADING AND WSE WERE REVISED. SOIL CEMENT AND GROUTED RIPRAP ADDED. DROP STRUCTURES WERE REMOVED.

LEGEND

- VILLAGE 3 BOUNDARY
- EROSION HAZARD SETBACK
- RIGHT OF WAY
- LOT LINE
- CENTER LINE
- EASEMENT LINE
- FLOW DIRECTIONAL INDICATOR
- FINISH PAD ELEVATION (FINISH FLOOR IS 1' ABOVE FP)
- EMERGENCY OUTFALL ARROW
- HIGH POINT
- LOW POINT
- DUAL CHAMBER DRYWELL



STORM DRAIN CONSTRUCTION

- 83. INSTALL LOOSE ANGULAR RIP-RAP PER MAG SPEC SEC. 220; D50=6", 12" THICK ON MIRAFI EROSION PROTECTION GEO-TEXTILE OR APPROVED EQUIVALENT. FABRIC TO HAVE APPARENT OPENING SIZE OF 0.425MM, PERMITTIVITY OF 50 GAL/MIN/FT AND WOVEN. SEE SHEET# DC21 FOR DETAIL AND PLAN SHEET FOR QUANTITY. COLOR PER DEVELOPER. 240 SY
- 84. INSTALL GABIONS ON MACCAFERRI GEOTEXTILE MACTEX N47.1. PER DETAILS SEE SHEET# DC21. 249 SY
- 89. INSTALL 2" OF SHOTCRETE ON TOP OF GABION BASKET WITH D50=6" EMBEDDED IN SHOTCRETE. 189 SY
- 91. INSTALL ANGULAR LOOSE RIP-RAP PER MAG SPEC SECTION 220 D50=4" 6" THICK ON MIRAFI EROSION PROTECTION GEO-TEXTILE OR APPROVED EQUIVALENT. FABRIC TO HAVE APPARENT OPENING SIZE OF 0.425MM, PERMITTIVITY OF 50 gal/min/ft AND WOVEN. SPECIFIC WEIGHT = 165 lb/H3. GRADATION PER TABLE 6.4 OF 2013 DRAINAGE DESIGN MANUAL FOR MARICOPA COUNTY, ARIZONA (HYDRAULICS). 10317 SY
- 96. INSTALL SOIL CEMENT PER MAG SPEC 311; SEE DETAIL 1 ON SHEET DC21. 4600 SY

NOTE:

THE SCOUR DEPTH AT THE GABION STRUCTURE IS 0 AND THE THALWEG ELEVATION IS THE SAME AS THE BOTTOM ELEVATION LABELED IN THE PROFILE.

KEY MAP

REVISIONS:

- 12/27/2022 - ROSEWOOD AVENUE WAS EXTENDED AND GRADING REVISED. CHANNEL WAS REVISED ALONG SUN VALLEY PARKWAY TO ACCOMMODATE AN ADDED SIDEWALK. GRADING FOR APS SUBSTATION ADDED & FIRE STATION. THE EROSION HAZARD SETBACK ALONG WAGNER WASH WAS REVISED.
- 8/23/2023 - REVISION TO CHANNEL ALIGNMENT AND REPLACE RIPRAP WITH SOIL CEMENT.

PLAN NAME

TRILLIUM VILLAGE 3 - UNITS 1 & 2 DRAINAGE CHANNEL PLAN

ENGINEER INFORMATION

HILGARTWILSON	APPROVED
COB PERMITTING APPROVED SEAL	COB ENGINEERING APPROVED SEAL
	6/22/2022
	CITY OF BUCKEYE ENGINEERING

AS-BUILT SEAL

	DESIGN SEAL
	23227 DAVID W. GEORGE
	EXP 12/31/23

ORIGINAL PLAN DATE

MAY 2022

LATEST REVISION DATE

AUG 2023

PROJECT NUMBER

1175

SHEET NUMBER

DC03

SHT.

72 OF 90



COB PLAN TRACKING #

ENG-21-0220



COB PERMIT #

3R Submittal

Copyright, Hilgartwilson
This plan document set is the sole property of Hilgartwilson. No alterations to these plans, other than adding "as-built" information, are allowed by anyone other than authorized Hilgartwilson employees.

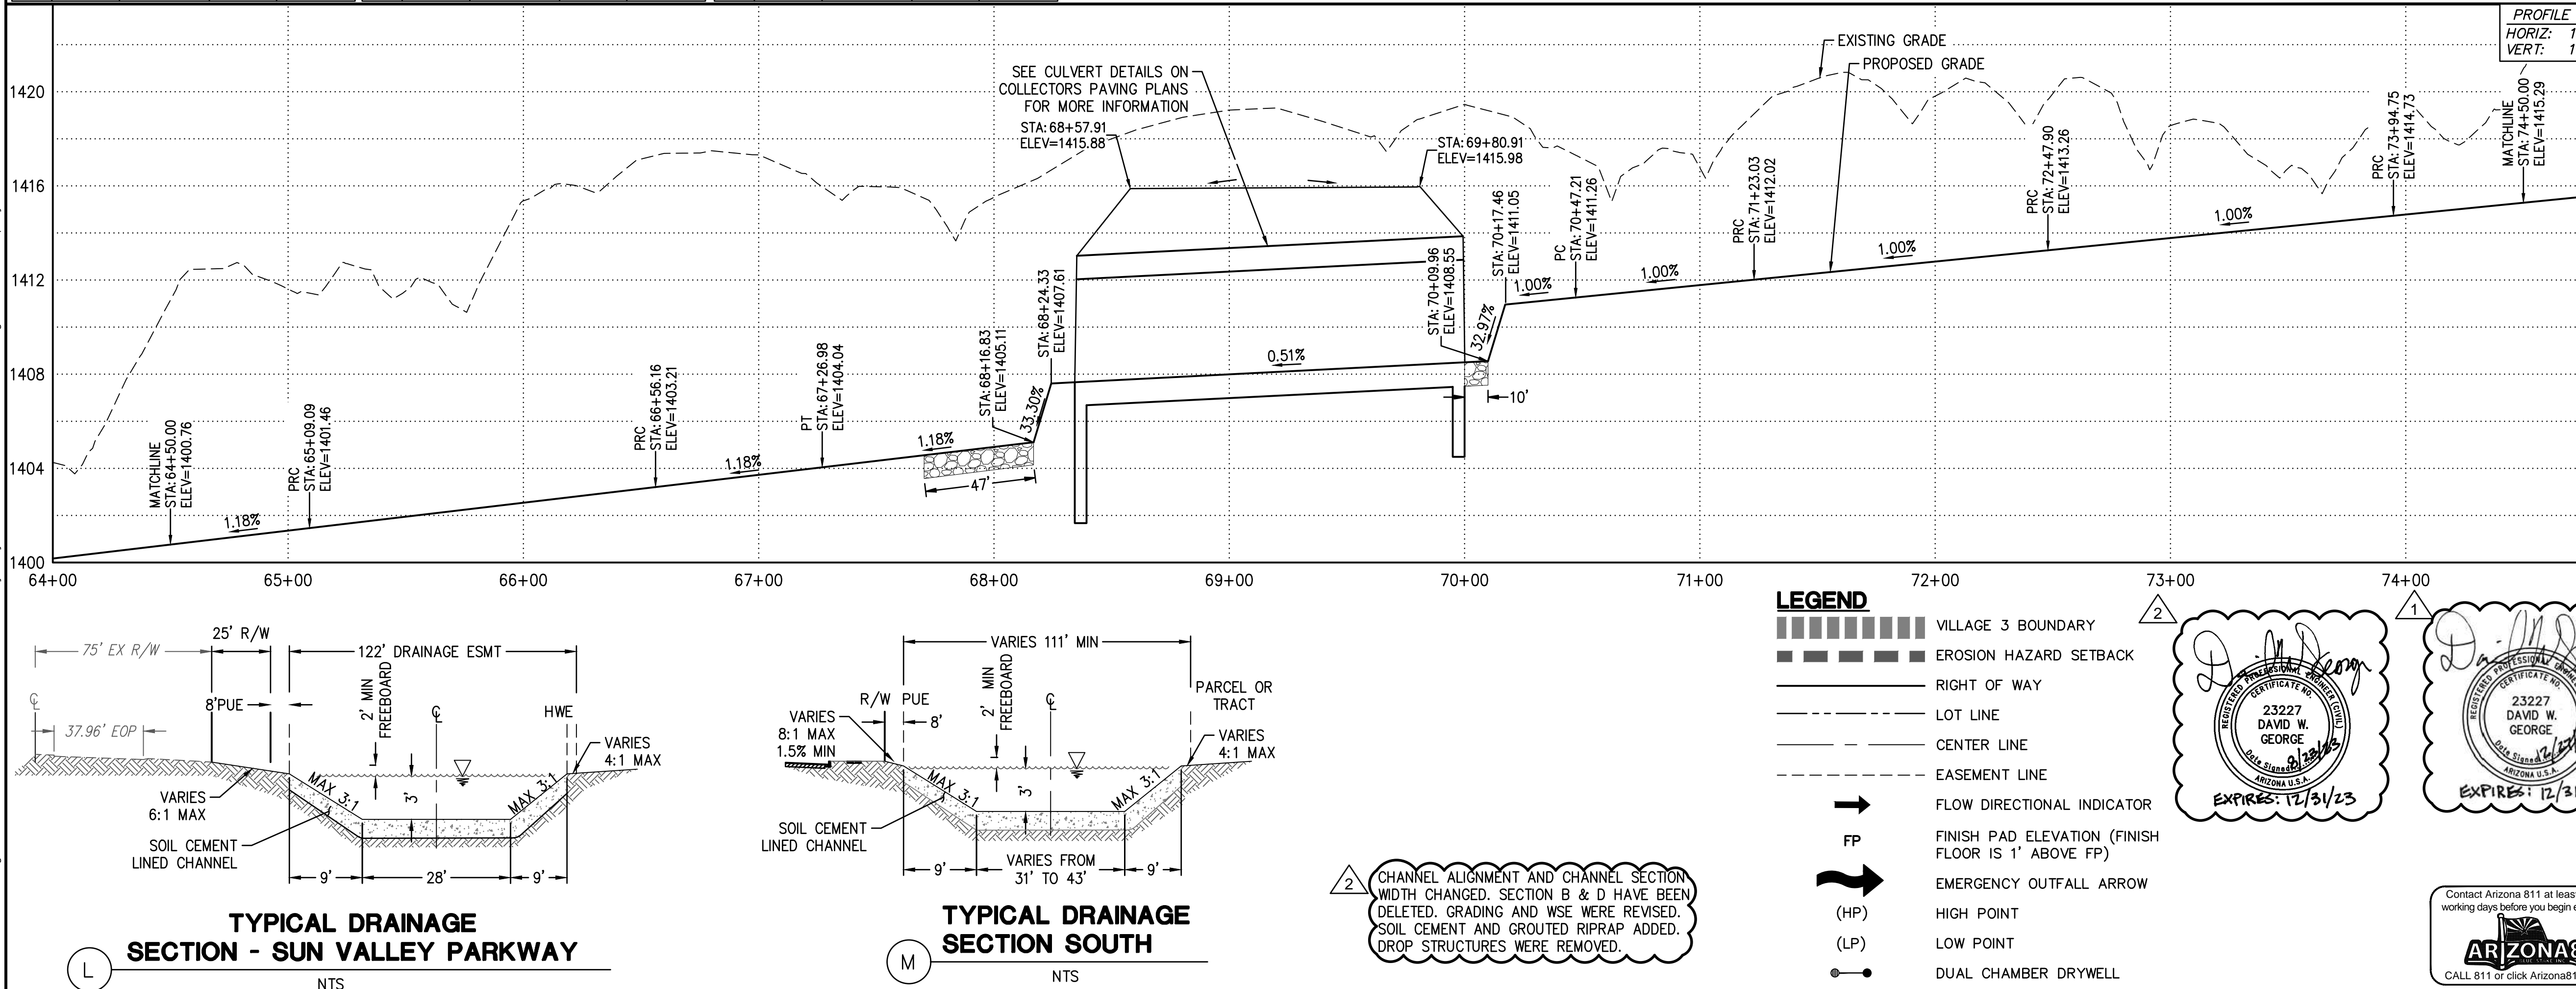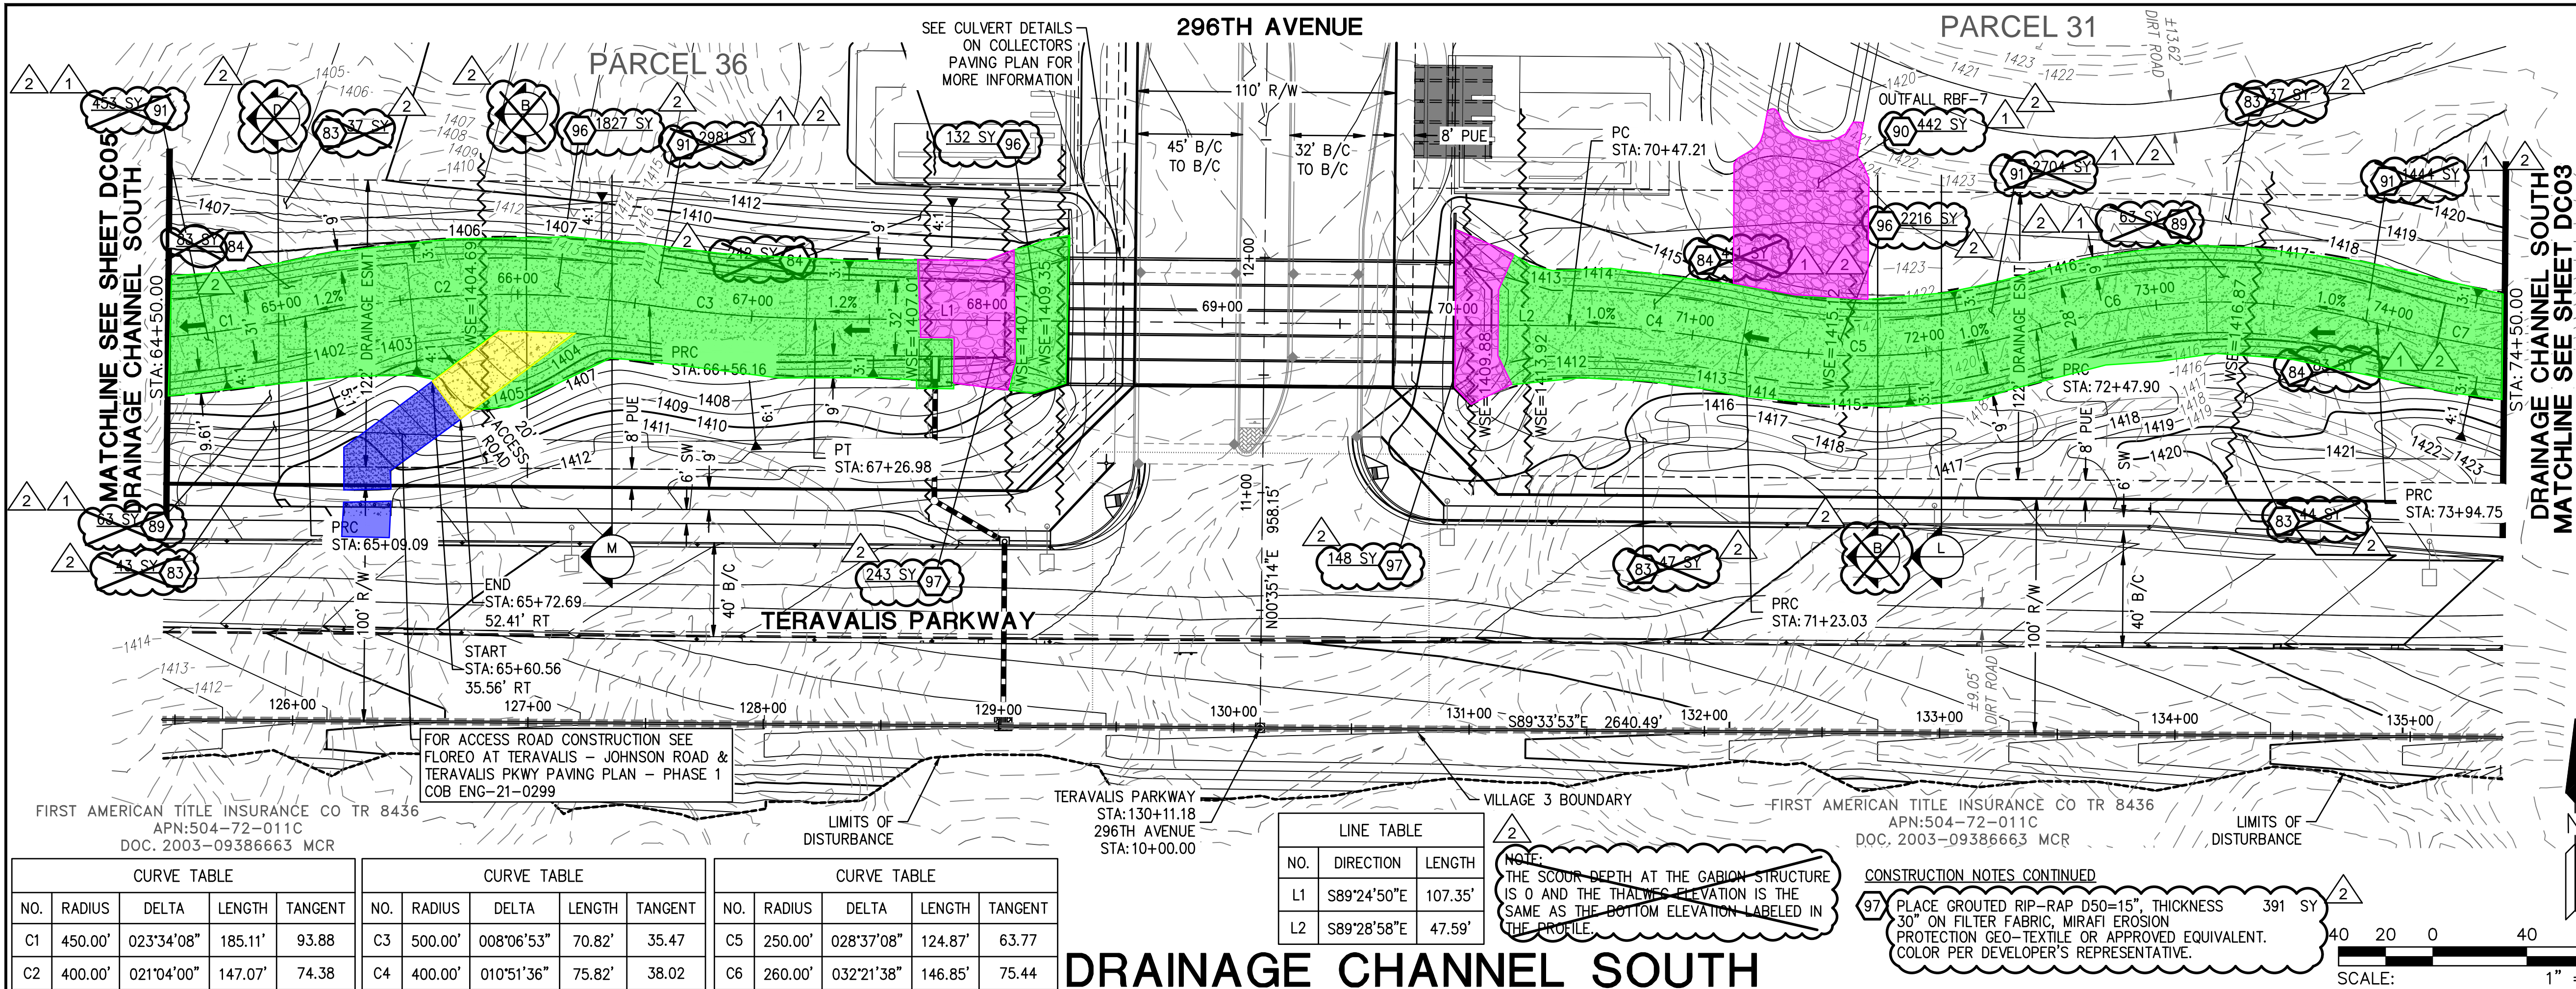

- This plan document set is the sole property of HilgartWilson. No alterations to these plans, Copyright, HilgartWilson or other than adding "as-built" information, are allowed by anyone other than authorized HilgartWilson employees.

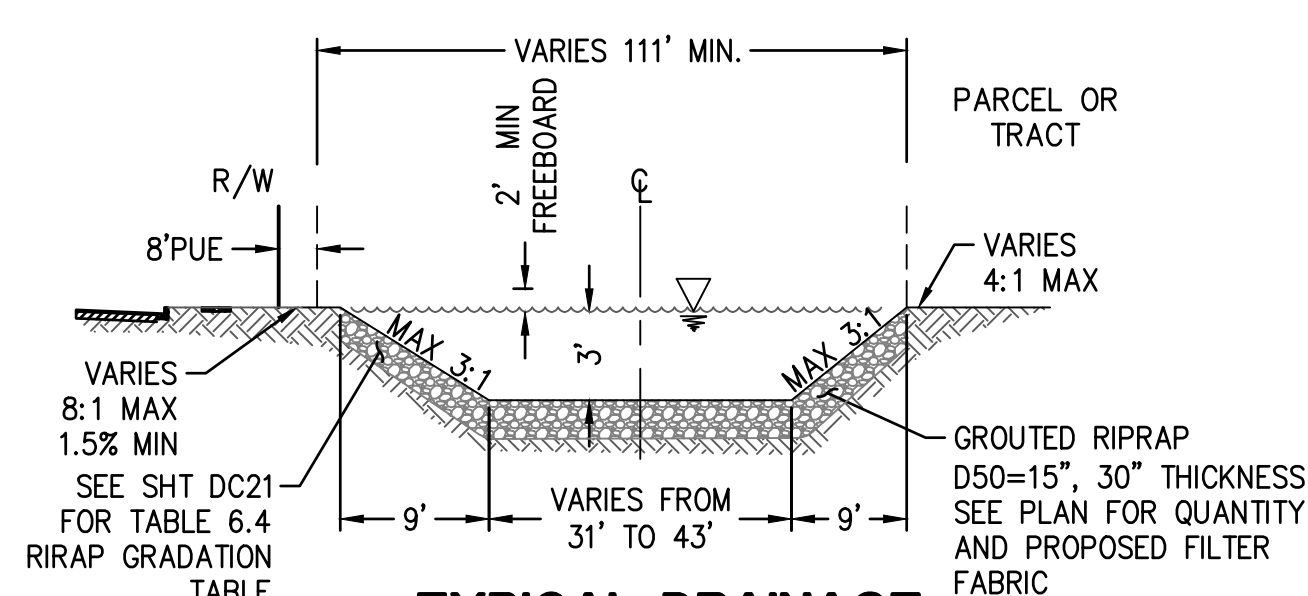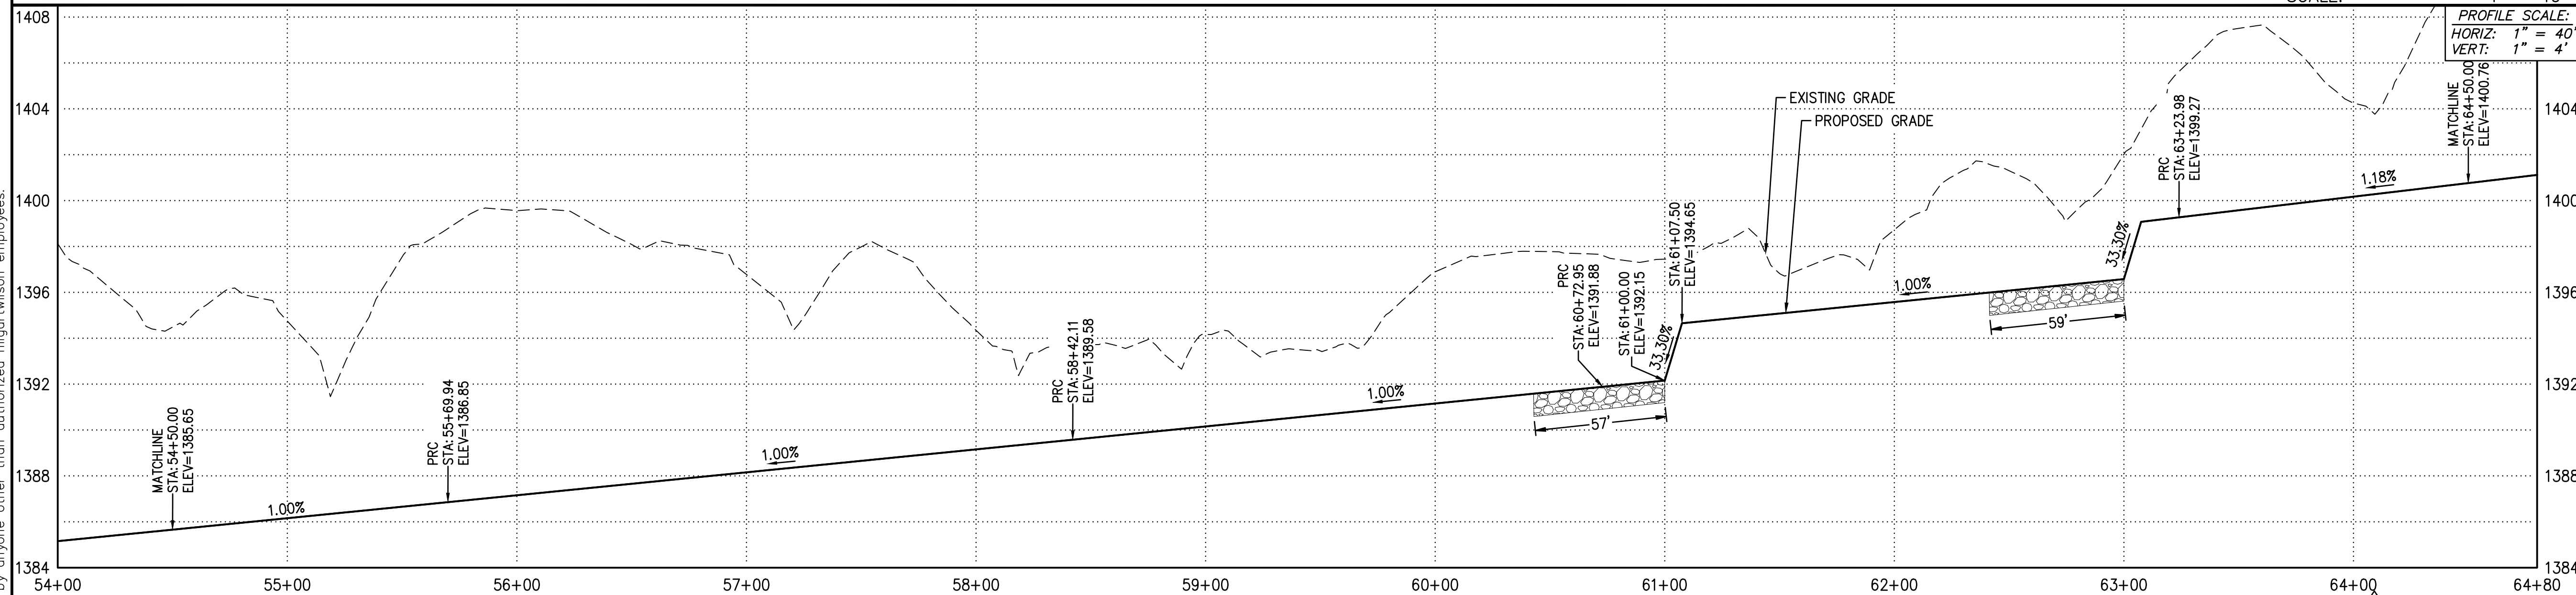


TYPICAL DRAINAGE SECTION SOUTH

CHANNEL ALIGNMENT AND CHANNEL SECTION WIDTH CHANGED. SECTION B, D & E HAVE BEEN DELETED. GRADING AND WSE WERE REVISED. SOIL CEMENT AND GROUTED RIPRAP ADDED. DROP STRUCTURES WERE REMOVED.

97 PLACE GROUTED RIP-RAP D50=15", THICKNESS 630 SY
30" ON FILTER FABRIC, MIRAFI EROSION
PROTECTION GEO-TEXTILE OR APPROVED EQUIVALENT.
COLOR PER DEVELOPER'S REPRESENTATIVE.

* CONSTRUCTION NOTES CONTINUED (ON THE LEFT)



	12/27/2022 – ROSEWOOD AVENUE WAS EXTENDED AND GRADING REVISED. CHANNEL WAS REVISED ALONG SUN VALLEY PARKWAY TO ACCOMMODATE AN ADDED SIDEWALK. GRADING FOR APS SUBSTATION ADDED & FIRE STATION. THE EROSION HAZARD SETBACK ALONG WAGNER WASH WAS REVISED.

8/23/2023 = REVISION TO CHANNEL ALIGNMENT AND
REPLACE RIPRAP WITH SOIL CEMENT.

PLAN NAME	
-----------	--

**TRILLIUM
VILLAGE 3 - UNITS 1 & 2
DRAINAGE CHANNEL PLAN**

ENGINEER INFORMATION



COB PERMITTING
APPROVED SEAL

COB ENGINEERING
APPROVED SEAL


APPROVED

6/22/2022

Y OF BUCKE ENGINEERING

AS-BUILT SEAL

DESIGN SEAL

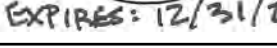

ORIGINAL PLAN DATE

LATEST REVISION DATA

MAY 20

AUG 2023

SHEET NUMBER **DC05** SH

3R Subr

--	--	--


[illegible][illegible]

PACKING #
-21-0220

ENG


Contact Arizona 811 at least two full working days before you begin excavation.

ARIZONA 811
CALL 811 or click ARIZONA811.COM

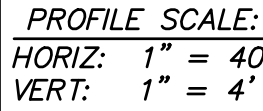

2 CHANNEL ALIGNMENT AND CHANNEL SECTION WIDTH CHANGED. SECTION E & F HAVE BEEN DELETED. GRADING AND WSE WERE REVISED. SOIL CEMENT AND GROUTED RIPRAP ADDED. DROP STRUCTURES WERE REMOVED.

	VILLAGE 3 BOUNDARY
	EROSION HAZARD SETBACK
	RIGHT OF WAY
	LOT LINE
	CENTER LINE
	EASEMENT LINE
	FLOW DIRECTIONAL INDICATOR
	FINISH PAD ELEVATION (FINISH FLOOR IS 1' ABOVE FP)
	EMERGENCY OUTFALL ARROW
	HIGH POINT
	LOW POINT
	DUAL CHAMBER DRYWELL

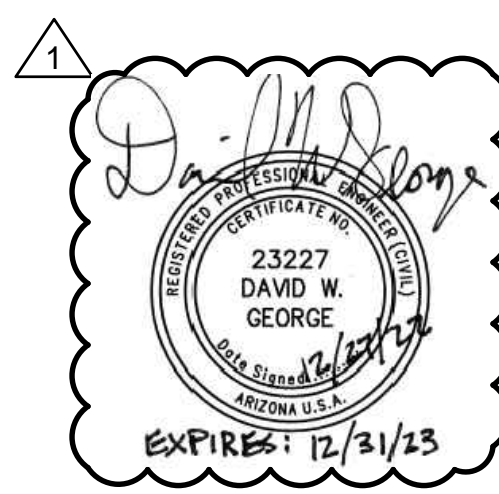

83	INSTALL LOOSE ANGULAR RIP--RAP PER MAG SPEC SECTION 220; D50=6" THICK ON MIRAFI EROSION PROTECTION GEO--TEXTILE OR APPROVED EQUIVALENT. FABRIC TO HAVE APPARENT OPENING SIZE OF 0.425MM, PERMITTIVITY OF 50 GAL/MIN/FT AND WOVEN. SEE SHEET# DC21 FOR DETAIL AND PLAN SHEET FOR QUANTITY. COLOR DEVELOPER.	320 SY
84	INSTALL GABIONS ON MACCAFERRI GEO TEXTILE MACTEX N47.1. PER DETAILS SEE SHEET# DC21.	332 SY
89	INSTALL 2" OF SHOTCRETE ON TOP OF GABION BASKET WITH D50=6" EMBEDDED IN SHOTCRETE.	252 SY
91	INSTALL ANGULAR LOOSE RIP--RAP PER MAG SPEC SECTION 220; D50=4" 6" THICK ON MIRAFI EROSION PROTECTION GEO--TEXTILE OR APPROVED EQUIVALENT. FABRIC TO HAVE APPARENT OPENING SIZE OF 0.425MM, PERMITTIVITY OF 50 gal./min/ft. AND WOVEN. SPECIFIC WEIGHT = 165 lb./ft ³ . GRADATION PER TABLE 6.4 OF 2013 DRAINAGE DESIGN MANUAL FOR MICOPCA (COUNTY, ARIZONA (HYDRAULICS)).	11768 SY
96	INSTALL SOIL CEMENT PER MAG SPEC 311; SEE DETAIL 1 ON SHEET DC21.	4840 SY
97	PLACE GROUTED RIP--RAP D50=15", THICKNESS 30" ON FILTER FABRIC, MIRAFI EROSION PROTECTION GEO--TEXTILE OR APPROVED EQUIVALENT. COLOR PER DEVELOPER'S REPRESENTATIVE.	268 SY



1	12/27/2022 – ROSEWOOD AVENUE WAS EXTENDED AND GRADING REVISED. CHANNEL WAS REVISED ALONG SUN VALLEY PARKWAY TO ACCOMMODATE AN ADDED SIDEWALK. GRADING FOR APS SUBSTATION ADDED & FIRE STATION. THE EROSION HAZARD SETBACK ALONG WAGNER WASH WAS REVISED.
2	8/23/2023 – REVISION TO CHANNEL ALIGNMENT AND REPLACE RIPRAP WITH SOIL CEMENT.

**TRILLIUM
VILLAGE 3 - UNITS 1 & 2
DRAINAGE CHANNEL PLAN**

“ ”



HILGARTWILER

	APPROVED	TTT	5
--	----------	-----	---

	6/22/2022	15
--	-----------	----

--	--	--	--	--

AS-BUILT SEAL	DESIGN SEAL	
---------------	-------------	--

	(R) DAVID W. GEORGE	C	B
--	------------------------	---	---

ARIZONA U.S.A. KIN 21-


ORIGINAL PLAN DATE MAY 2000	LATEST REVISION DATE AUG 2003	UT EN MIT
--------------------------------	----------------------------------	-----------------

PROJECT NUMBER	SHEET NUMBER	SHT.	DB	DB
1175	DC07			


11/5 DC07 76 OF 90 0 0

ENGR\VILLAGE 3\MASS GRADING\CHANNEL\1175_DC07.dwg 9/7/2023 9:11 AM

By Others

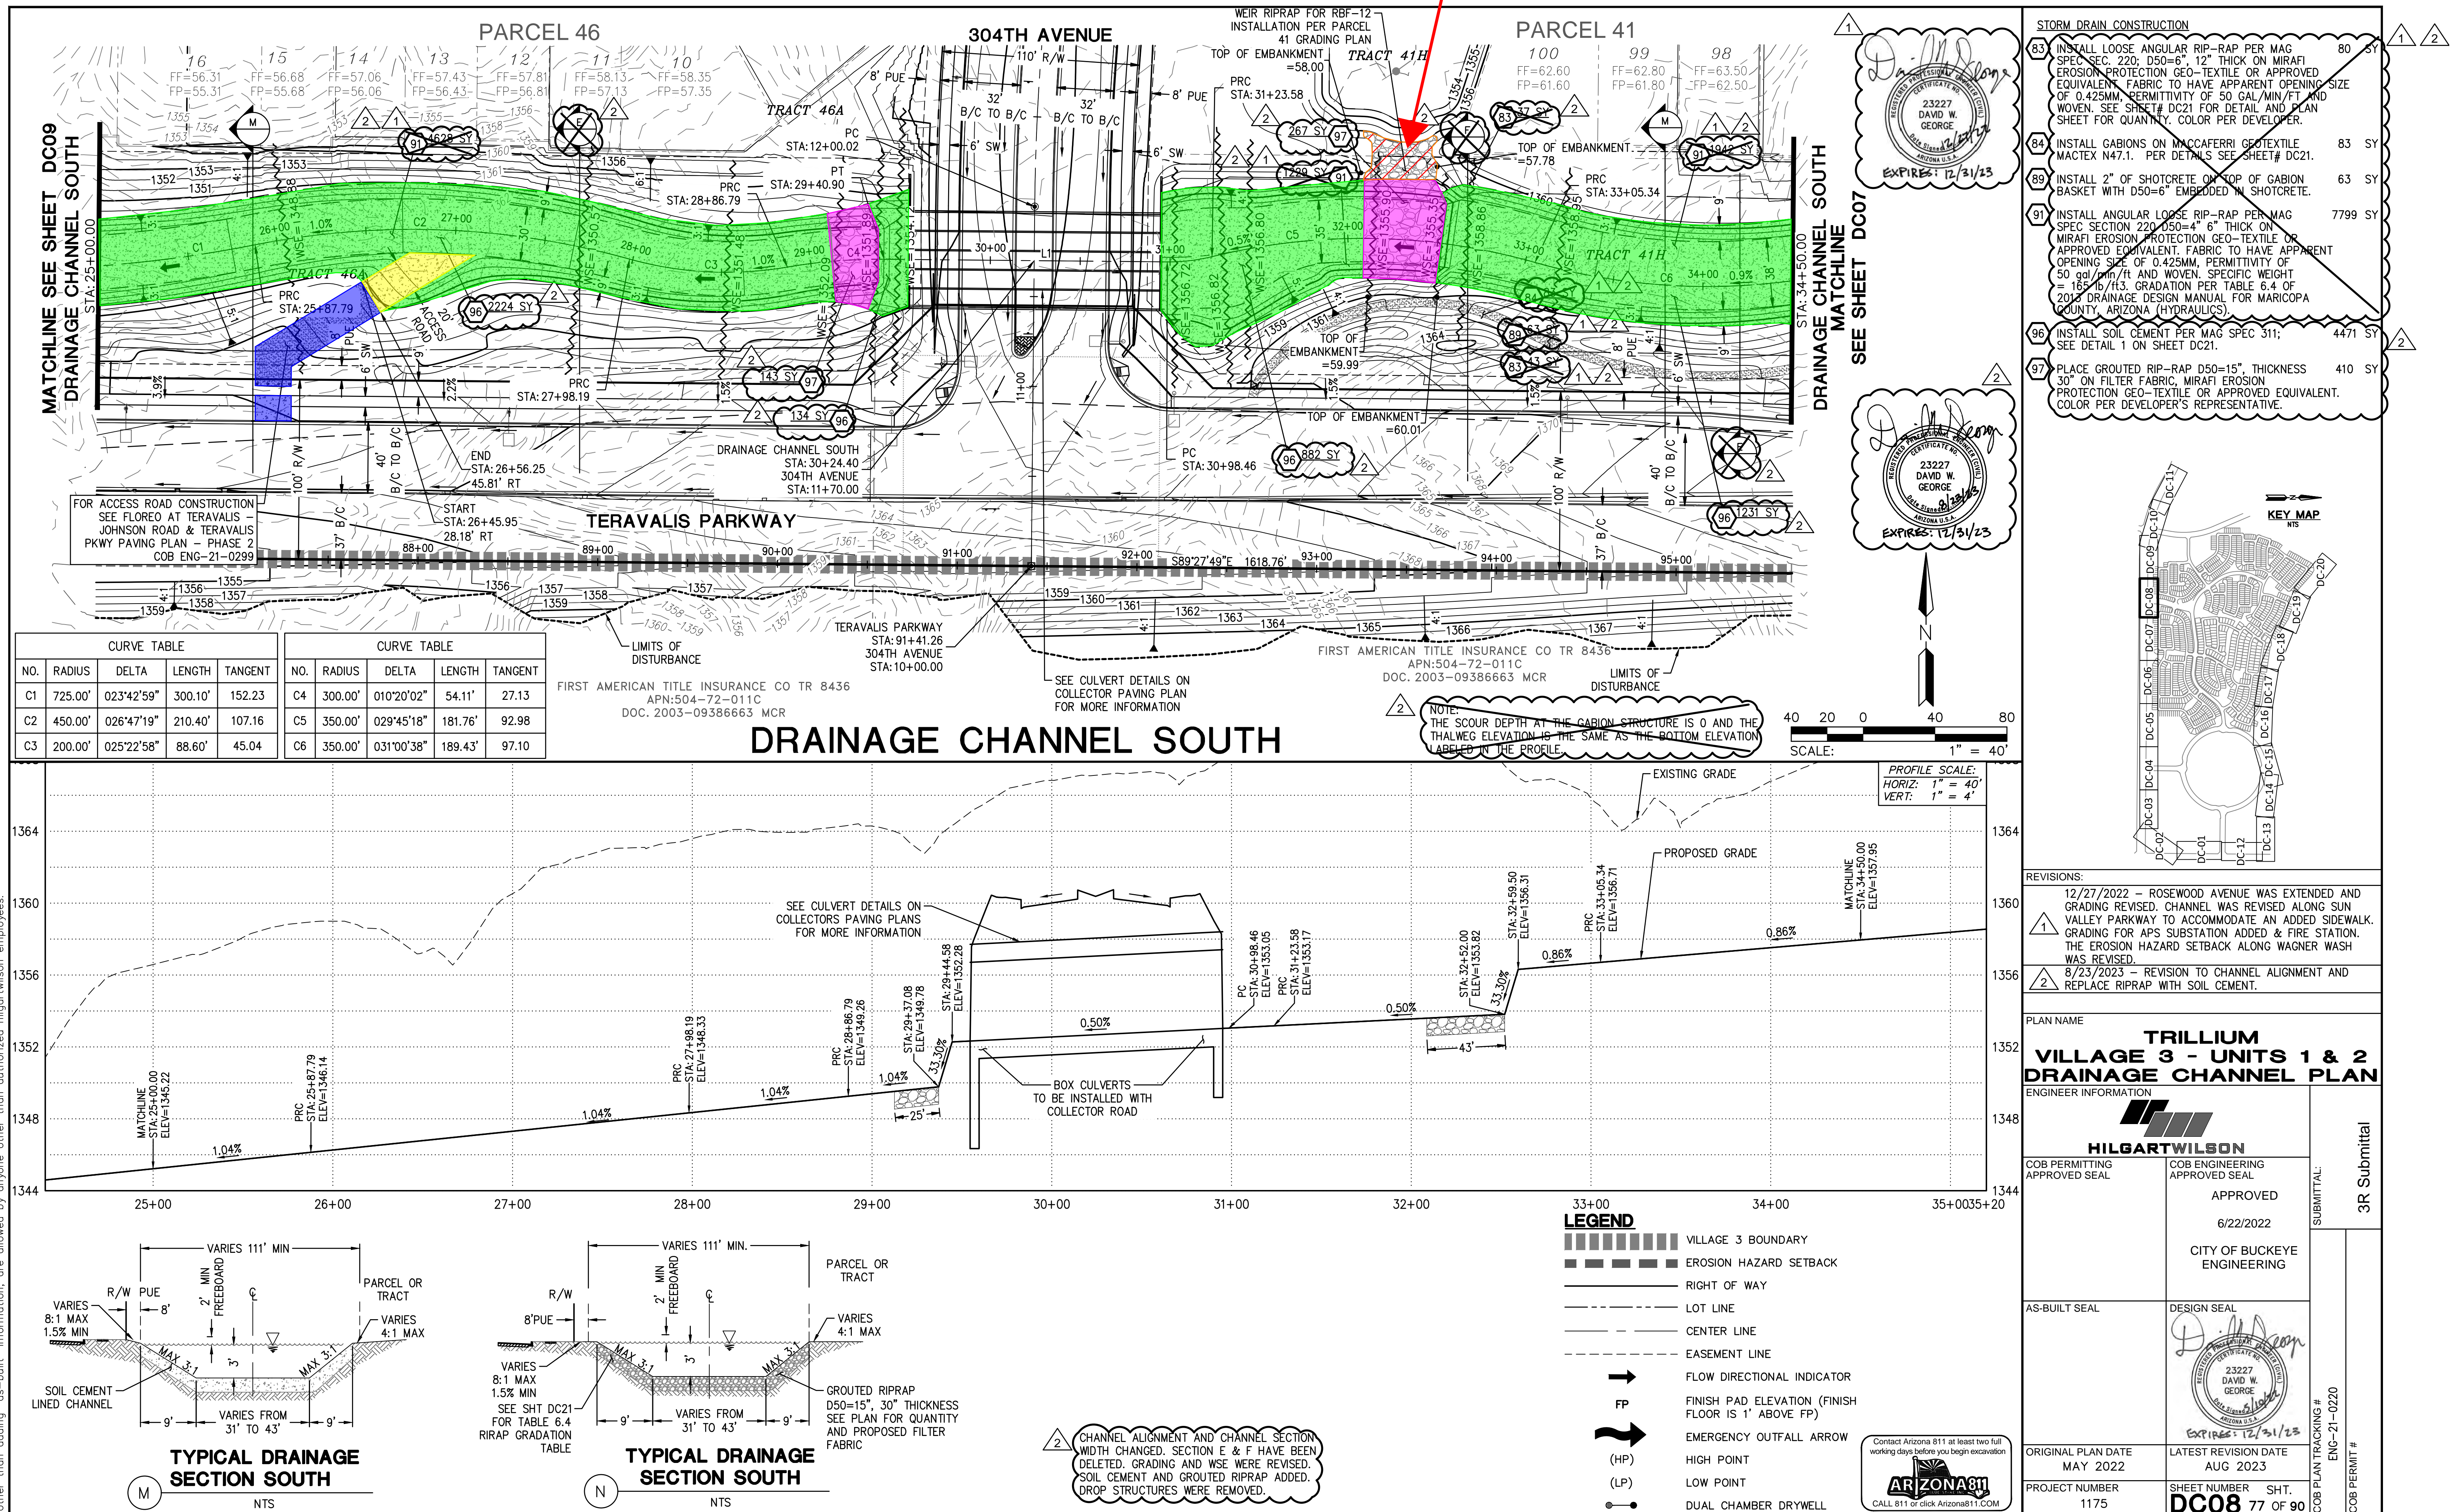



By Others

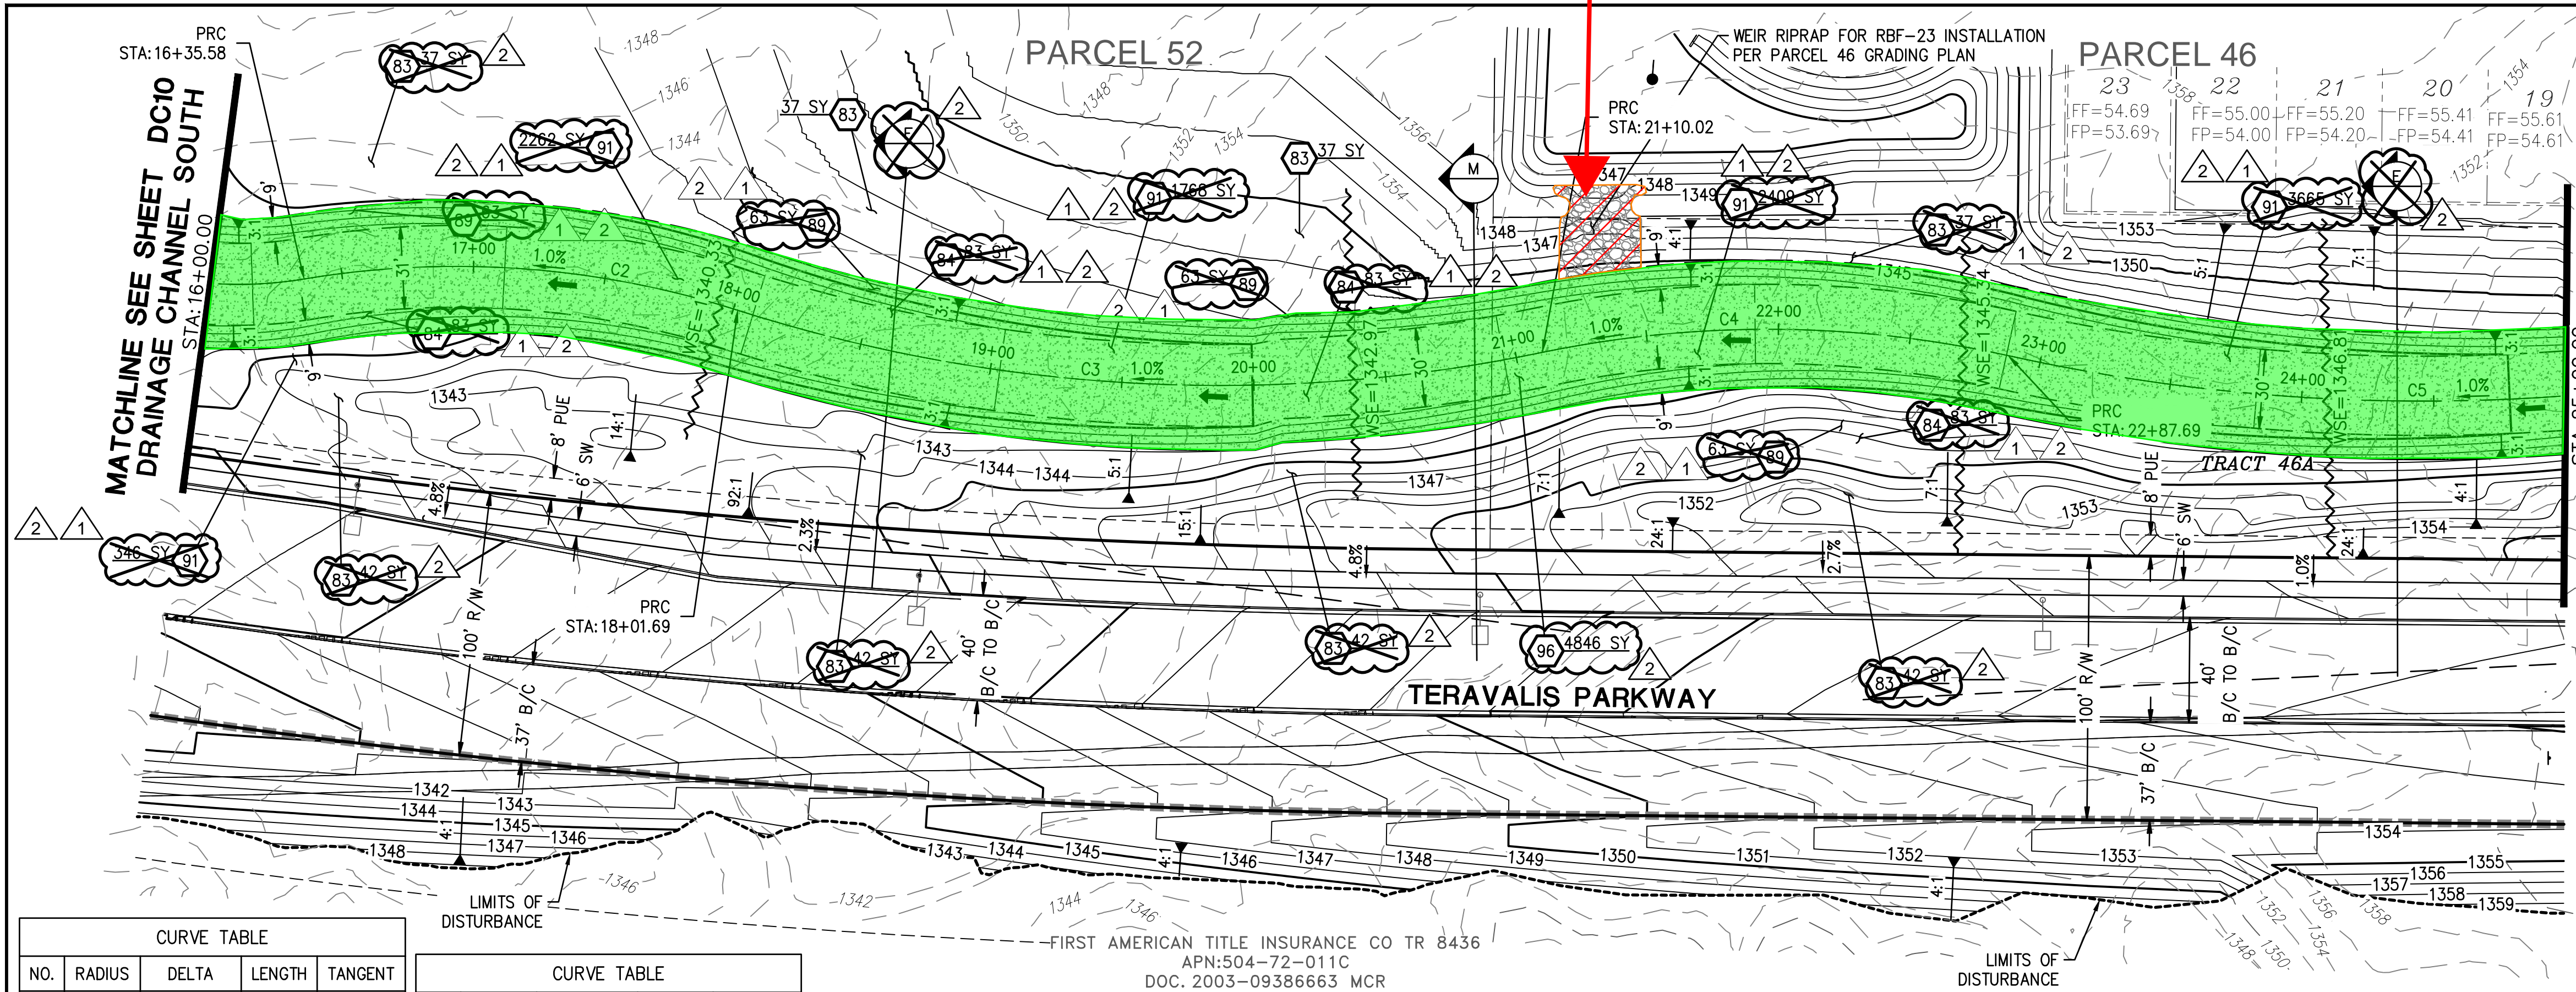

CURVE TABLE				
NO.	RADIUS	DELTA	LENGTH	TANGENT
C2	350.00'	027°11'29"	166.10'	84.65
C3	600.00'	029°26'38"	308.33'	157.65
C4	420.00'	024°14'14"	177.67'	90.18

CURVE TABLE				
NO.	RADIUS	DELTA	LENGTH	TANGENT
C5	725.00'	023°42'59"	300.10'	152.23

DRAINAGE CHANNEL SOUTH

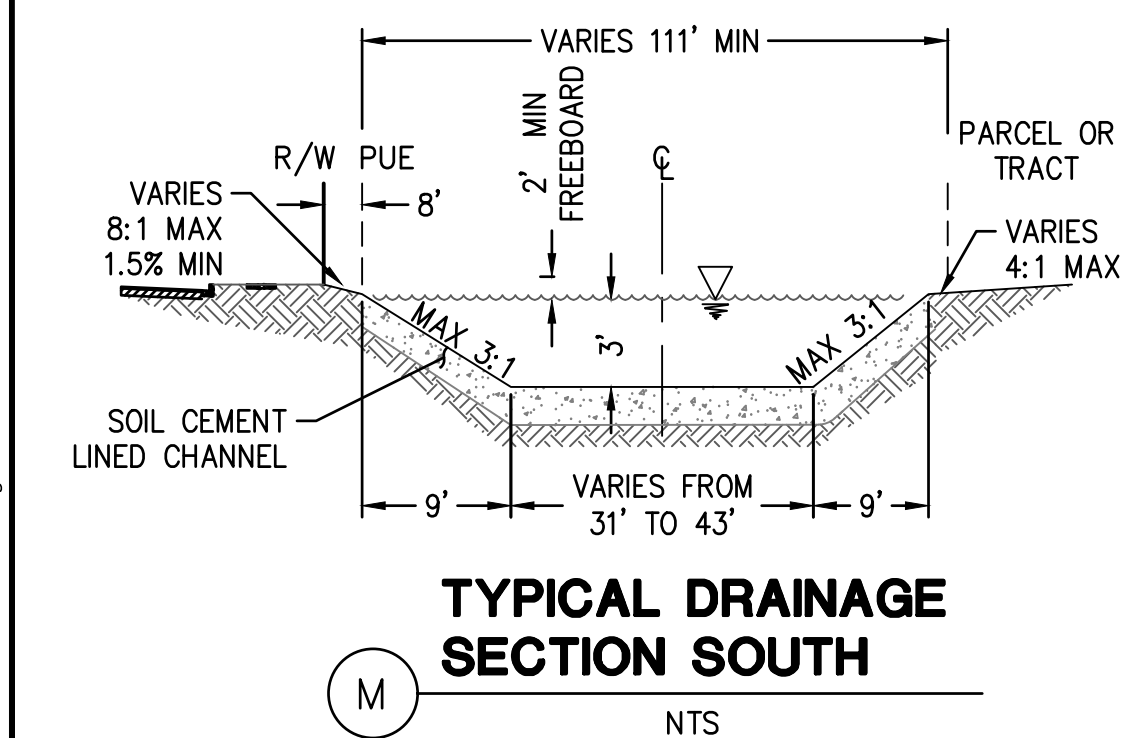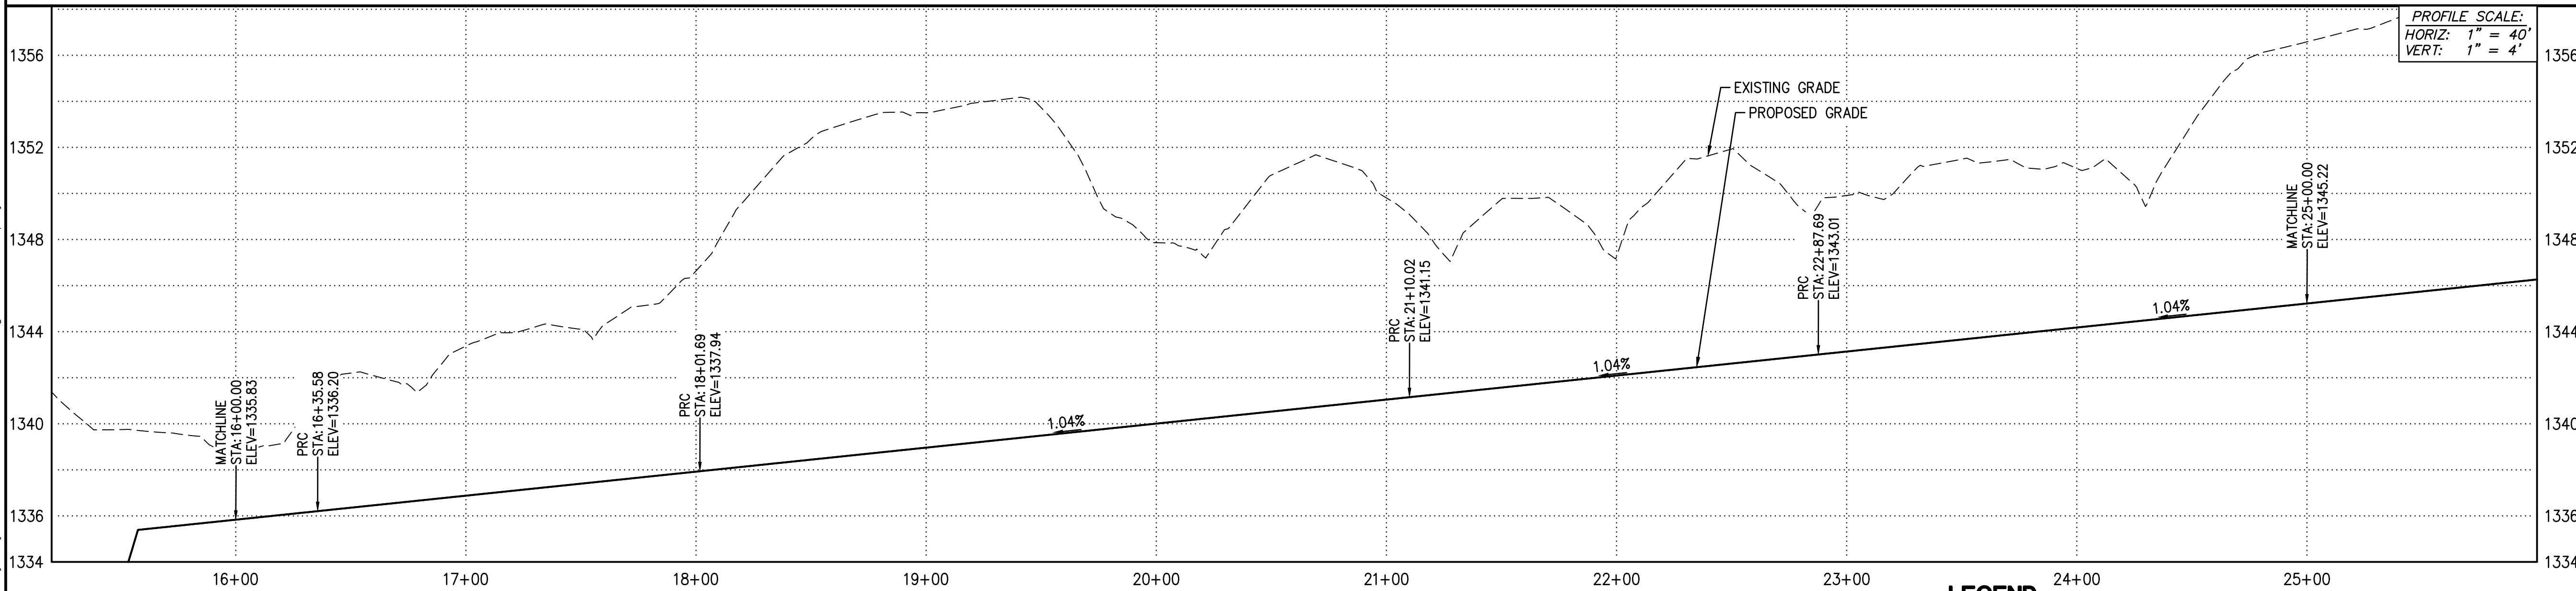


2 CHANNEL ALIGNMENT AND CHANNEL SECTION WIDTH CHANGED. SECTION E & F HAVE BEEN DELETED. GRADING AND WSE WERE REVISED. SOIL CEMENT AND GROUTED RIPRAP ADDED. DROP STRUCTURES WERE REMOVED.

- LEGEND**
- VILLAGE 3 BOUNDARY
 - EROSION HAZARD SETBACK
 - RIGHT OF WAY
 - LOT LINE
 - CENTER LINE
 - EASEMENT LINE
 - FLOW DIRECTIONAL INDICATOR
 - FINISH PAD ELEVATION (FINISH FLOOR IS 1' ABOVE FP)
 - EMERGENCY OUTFALL ARROW
 - HIGH POINT (HP)
 - LOW POINT (LP)
 - DUAL CHAMBER DRYWELL




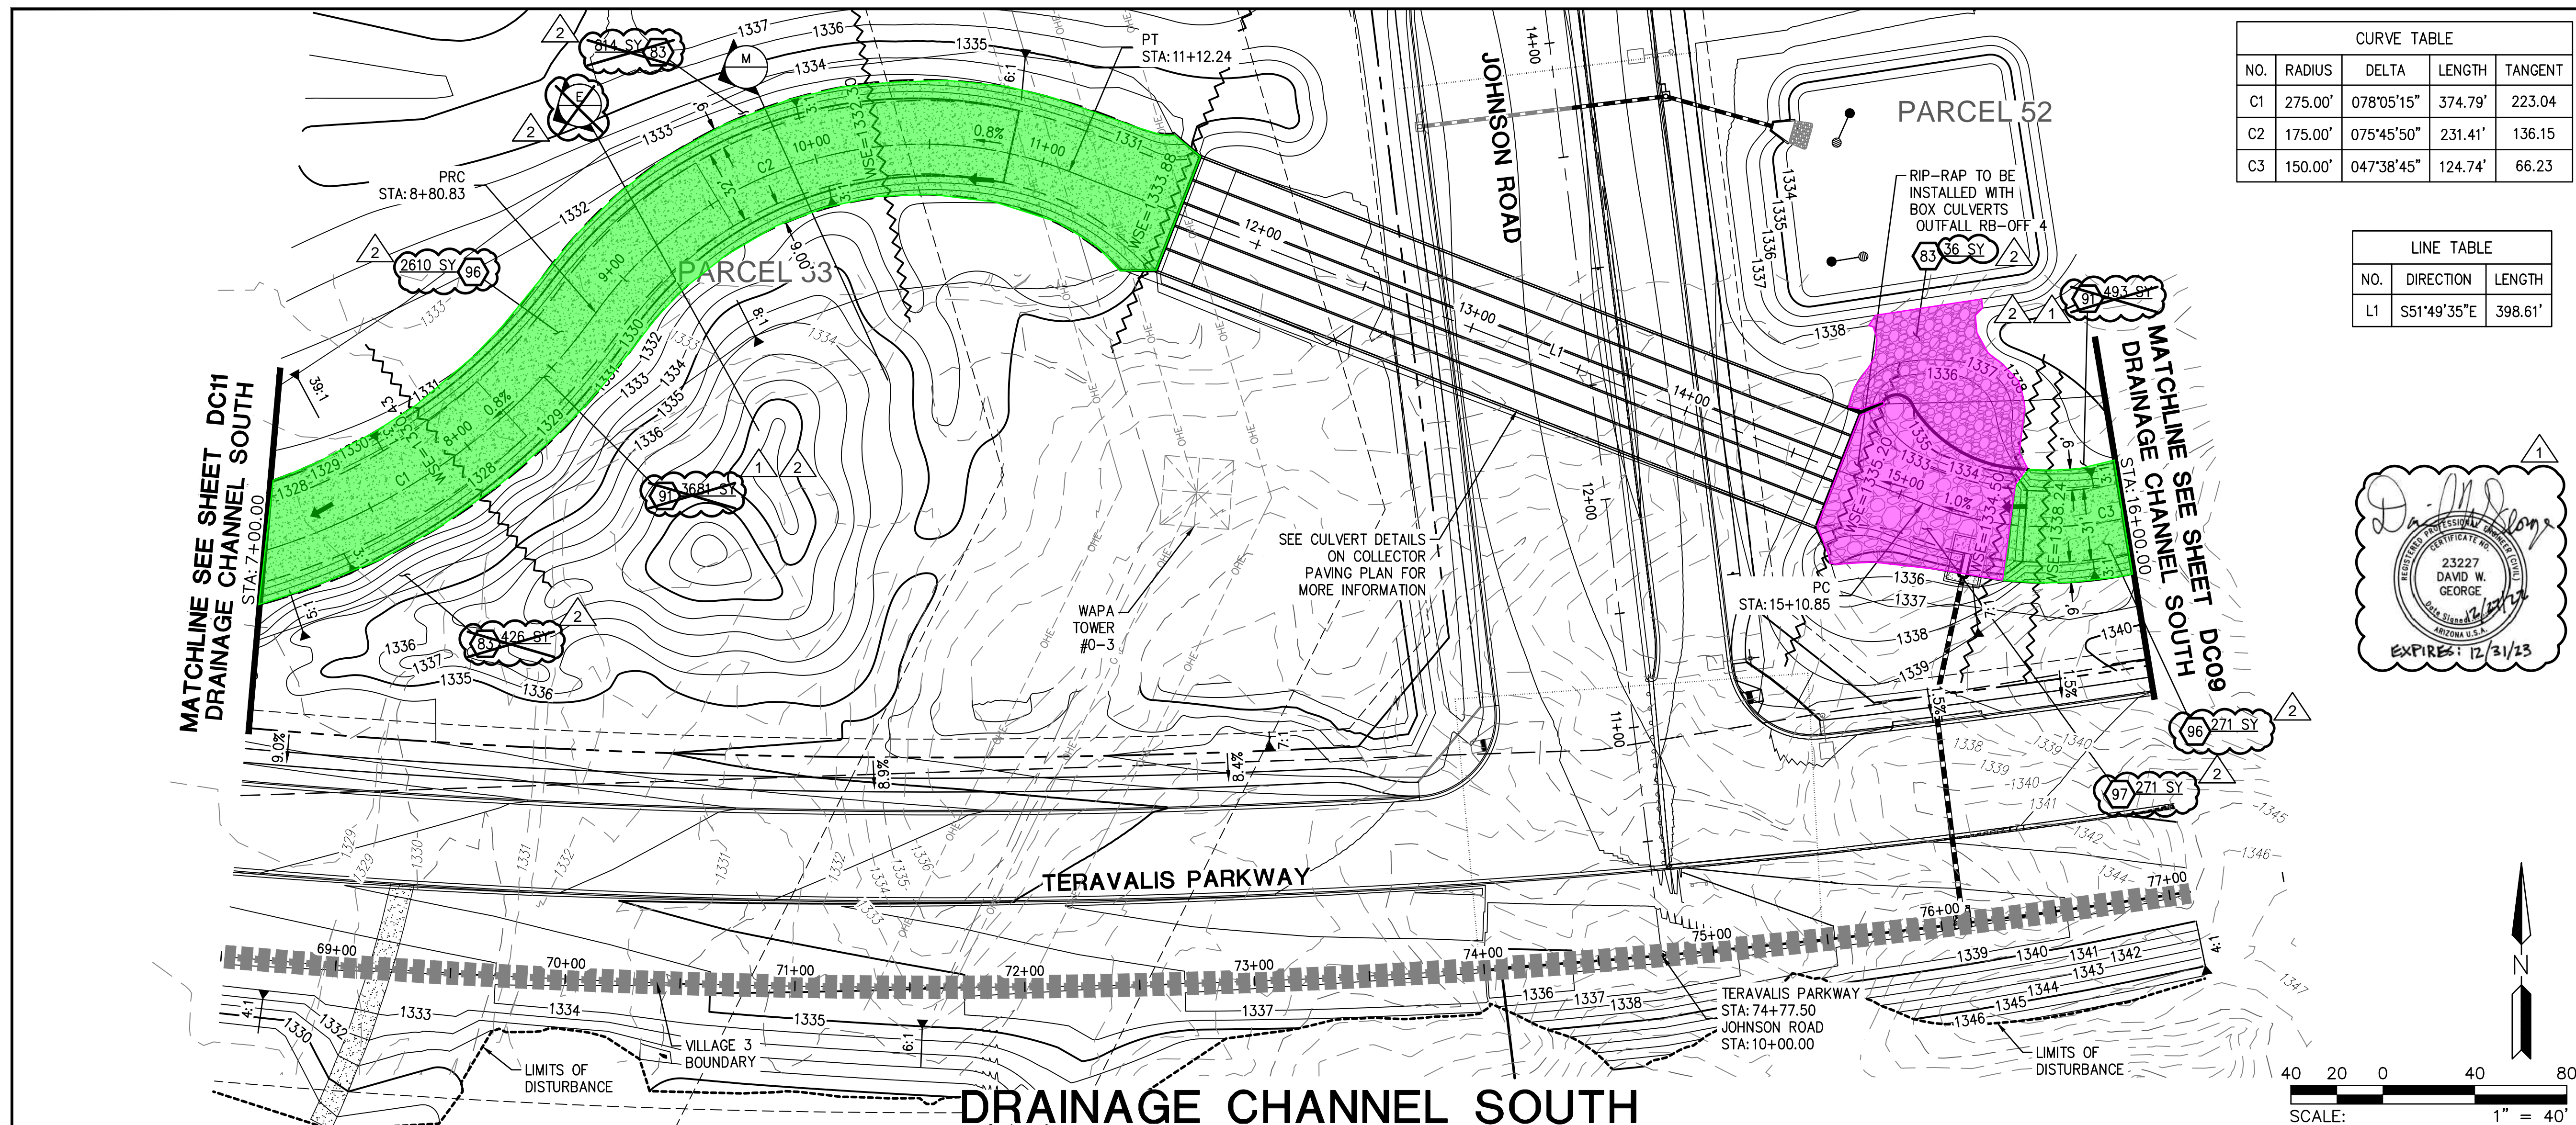
- STORM DRAIN CONSTRUCTION**
- 83 INSTALL LOOSE ANGULAR RIP-RAP PER MAG SPEC SEC. 220; D50=6", 12" THICK ON MIRAFI EROSION PROTECTION GEO-TEXTILE OR APPROVED EQUIVALENT. FABRIC TO HAVE APPARENT OPENING SIZE OF 0.425MM, PERMITTIVITY OF 50 GAL/MIN/FT AND WOVEN. SEE SHEET# DC21 FOR DETAIL AND PLAN SHEET FOR QUANTITY. COLOR PER DEVELOPER. 316 SY
 - 84 INSTALL GABIONS ON MACCAFERRI GEOTEXTILE MACTEX N47.1. PER DETAILS SEE SHEET# DC21. 332 SY
 - 89 INSTALL 2" OF SHOTCRETE ON TOP OF GABION BASKET WITH D50=6" EMBEDDED IN SHOTCRETE. 252 SY
 - 91 INSTALL ANGULAR LOOSE RIP-RAP PER MAG SPEC SECTION 220; D50=4" 6" THICK ON MIRAFI EROSION PROTECTION GEO-TEXTILE OR APPROVED EQUIVALENT. FABRIC TO HAVE APPARENT OPENING SIZE OF 0.425MM, PERMITTIVITY OF 50 gal/min/ft AND WOVEN. SPECIFIC WEIGHT = 165 lb/ft³. GRADATION PER TABLE 6.4 OF 2013 DRAINAGE DESIGN MANUAL FOR MARICOPA COUNTY, ARIZONA (HYDRAULICS). 10450 SY
 - 96 INSTALL SOIL CEMENT PER MAG SPEC 311; SEE DETAIL 1 ON SHEET DC21. 4846 SY

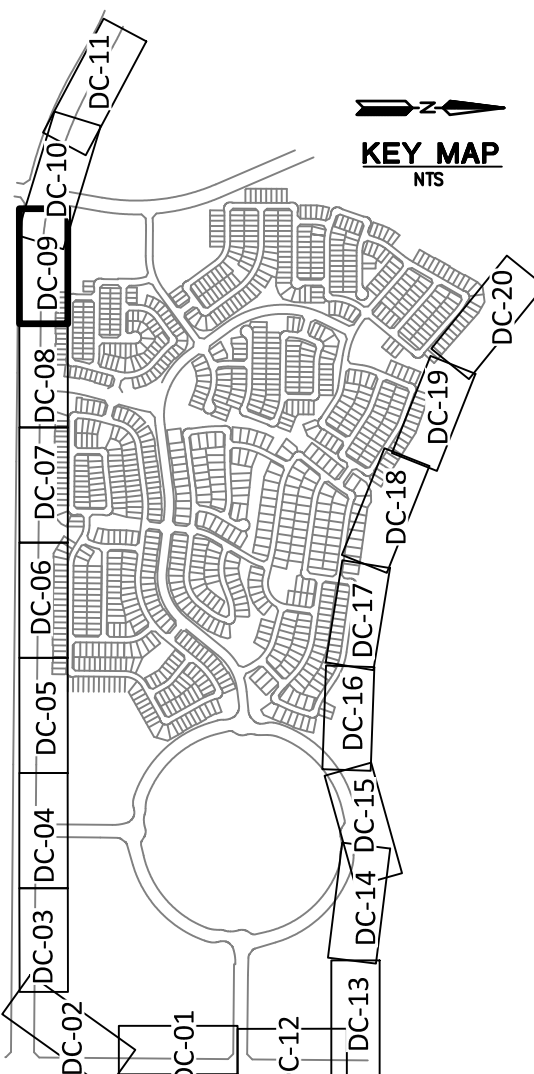

- REVISIONS:**
- 1 12/27/2022 - ROSEWOOD AVENUE WAS EXTENDED AND GRADING REVISED. CHANNEL WAS REVISED ALONG SUN VALLEY PARKWAY TO ACCOMMODATE AN ADDED SIDEWALK. GRADING FOR APS SUBSTATION ADDED & FIRE STATION. THE EROSION HAZARD SETBACK ALONG WAGNER WASH WAS REVISED.
 - 2 8/23/2023 - REVISION TO CHANNEL ALIGNMENT AND REPLACE RIPRAP WITH SOIL CEMENT.



PLAN NAME
TRILLIUM VILLAGE 3 - UNITS 1 & 2 DRAINAGE CHANNEL PLAN

ENGINEER INFORMATION		SUBMITTAL:	3R Submittal
COB PERMITTING APPROVED SEAL	COB ENGINEERING APPROVED SEAL		
	APPROVED 6/22/2022 CITY OF BUCKEYE ENGINEERING		
AS-BUILT SEAL	DESIGN SEAL 		
ORIGINAL PLAN DATE MAY 2022	LATEST REVISION DATE AUG 2023	PLAN TRACKING # ENG-21-0220	
PROJECT NUMBER 1175	SHEET NUMBER DC09	COB PERMIT #	
	SHT. OF 90 78		



CURVE TABLE				
NO.	RADIUS	DELTA	LENGTH	TANGENT
C1	275.00'	078°05'15"	374.79'	223.04
C2	175.00'	075°45'50"	231.41'	136.15
C3	150.00'	047°38'45"	124.74'	66.23

LINE TABLE		
NO.	DIRECTION	LENGTH
L1	S51°49'35"E	398.61'

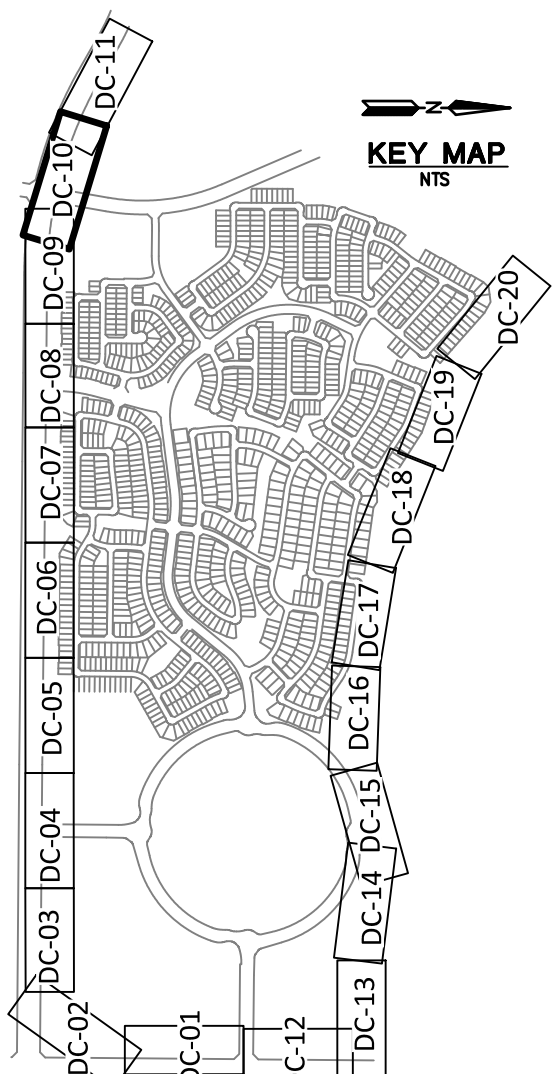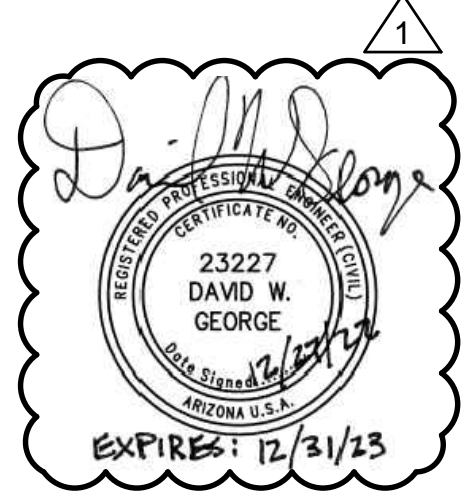

STORM DRAIN CONSTRUCTION

- | | | |
|----|---|---------|
| 83 | INSTALL LOOSE ANGLULAR RIP-RAP PER MAG SPEC SEC. 220; D50=6", 12" THICK ON MIRAFI EROSION PROTECTION GEO-TEXTILE OR APPROVED EQUIVALENT. FABRIC TO HAVE APPARENT OPENING SIZE OF 0.425MM, PERMITTIVITY OF 50 GAL/MIN/FT AND WOVEN. SEE SHEET # DC21 FOR DETAIL AND PLAN SHEET FOR QUANTITY, COLOR PER DEVELOPER. | 368 SY |
| 91 | INSTALL ANGLULAR LOOSE RIP-RAP PER MAG SPEC SECTION 220 D50=4" 6" THICK ON MIRAFI EROSION PROTECTION GEO-TEXTILE OR APPROVED EQUIVALENT. FABRIC TO HAVE APPARENT OPENING SIZE OF 0.425MM, PERMITTIVITY OF 50 gal/min/ft and MIN. SPECIFIC WEIGHT = 165 lb/ft ³ GRADATION PER TABLE 6.4 OF 2013 DRAINAGE DESIGN MANUAL FOR MARICOPA COUNTY, ARIZONA (HYDRAULICS). | 4174 SY |
| 96 | INSTALL SOIL CEMENT PER MAG SPEC 311; SEE DETAIL 1 ON SHEET DC21. | 2881 SY |
| 97 | PLACE GROUTED RIP-RAP D50=15", THICKNESS 30" ON FILTER FABRIC, MIRAFI EROSION PROTECTION GEO-TEXTILE OR APPROVED EQUIVALENT. COLOR PER DEVELOPER'S REPRESENTATIVE. | 271 SY |

REVISIONS:

- | | |
|---|---|
| 1 | <p>12/27/2022 – ROSEWOOD AVENUE WAS EXTENDED AND GRADING REVISED. CHANNEL WAS REVISED ALONG SUN VALLEY PARKWAY TO ACCOMMODATE AN ADDED SIDEWALK. GRADING FOR APS SUBSTATION ADDED & FIRE STATION. THE EROSION HAZARD SETBACK ALONG WAGNER WASH WAS REVISED.</p> |
| 2 | <p>8/23/2023 – REVISION TO CHANNEL ALIGNMENT AND REPLACE RIPRAP WITH SOIL CEMENT.</p> |

PLAN NAME

**VILLAGE 3 - UNITS 1 & 2
DRAINAGE CHANNEL PLAN**

ENGINEER INFORMATION



HILGARTWILSON

COB PERMITTING
APPROVED SEAL

COB ENGINEERING
APPROVED SEAL

APPROVED

6/22/2022

Y OF BUCKE
ENGINEERING

AS-BUILT SEAL

DESIGN SEAL



REGISTERED CERTIFICATE
23227

DAVID W.
GEORGE

Date Signed 5

ORIGINAL PLAN DATE

MAY 2022

PROJECT NUMBER
1175

LATEST REVISION DATE

AUG 2023


SHEET NUMBER **DC10** SH

AL:

ISSUE

[illegible]

0.

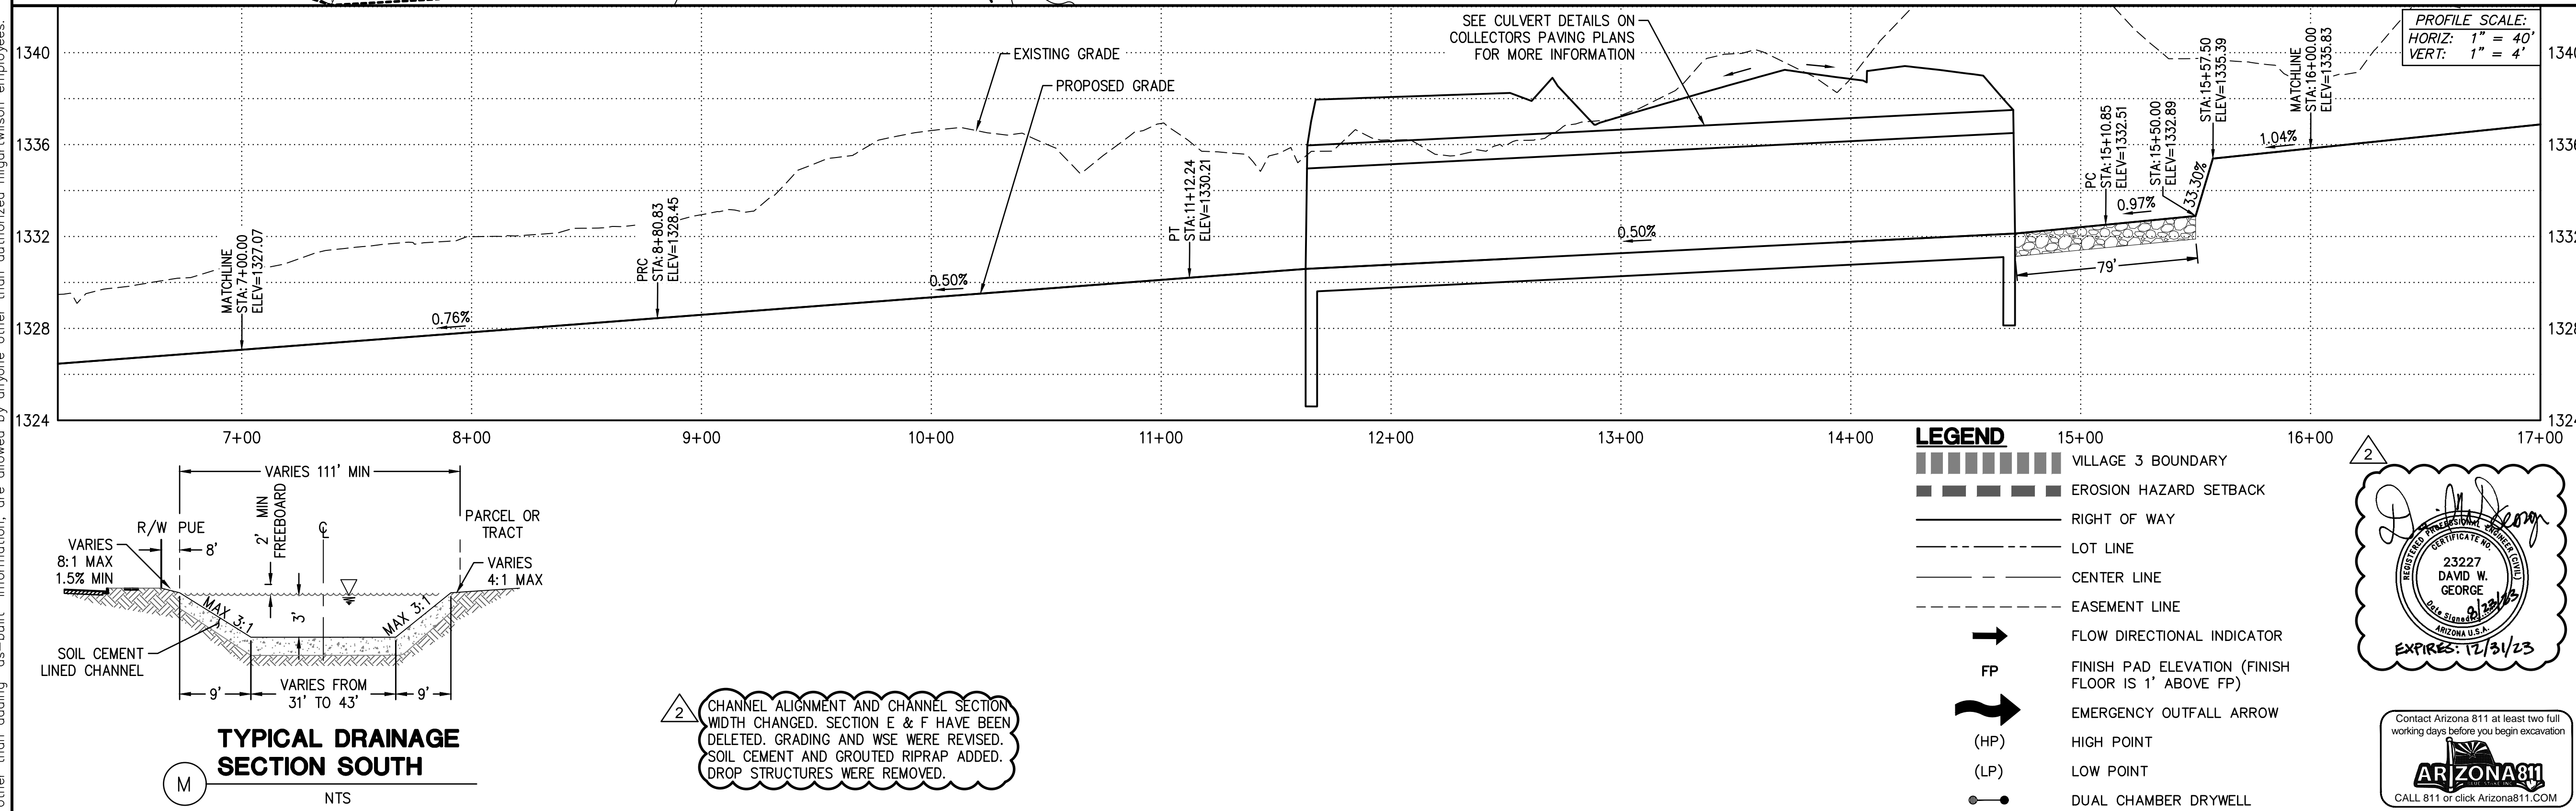NG #
-02

U:\1100\1175\ENGR\VILLAGE 3\MASS GRADING\CHANNEL\1175_DC10.dwg 9/7/2023 9:18 AM

Copyright, Hilgartwilson. This plan document set is the sole property of Hilgartwilson. No alterations to these plans, other than adding "as-built" information, are allowed by anyone other than authorized Hilgartwilson employees.

ROSEWOOD AVENUE

PARCEL 30

DRAINAGE CHANNEL NORTH
MATCHLINE SEE SHEET DC13

SUN VALLEY PARKWAY
STA: 38+94.96
ROSEWOOD AVENUE
STA: 21+27.96



CURVE TABLE				
NO.	RADIUS	DELTA	LENGTH	TANGENT
C1	200.00'	014°18'30"	49.95'	25.10
C2	200.00'	030°57'50"	108.08'	55.40
C3	400.00'	030°59'57"	216.41'	110.93

CURVE TABLE				
NO.	RADIUS	DELTA	LENGTH	TANGENT
C4	350.00'	031°50'50"	194.54'	99.86
C5	160.00'	129°31'58"	361.72'	339.50

LINE TABLE		
NO.	DIRECTION	LENGTH
L1	N00°31'18"E	308.64'
L2	N00°31'18"E	6.98'

DRAINAGE CHANNEL NORTH

SCALE: 1" = 40'

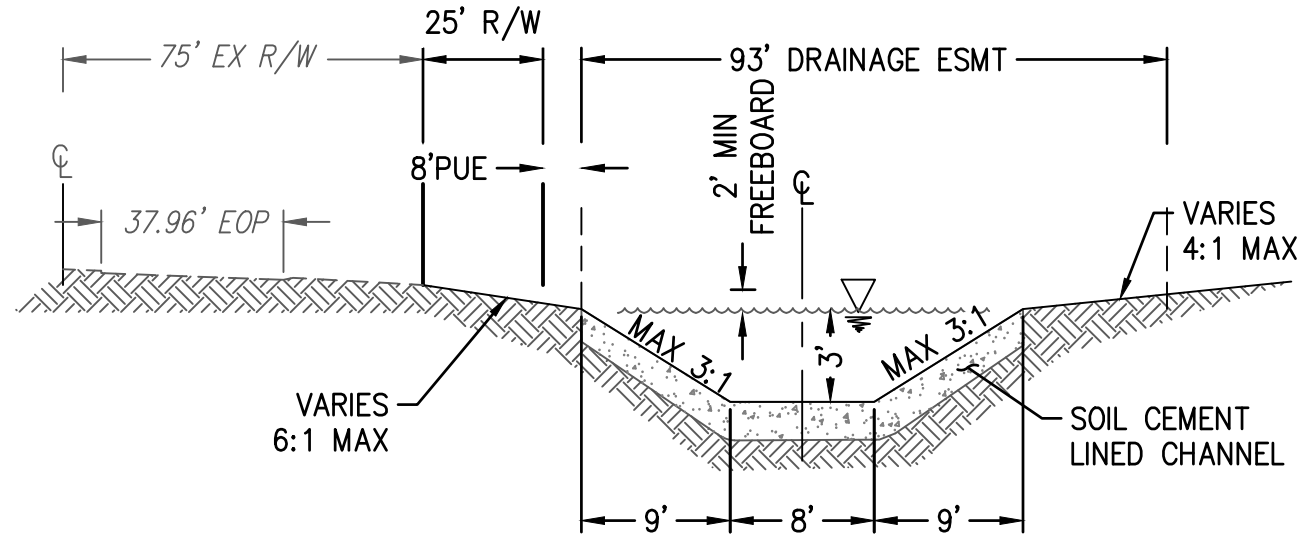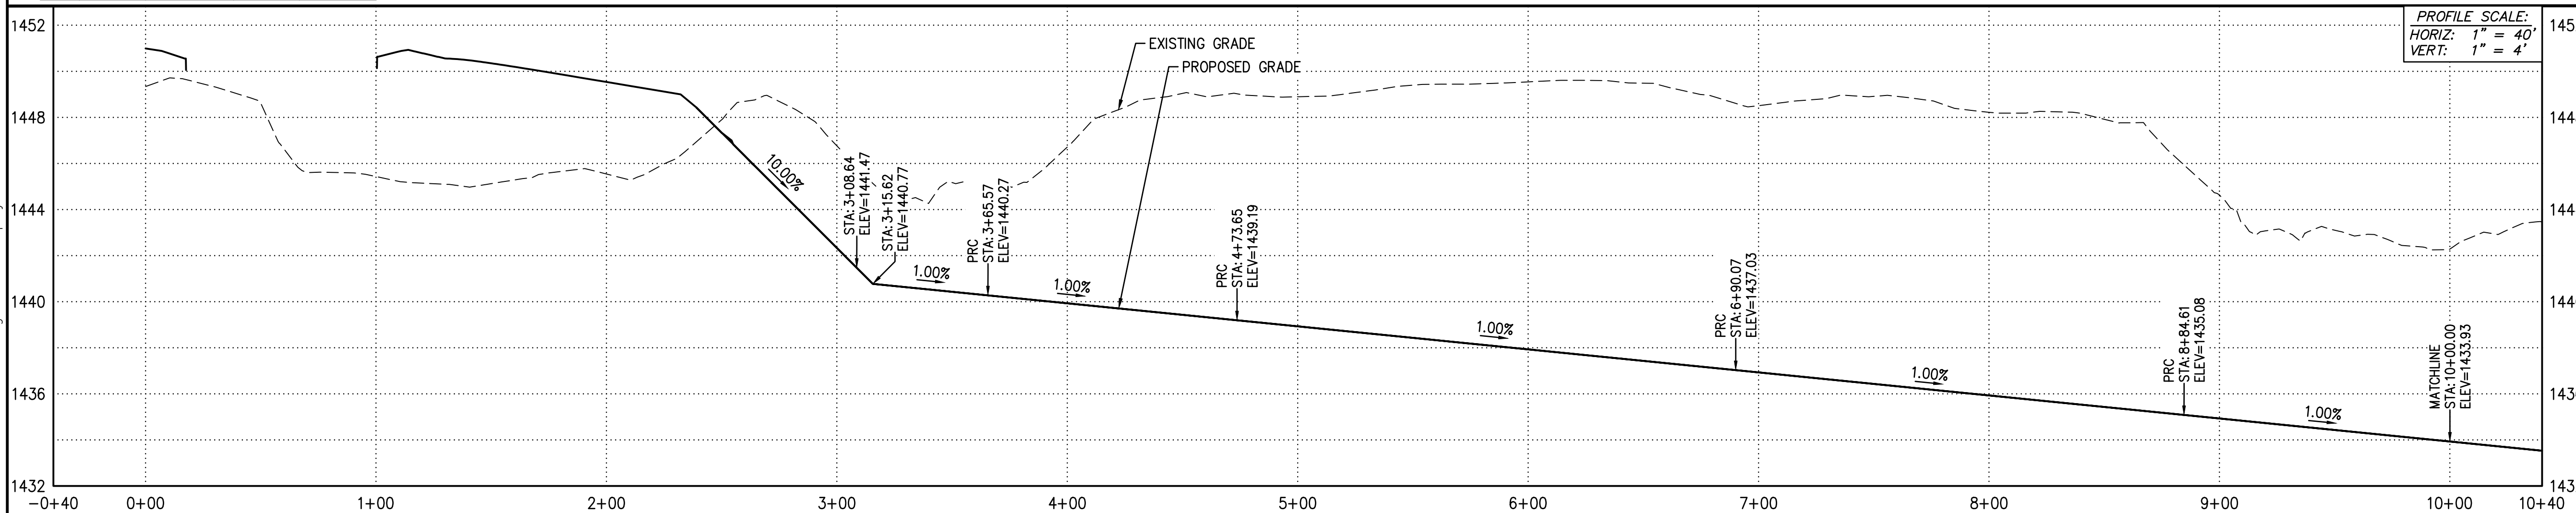



TYPICAL DRAINAGE
SECTION - SUN VALLEY PARKWAY

NTS

CHANNEL ALIGNMENT AND CHANNEL SECTION
WIDTH CHANGED. SECTION G HAS BEEN
DELETED. GRADING AND WSE WERE REVISED.
SOIL CEMENT AND GROUTED RIPRAP ADDED.
DROP STRUCTURES WERE REMOVED.


LEGEND

- VILLAGE 3 BOUNDARY
- EROSION HAZARD SETBACK
- RIGHT OF WAY
- LOT LINE
- CENTER LINE
- EASEMENT LINE
- FLOW DIRECTIONAL INDICATOR
- FINISH PAD ELEVATION (FINISH FLOOR IS 1' ABOVE FP)
- EMERGENCY OUTFALL ARROW
- HIGH POINT (HP)
- LOW POINT (LP)
- DUAL CHAMBER DRYWELL

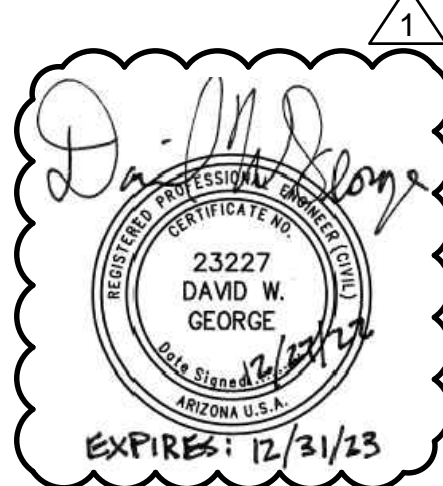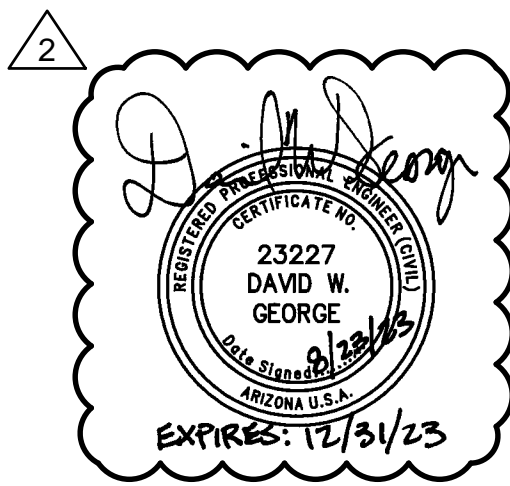

STORM DRAIN CONSTRUCTION

- 83. INSTALL LOOSE ANGULAR RIP-RAP PER MAG SPEC SEC. 220; D50=6", 12" THICK ON MIRAFI EROSION PROTECTION GEO-TEXTILE OR APPROVED EQUIVALENT. FABRIC TO HAVE APPARENT OPENING SIZE OF 0.425MM, PERMITTIVITY OF 50 GAL/MIN/FT AND WOVEN. SEE SHEET DC21 FOR DETAIL AND PLAN SHEET FOR QUANTITY. COLOR PER DEVELOPER.
- 91. INSTALL ANGULAR LOOSE RIP-RAP PER MAG SPEC SECTION 220 D50=6" 12" THICK ON MIRAFI EROSION PROTECTION GEO-TEXTILE OR APPROVED EQUIVALENT. FABRIC TO HAVE APPARENT OPENING SIZE OF 0.425MM, PERMITTIVITY OF 50 GAL/MIN/FT AND WOVEN. SPECIFIC WEIGHT = 165 LB/FT³. GRADATION PER TABLE 6.4 OF 2015 DRAINAGE DESIGN MANUAL FOR MARICOPA COUNTY, ARIZONA (HYDRAULICS).
- 96. INSTALL SOIL CEMENT PER MAG SPEC 311; SEE DETAIL 1 ON SHEET DC21.

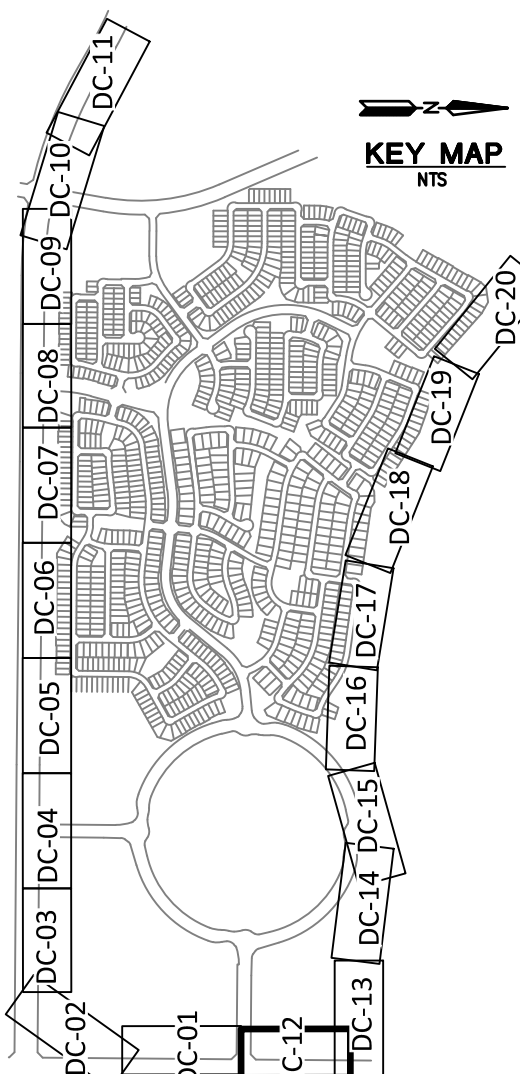

REVISIONS:

- 12/27/2022 - ROSEWOOD AVENUE WAS EXTENDED AND GRADING REVISED. CHANNEL WAS REVISED ALONG SUN VALLEY PARKWAY TO ACCOMMODATE AN ADDED SIDEWALK. GRADING FOR APS SUBSTATION ADDED & FIRE STATION. THE EROSION HAZARD SETBACK ALONG WAGNER WASH WAS REVISED.
- 8/23/2023 - REVISION TO CHANNEL ALIGNMENT AND REPLACE RIPRAP WITH SOIL CEMENT.


PLAN NAME

TRILLIUM
VILLAGE 3 - UNITS 1 & 2
DRAINAGE CHANNEL PLAN


ENGINEER INFORMATION

HILGARTWILSON		SUBMITTAL: 3R Submittal
COB PERMITTING APPROVED SEAL	COB ENGINEERING APPROVED SEAL	
APPROVED 6/22/2022 CITY OF BUCKEYE ENGINEERING		COB PLAN TRACKING # ENG-21-0220 COB PERMIT #
AS-BUILT SEAL	DESIGN SEAL	
ORIGINAL PLAN DATE MAY 2022	LATEST REVISION DATE AUG 2023	SHEET NUMBER 1175
PROJECT NUMBER 1175	SHEET NUMBER DC12	

Copyright, Hilgartwilson - This plan document set is the sole property of Hilgartwilson. No alterations to these plans, other than adding "as-built" information, are allowed by anyone other than authorized Hilgartwilson employees.

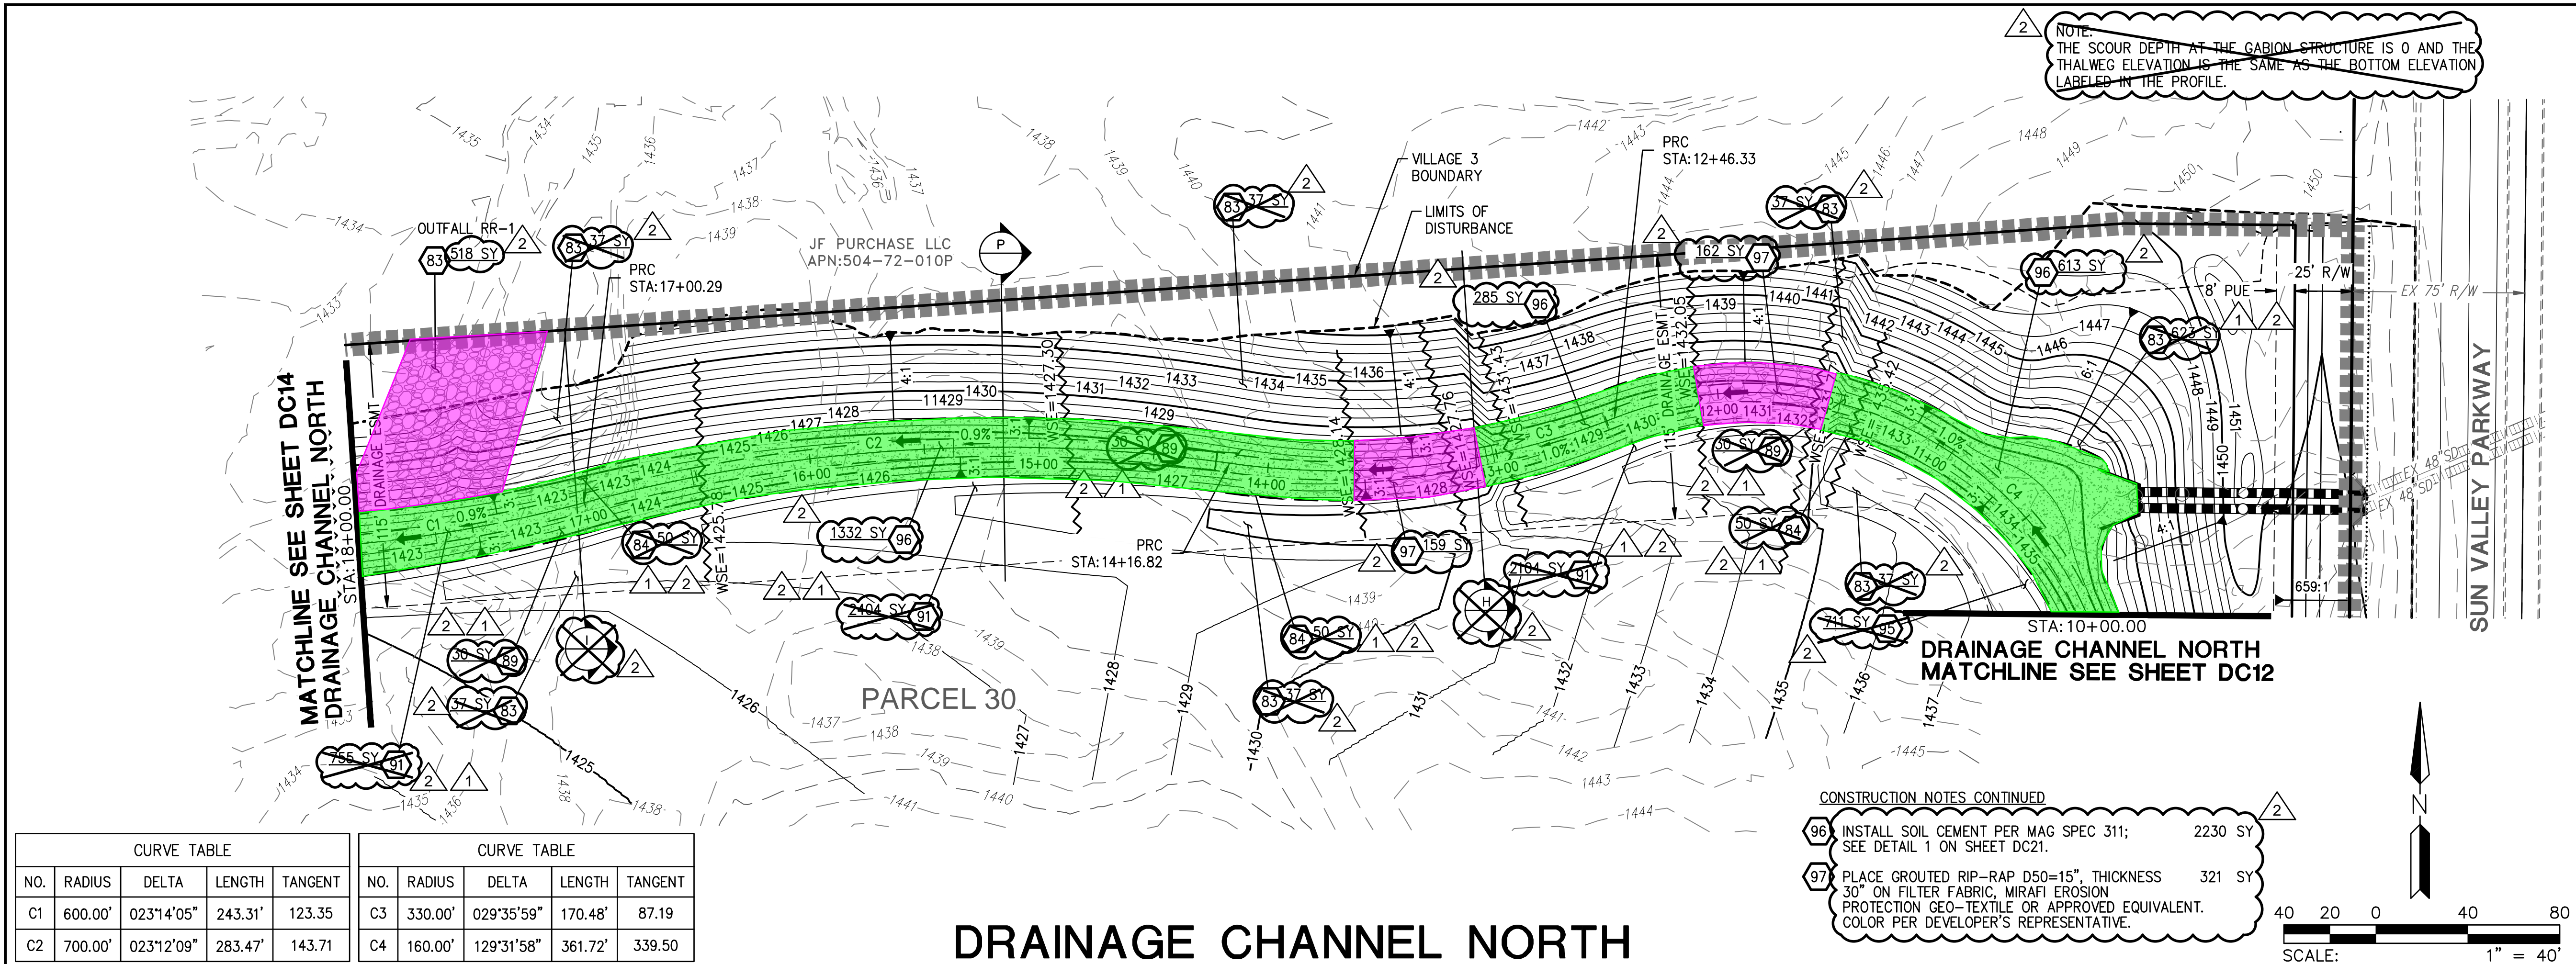

DRAINAGE CHANNEL NORTH

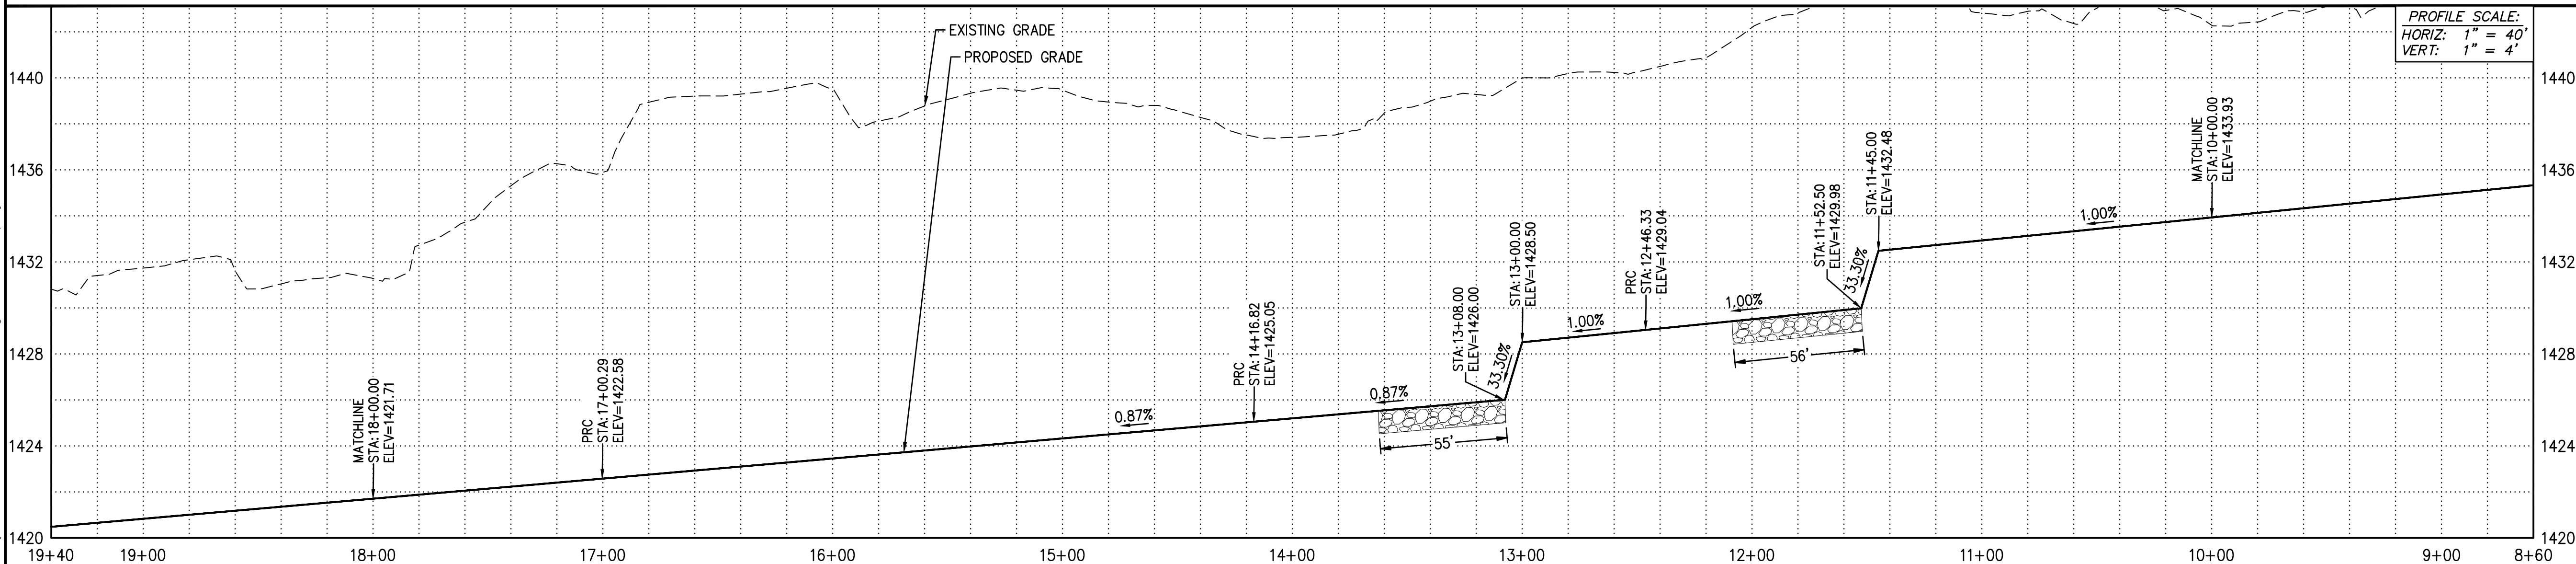

STORM DRAIN CONSTRUCTION

518

83. INSTALL LOOSE ANGULAR RIP-RAP PER MAG SPEC SEC. 220; D50=6", 12" THICK ON MIRAFI EROSION PROTECTION GEO-TEXTILE OR APPROVED EQUIVALENT. FABRIC TO HAVE APPARENT OPENING SIZE OF 0.425MM, PERMITTIVITY OF 50 GAL/MIN/FT AND WOVEN. SEE SHEET# DC21 FOR DETAIL AND PLAN SHEET FOR QUANTITY. COLOR PER DEVELOPER.

84. INSTALL GABIONS ON MACCAFERRI GEOTEXTILE MACTEX 147.1. PER DETAILS SEE SHEET# DC21.

89. INSTALL 2" OF SHOTCRETE ON TOP OF GABION BASKET WITH D50=6" EMBEDDED IN SHOTCRETE.

91. INSTALL ANGULAR LOOSE RIP-RAP PER MAG SPEC SECTION 220 D50=4" 9" THICK ON MIRAFI EROSION PROTECTION GEO-TEXTILE OR APPROVED EQUIVALENT. FABRIC TO HAVE APPARENT OPENING SIZE OF 0.425MM, PERMITTIVITY OF 50 gal/min/ft AND WOVEN. SPECIFIC WEIGHT = 165 lb/ft³. GRADATION PER TABLE 6.4 OF 2013 DRAINAGE DESIGN MANUAL FOR MARICOPA COUNTY, ARIZONA (HYDRAULICS).

95. INSTALL ANGULAR LOOSE RIP-RAP PER MAG SPEC SEC. 220; D50=6", 9" THICK ON MIRAFI EROSION PROTECTION GEO-TEXTILE OR APPROVED EQUIVALENT. FABRIC TO HAVE APPARENT OPENING SIZE OF 0.425MM, PERMITTIVITY OF 50 gal/min/ft AND WOVEN. SPECIFIC WEIGHT = 165 lb/ft³. GRADATION PER TABLE 6.4 OF 2013 DRAINAGE DESIGN MANUAL FOR MARICOPA COUNTY, ARIZONA (HYDRAULICS).

* CONSTRUCTION NOTES CONTINUED (ON THE LEFT)

KEY MAP

REVISIONS:

12/27/2022 - ROSEWOOD AVENUE WAS EXTENDED AND GRADING REVISED. CHANNEL WAS REVISED ALONG SUN VALLEY PARKWAY TO ACCOMMODATE AN ADDED SIDEWALK. GRADING FOR APS SUBSTATION ADDED & FIRE STATION. THE EROSION HAZARD SETBACK ALONG WAGNER WASH WAS REVISED.

8/23/2023 - REVISION TO CHANNEL ALIGNMENT AND REPLACE RIPRAP WITH SOIL CEMENT.

PLAN NAME

TRILLIUM VILLAGE 3 - UNITS 1 & 2 DRAINAGE CHANNEL PLAN

ENGINEER INFORMATION

HILGARTWILSON

COB PERMITTING APPROVED SEAL

COB ENGINEERING APPROVED SEAL

APPROVED

6/22/2022

CITY OF BUCKEYE ENGINEERING

AS-BUILT SEAL

DESIGN SEAL

23227 DAVID W. GEORGE

EXPIRES: 12/31/23

ORIGINAL PLAN DATE

MAY 2022

LATEST REVISION DATE

AUG 2023

PROJECT NUMBER

1175

SHEET NUMBER

DC13

SHT.

82 OF 90

COB PLAN TRACKING #

ENG-21-0220

COB PERMIT #

3R Submittal

Copyright, Hilgartwilson. This plan document set is the sole property of Hilgartwilson. No alterations to these plans, other than adding "as-built" information, are allowed by anyone other than authorized Hilgartwilson employees.


CURVE TABLE				
NO.	RADIUS	DELTA	LENGTH	TANGENT
C1	440.00'	027°24'25"	210.47'	107.289
C2	370.00'	018°44'33"	121.03'	61.062
C3	250.00'	046°08'22"	201.32'	106.478
C4	550.00'	026°37'48"	255.63'	130.167
C5	600.00'	023°14'05"	243.31'	123.352

DRAINAGE CHANNEL NORTH


NOTE:
THE SCOUR DEPTH AT THE GABION STRUCTURE IS 0 AND THE THALWEG ELEVATION IS THE SAME AS THE BOTTOM ELEVATION LABELED IN THE PROFILE.

SCALE: 1" = 40'

PROFILE SCALE:
HORIZ: 1" = 40'
VERT: 1" = 4'

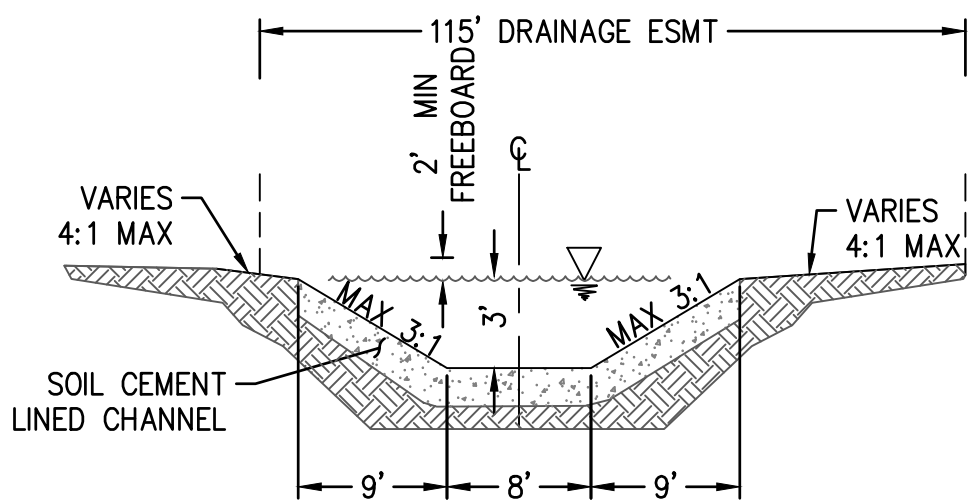

TYPICAL DRAINAGE SECTION-NORTH

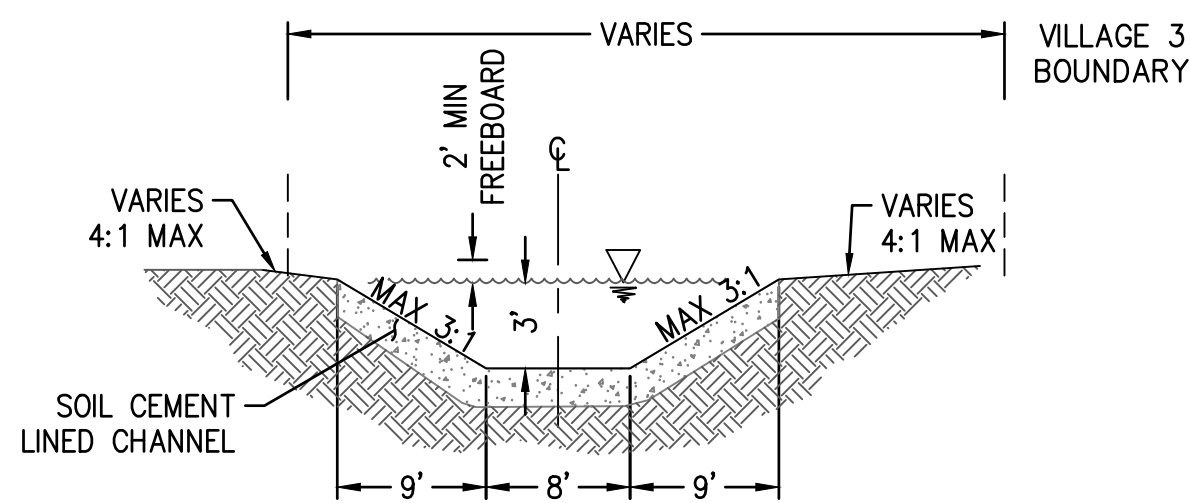


TYPICAL DRAINAGE SECTION-NORTH

CHANNEL ALIGNMENT AND CHANNEL SECTION WIDTH CHANGED. SECTION H, I & J HAVE BEEN DELETED. GRADING AND WSE WERE REVISED. SOIL CEMENT AND GROUTED RIPRAP ADDED. DROP STRUCTURES WERE REMOVED.


LEGEND

- VILLAGE 3 BOUNDARY
- EROSION HAZARD SETBACK
- RIGHT OF WAY
- LOT LINE
- CENTER LINE
- EASEMENT LINE
- FLOW DIRECTIONAL INDICATOR
- FINISH PAD ELEVATION (FINISH FLOOR IS 1' ABOVE FP)
- EMERGENCY OUTFALL ARROW
- HIGH POINT
- LOW POINT
- DUAL CHAMBER DRYWELL

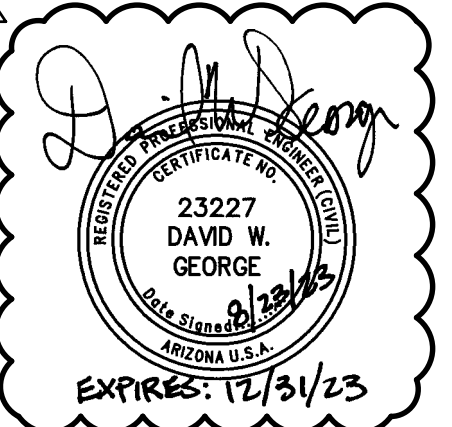

STORM DRAIN CONSTRUCTION

- INSTALL LOOSE ANGULAR RIP-RAP PER MAG SPEC SEC. 220; D50=6", 12" THICK ON MIRAFI EROSION PROTECTION GEO-TEXTILE OR APPROVED EQUIVALENT. FABRIC TO HAVE APPARENT OPENING SIZE OF 0.425MM, PERMITTIVITY OF 50 GAL/MIN/FT AND WOVEN. SEE SHEET# DC21 FOR DETAIL AND PLAN SHEET FOR QUANTITY. COLOR PER DEVELOPER.
- INSTALL GABIONS ON MACCAFFERRI GEOTEXTILE MACTEX N47.1. PER DETAILS SEE SHEET# DC21.
- INSTALL 2" OF SHOTCRETE ON TOP OF GABION BASKET WITH D50=6" EMBEDDED IN SHOTCRETE.
- INSTALL LOOSE ANGULAR RIP-RAP PER MAG SPEC SEC. 220; D50=9", 18" THICK ON MIRAFI EROSION PROTECTION GEO-TEXTILE OR APPROVED EQUIVALENT. FABRIC TO HAVE APPARENT OPENING SIZE OF 0.425MM, PERMITTIVITY OF 50 GAL/MIN/FT AND WOVEN. SEE SHEET# DC21 FOR DETAIL AND PLAN SHEET FOR QUANTITY. COLOR PER DEVELOPER.
- INSTALL ANGULAR LOOSE RIP-RAP PER MAG SPEC SEC. 220; D50=4" 6" THICK ON MIRAFI EROSION PROTECTION GEO-TEXTILE OR APPROVED EQUIVALENT. FABRIC TO HAVE APPARENT OPENING SIZE OF 0.425MM, PERMITTIVITY OF 50 gal/min/ft AND WOVEN. SPECIFIC WEIGHT = 165 lb/H3 GRADATION PER TABLE 6.4 OF 2013 DRAINAGE DESIGN MANUAL FOR MARICOPA COUNTY, ARIZONA (HYDRAULICS).
- INSTALL SOIL CEMENT PER MAG SPEC 311; SEE DETAIL 1 ON SHEET DC21.

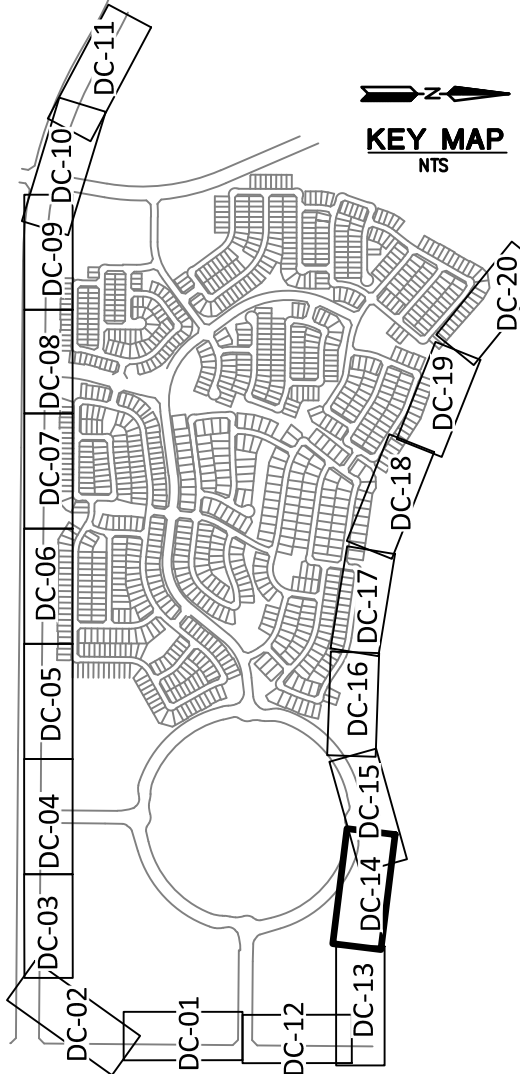



REVISIONS:

- 12/27/2022 - ROSEWOOD AVENUE WAS EXTENDED AND GRADING REVISED. CHANNEL WAS REVISED ALONG SUN VALLEY PARKWAY TO ACCOMMODATE AN ADDED SIDEWALK. GRADING FOR APS SUBSTATION ADDED & FIRE STATION. THE EROSION HAZARD SETBACK ALONG WAGNER WASH WAS REVISED.
- 8/23/2023 - REVISION TO CHANNEL ALIGNMENT AND REPLACE RIPRAP WITH SOIL CEMENT.




PLAN NAME

TRILLIUM VILLAGE 3 - UNITS 1 & 2 DRAINAGE CHANNEL PLAN

ENGINEER INFORMATION


		SUBMITTAL: 3R Submittal
COB PERMITTING APPROVED SEAL	COB ENGINEERING APPROVED SEAL	
	APPROVED 6/22/2022 CITY OF BUCKEYE ENGINEERING	
AS-BUILT SEAL	DESIGN SEAL 	COB PLAN TRACKING # ENG-21-0220 COB PERMIT #
ORIGINAL PLAN DATE MAY 2022	LATEST REVISION DATE AUG 2023	
PROJECT NUMBER 1175	SHEET NUMBER DC14	SHT. 83 OF 90

Copyright, Hilgartwilson - This plan document set is the sole property of Hilgartwilson. No alterations to these plans, other than adding "as-built" information, are allowed by anyone other than authorized Hilgartwilson employees.

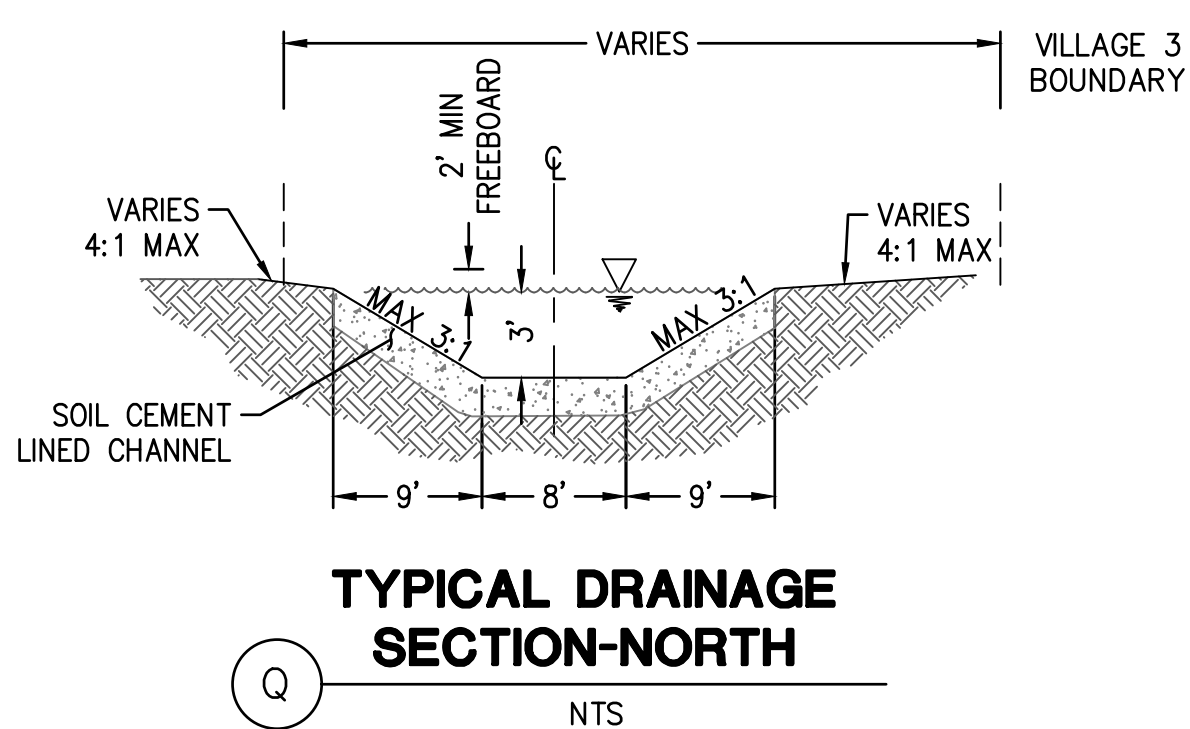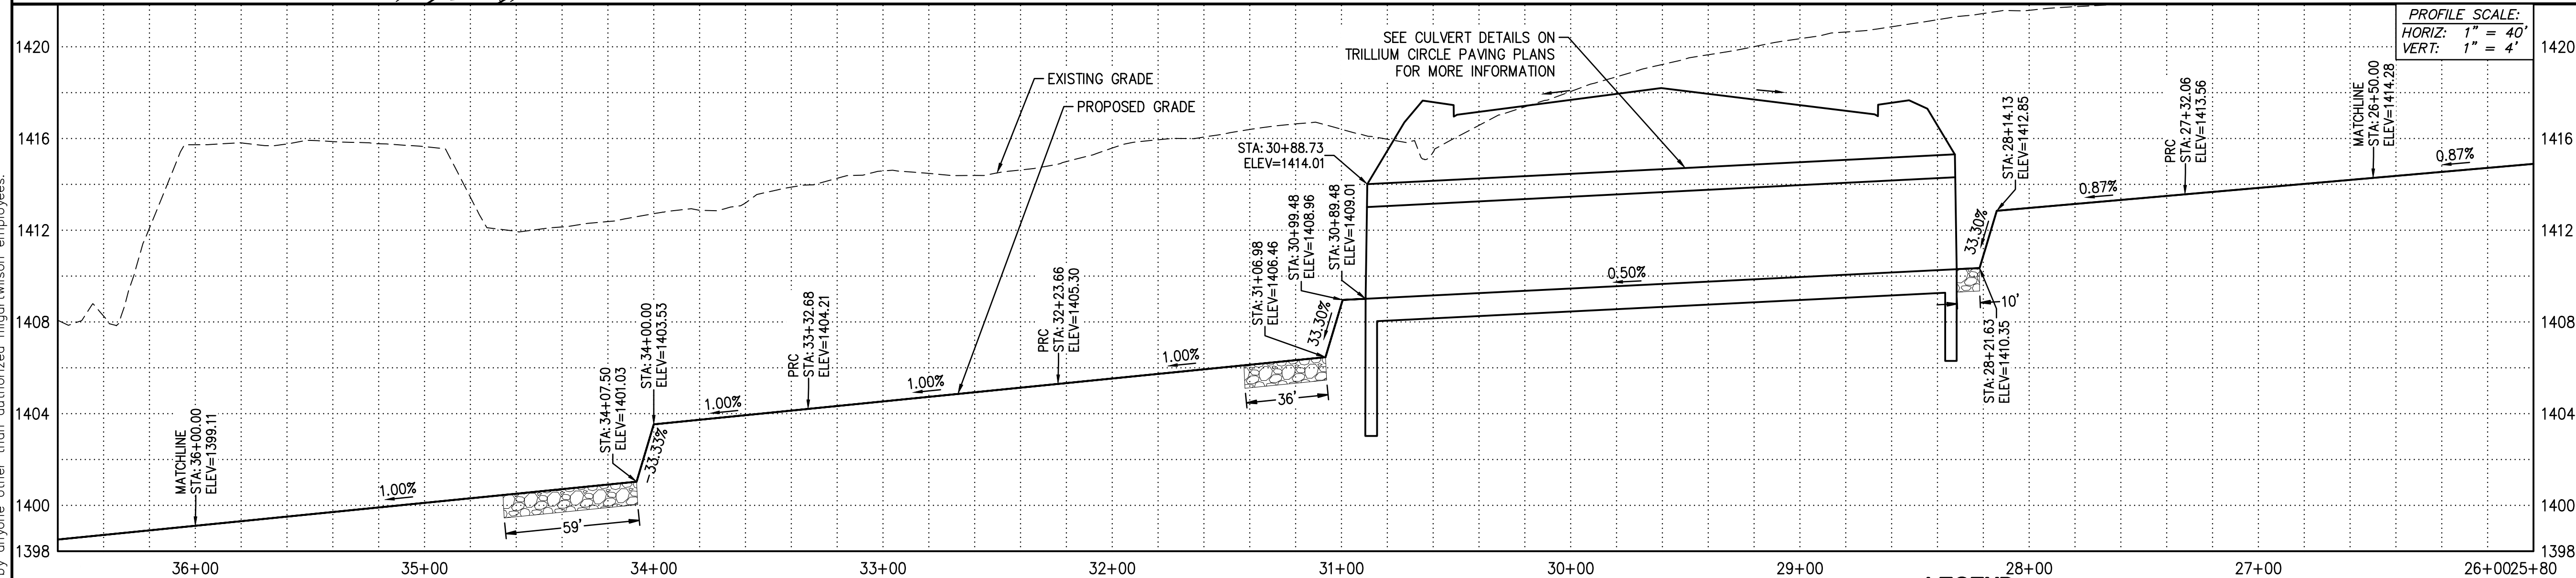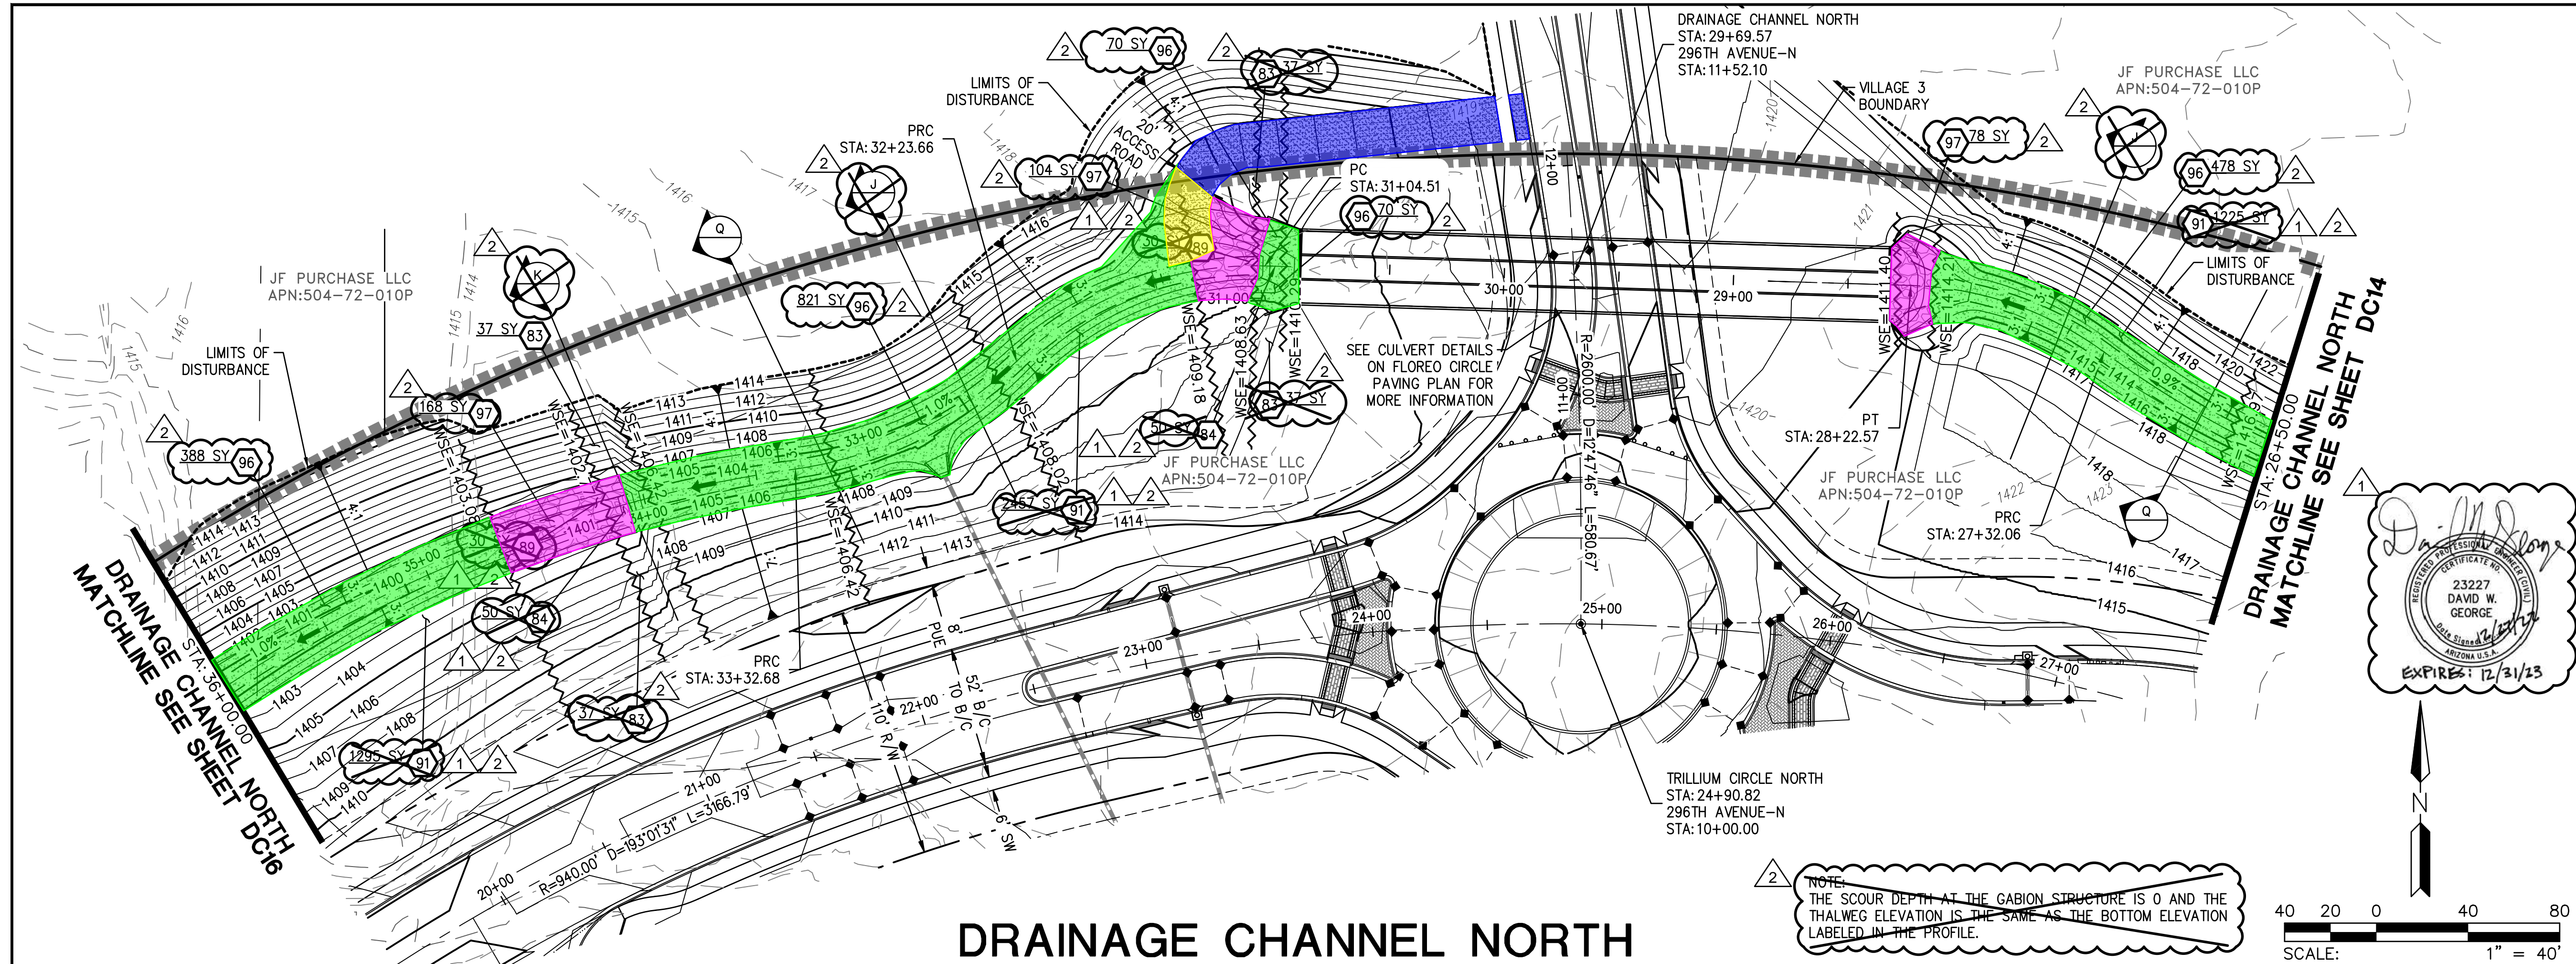


CHANNEL ALIGNMENT AND CHANNEL SECTION WIDTH CHANGED. SECTION J & K HAVE BEEN DELETED. GRADING AND WSE WERE REVISED. SOIL CEMENT AND GROUTED RIPRAP ADDED. DROP STRUCTURES WERE REMOVED.

- LEGEND**
- VILLAGE 3 BOUNDARY
 - EROSION HAZARD SETBACK
 - RIGHT OF WAY
 - LOT LINE
 - CENTER LINE
 - EASEMENT LINE
 - FLOW DIRECTIONAL INDICATOR
 - FINISH PAD ELEVATION (FINISH FLOOR IS 1' ABOVE FP)
 - EMERGENCY OUTFALL ARROW
 - (HP) HIGH POINT
 - (LP) LOW POINT
 - DUAL CHAMBER DRYWELL

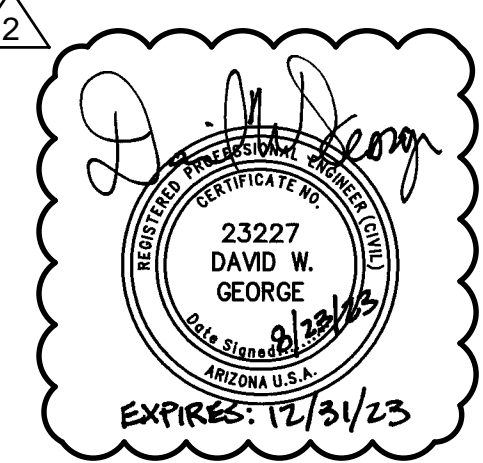

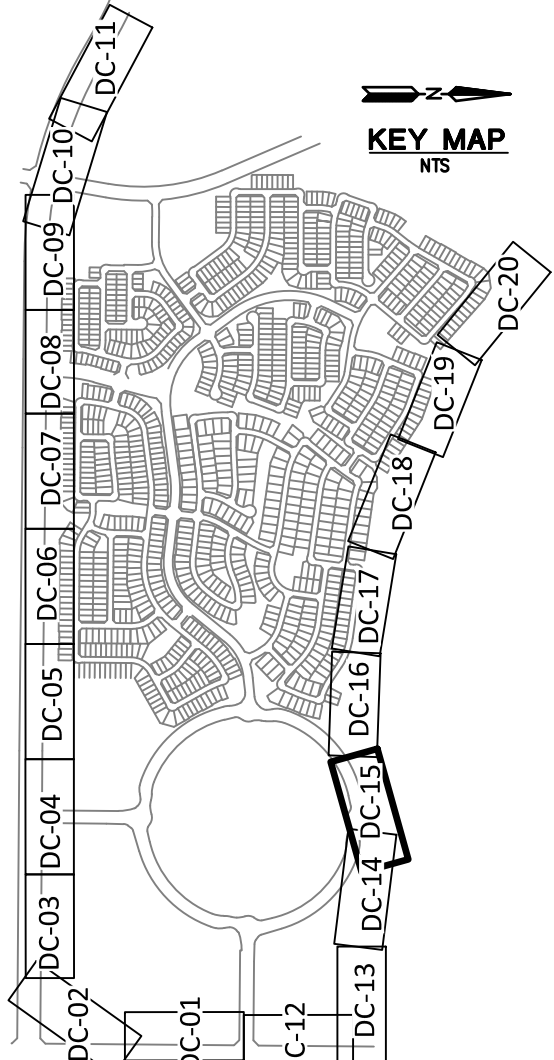

- STORM DRAIN CONSTRUCTION**
- 83. INSTALL LOOSE ANGULAR RIP-RAP PER MAG SPEC SEC. 220; D50=6", 12" THICK ON MIRAFI EROSION PROTECTION GEO-TEXTILE OR APPROVED EQUIVALENT. FABRIC TO HAVE APPARENT OPENING SIZE OF 0.425MM, PERMITTIVITY OF 50 GAL/MIN/FT AND WOVEN. SEE SHEET# DC21 FOR DETAIL AND PLAN SHEET FOR QUANTITY. COLOR PER DEVELOPER. 148 SY
 - 84. INSTALL GABIONS ON MACCAFFERRI GEOTEXTILE MACTEX N47.1. PER DETAILS SEE SHEET# DC21. 100 SY
 - 89. INSTALL 2" OF SHOTCRETE ON TOP OF GABION BASKET WITH D50=6" EMBEDDED IN SHOTCRETE. 60 SY
 - 91. INSTALL ANGULAR LOOSE RIP-RAP PER MAG SPEC SECTION 220; D50=4" 6" THICK ON MIRAFI EROSION PROTECTION GEO-TEXTILE OR APPROVED EQUIVALENT. FABRIC TO HAVE APPARENT OPENING SIZE OF 0.425MM, PERMITTIVITY OF 50 gal/min/ft AND WOVEN. SPECIFIC WEIGHT = 135 lb/ft³. GRADATION PER TABLE 6.4 OF 2013 DRAINAGE DESIGN MANUAL FOR MARICOPA COUNTY, ARIZONA (HANDRAILS). 4977 SY
 - 96. INSTALL SOIL CEMENT PER MAG SPEC 311; SEE DETAIL 1 ON SHEET DC21. 1827 SY
 - 97. PLACE GROUTED RIP-RAP D50=15", THICKNESS 30" ON FILTER FABRIC, MIRAFI EROSION PROTECTION GEO-TEXTILE OR APPROVED EQUIVALENT. COLOR PER DEVELOPER'S REPRESENTATIVE. 350 SY




- REVISIONS:**
- 12/27/2022 - ROSEWOOD AVENUE WAS EXTENDED AND GRADING REVISED. CHANNEL WAS REVISED ALONG SUN VALLEY PARKWAY TO ACCOMMODATE AN ADDED SIDEWALK. GRADING FOR APS SUBSTATION ADDED & FIRE STATION. THE EROSION HAZARD SETBACK ALONG WAGNER WASH WAS REVISED.
 - 8/23/2023 - REVISION TO CHANNEL ALIGNMENT AND REPLACE RIPRAP WITH SOIL CEMENT.



PLAN NAME
TRILLIUM VILLAGE 3 - UNITS 1 & 2 DRAINAGE CHANNEL PLAN

ENGINEER INFORMATION		SUBMITTAL:	3R Submittal
<div> HILGARTWILSON</div>			
COB PERMITTING APPROVED SEAL	COB ENGINEERING APPROVED SEAL	CITY OF BUCKEYE ENGINEERING	ENG - 21 - 0020
APPROVED 6/22/2022			
AS-BUILT SEAL	DESIGN SEAL	COB PLAN TRACKING #	COB PERMIT #
<div></div>			
ORIGINAL PLAN DATE MAY 2022	LATEST REVISION DATE AUG 2023		
PROJECT NUMBER 1175	SHEET NUMBER DC15	84 OF 90	

Copyright, Hilgartwilson. This plan document set is the sole property of Hilgartwilson. No alterations to these plans, other than adding "as-built" information, are allowed by anyone other than authorized Hilgartwilson employees.

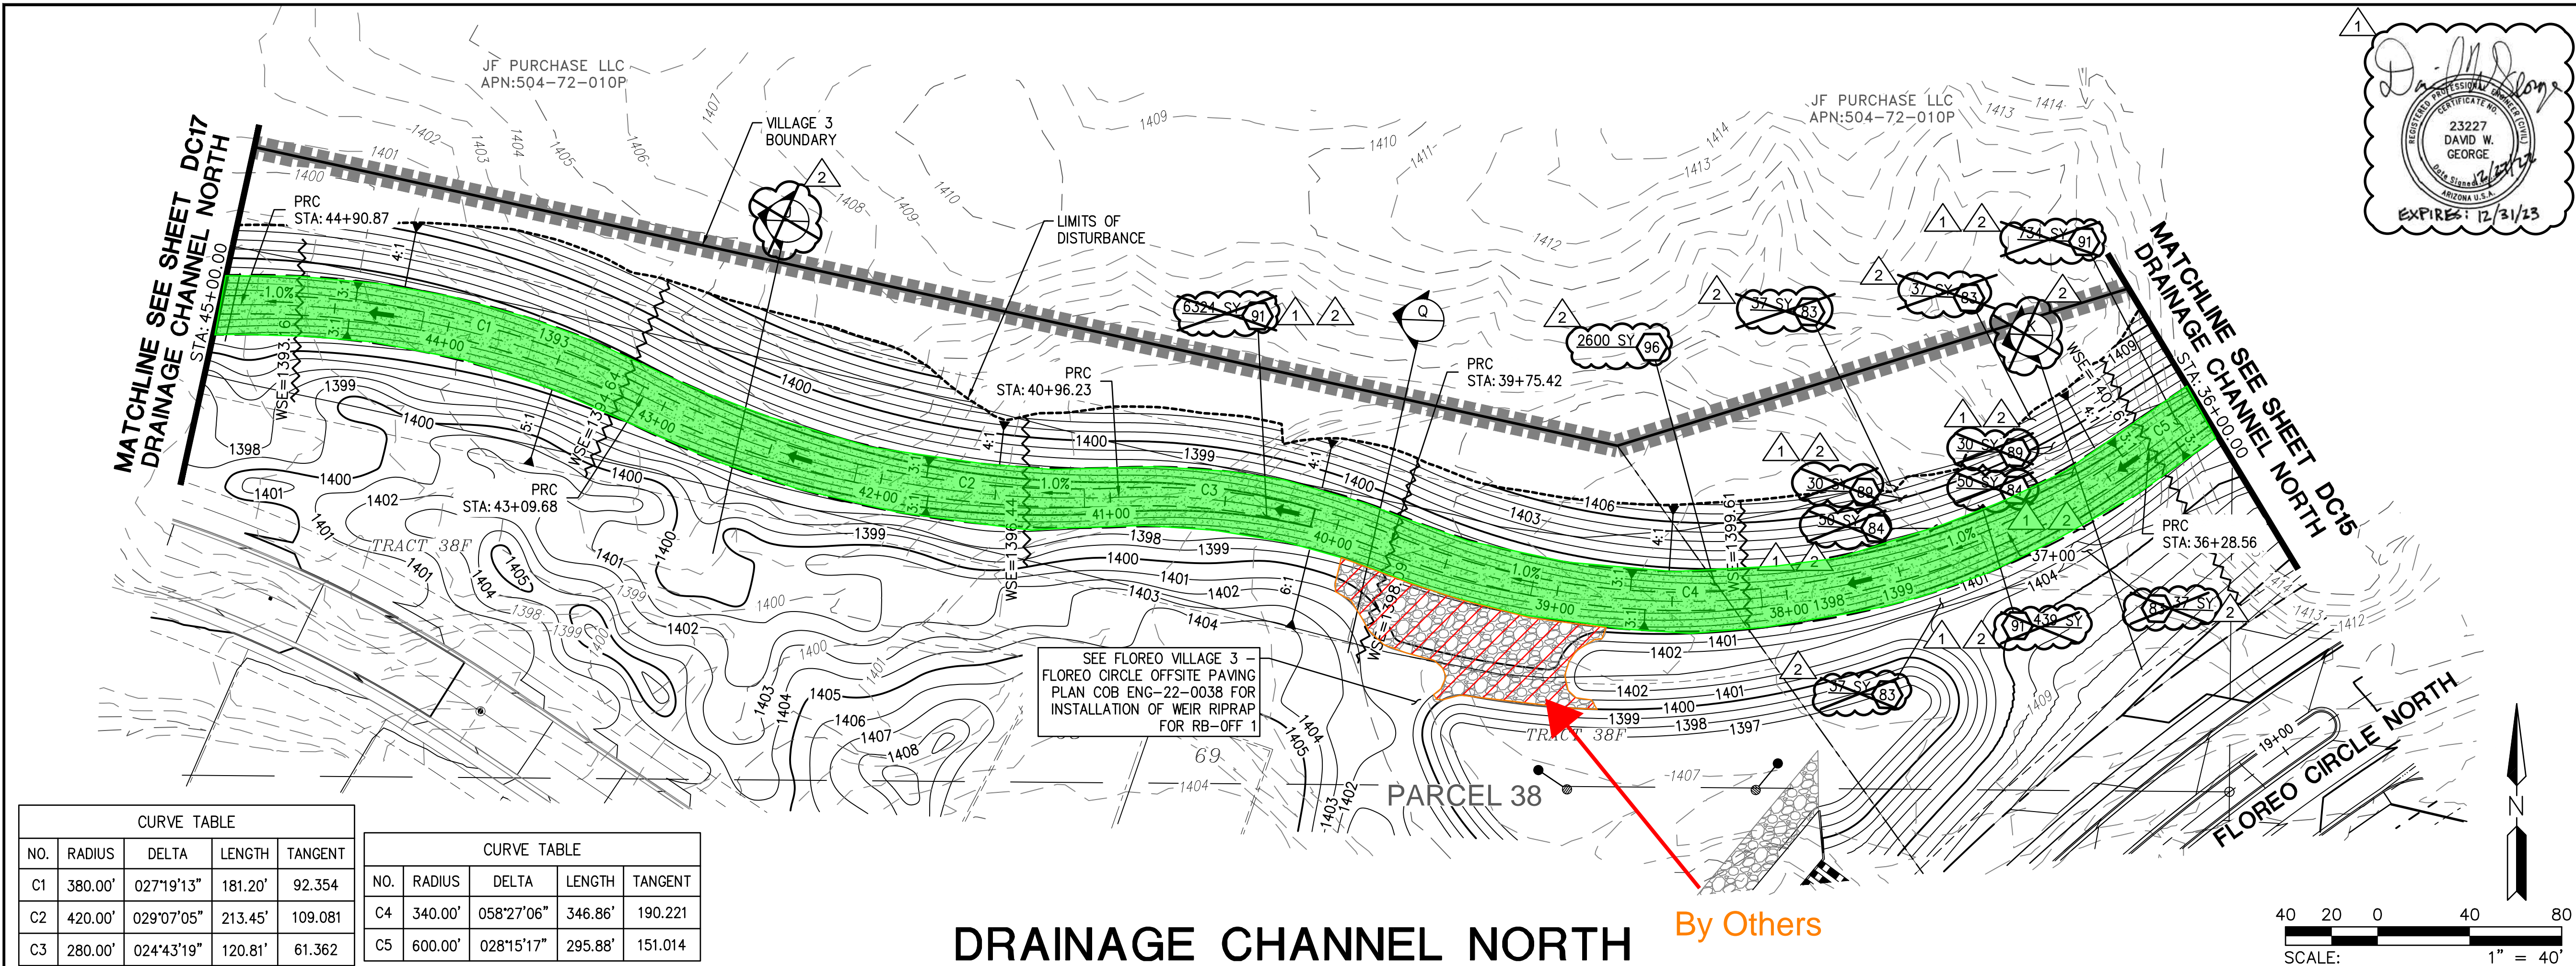

CURVE TABLE					CURVE TABLE				
NO.	RADIUS	DELTA	LENGTH	TANGENT	NO.	RADIUS	DELTA	LENGTH	TANGENT
C1	380.00'	027°19'13"	181.20'	92.354	C4	340.00'	058°27'06"	346.86'	190.221
C2	420.00'	029°07'05"	213.45'	109.081	C5	600.00'	028°15'17"	295.88'	151.014
C3	280.00'	024°43'19"	120.81'	61.362					

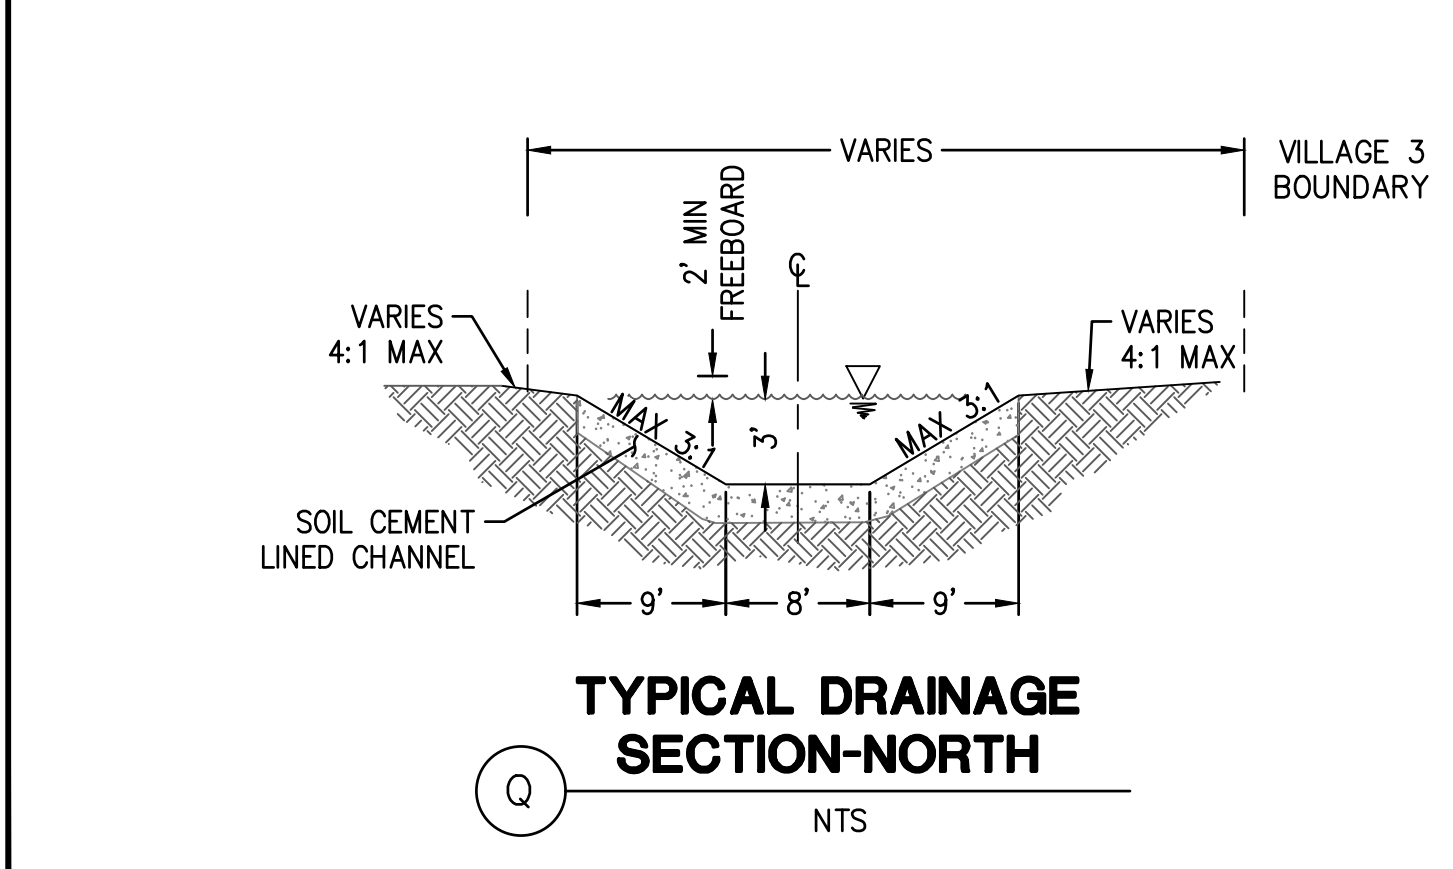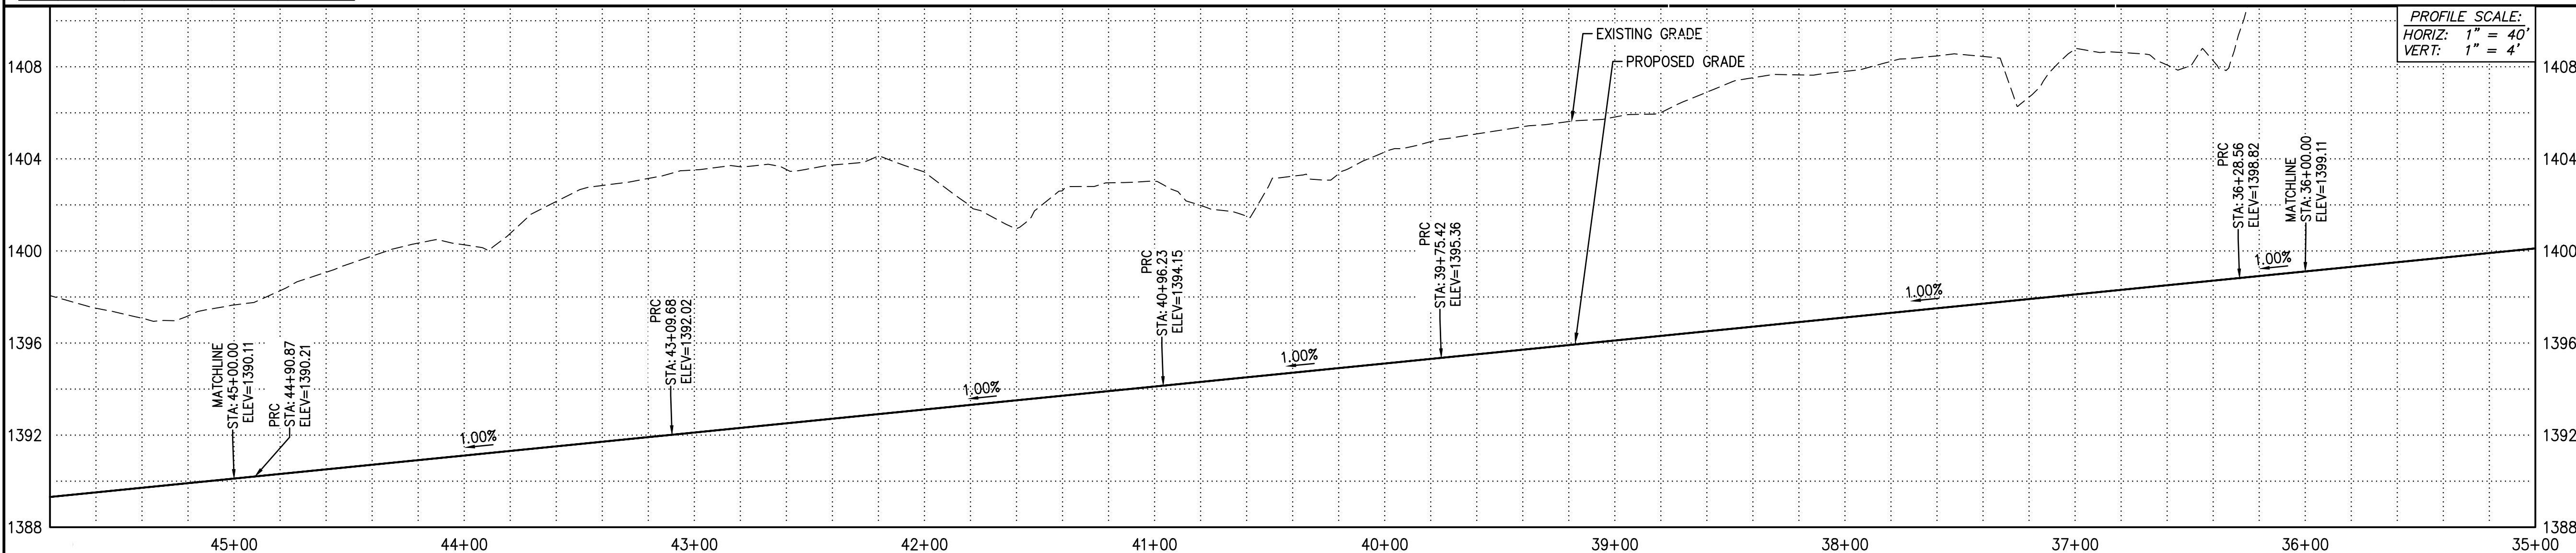

STORM DRAIN CONSTRUCTION

83. INSTALL LOOSE ANGULAR RIP-RAP PER MAG SPEC SEC. 220; D50=6", 12" THICK ON MIRAFI EROSION PROTECTION GEO-TEXTILE OR APPROVED EQUIVALENT. FABRIC TO HAVE APPARENT OPENING SIZE OF 0.425MM, PERMITTIVITY OF 50 GAL/MIN/FT AND WOVEN. SEE SHEET# DC21 FOR DETAIL AND PLAN SHEET FOR QUANTITY. COLOR PER DEVELOPER.

84. INSTALL GABIONS ON MACCAFFERRI GEOTEXTILE MACTEX N47.1. PER DETAILS SEE SHEET# DC21.

89. INSTALL 2" OF SHOTCRETE ON TOP OF GABION BASKET WITH D50=6" EMBEDDED IN SHOTCRETE.

91. INSTALL ANGULAR LOOSE RIP-RAP PER MAG SPEC SECTION 220 D50=4" 6" THICK ON MIRAFI EROSION PROTECTION GEO-TEXTILE OR APPROVED EQUIVALENT. FABRIC TO HAVE APPARENT OPENING SIZE OF 0.425MM, PERMITTIVITY OF 50 gal/min/ft AND WOVEN. SPECIFIC WEIGHT = 165 lb/H3. GRADATION PER TABLE 6.4 OF 2013 DRAINAGE DESIGN MANUAL FOR MARICOPA COUNTY, ARIZONA (HYDRAULICS).

96. INSTALL SOIL CEMENT PER MAG SPEC 311; SEE DETAIL 1 ON SHEET DC21.

NOTE: THE SCOUR DEPTH AT THE GABION STRUCTURE IS 0 AND THE THALWEG ELEVATION IS THE SAME AS THE BOTTOM ELEVATION LABELED IN THE PROFILE.

KEY MAP

DC-01 DC-02 DC-03 DC-04 DC-05 DC-06 DC-07 DC-08 DC-09 DC-10 DC-11 DC-12 DC-13 DC-14 DC-15 DC-16 DC-17 DC-18 DC-19 DC-20

REVISIONS:

12/27/2022 - ROSEWOOD AVENUE WAS EXTENDED AND GRADING REVISED. CHANNEL WAS REVISED ALONG SUN VALLEY PARKWAY TO ACCOMMODATE AN ADDED SIDEWALK. GRADING FOR APS SUBSTATION ADDED & FIRE STATION. THE EROSION HAZARD SETBACK ALONG WAGNER WASH WAS REVISED.

8/23/2023 - REVISION TO CHANNEL ALIGNMENT AND REPLACE RIPRAP WITH SOIL CEMENT.

PLAN NAME

TRILLIUM VILLAGE 3 - UNITS 1 & 2 DRAINAGE CHANNEL PLAN

ENGINEER INFORMATION

HILGARTWILSON

COB PERMITTING APPROVED SEAL

COB ENGINEERING APPROVED SEAL

APPROVED

6/22/2022

CITY OF BUCKEYE ENGINEERING

AS-BUILT SEAL

DESIGN SEAL

23227 DAVID W. GEORGE

EXPIRES: 12/31/23

ORIGINAL PLAN DATE

MAY 2022

LATEST REVISION DATE

AUG 2023

PROJECT NUMBER

1175

SHEET NUMBER

DC16

SHT.

85 OF 90

COB PLAN TRACKING #


ENG-21-0220

COB PERMIT #


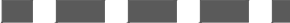





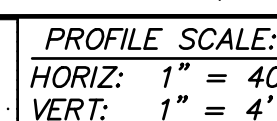


3R Submittal



40 20 0 40 80
SCALE: 1" = 40'

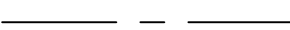

LEGEND


	VILLAGE 3 BOUNDARY
	EROSION HAZARD SETBACK
	RIGHT OF WAY
	LOT LINE
	CENTER LINE
	EASEMENT LINE
	FLOW DIRECTIONAL INDICATOR
	FINISH PAD ELEVATION (FINISH FLOOR IS 1' ABOVE FP)
	EMERGENCY OUTFALL ARROW
(HP)	HIGH POINT
(LP)	LOW POINT
	DUAL CHAMBER DRYWELL



KEY MAP
NT5



The map shows a grid of streets labeled DC-01 through DC-20. DC-17 is highlighted with a thick black border. The streets are arranged in a grid pattern, with DC-01 at the top and DC-20 at the bottom. DC-17 is located in the middle of the grid, between DC-16 and DC-18.

90	COB PLAN TRACKING #
	ENG-21-0220

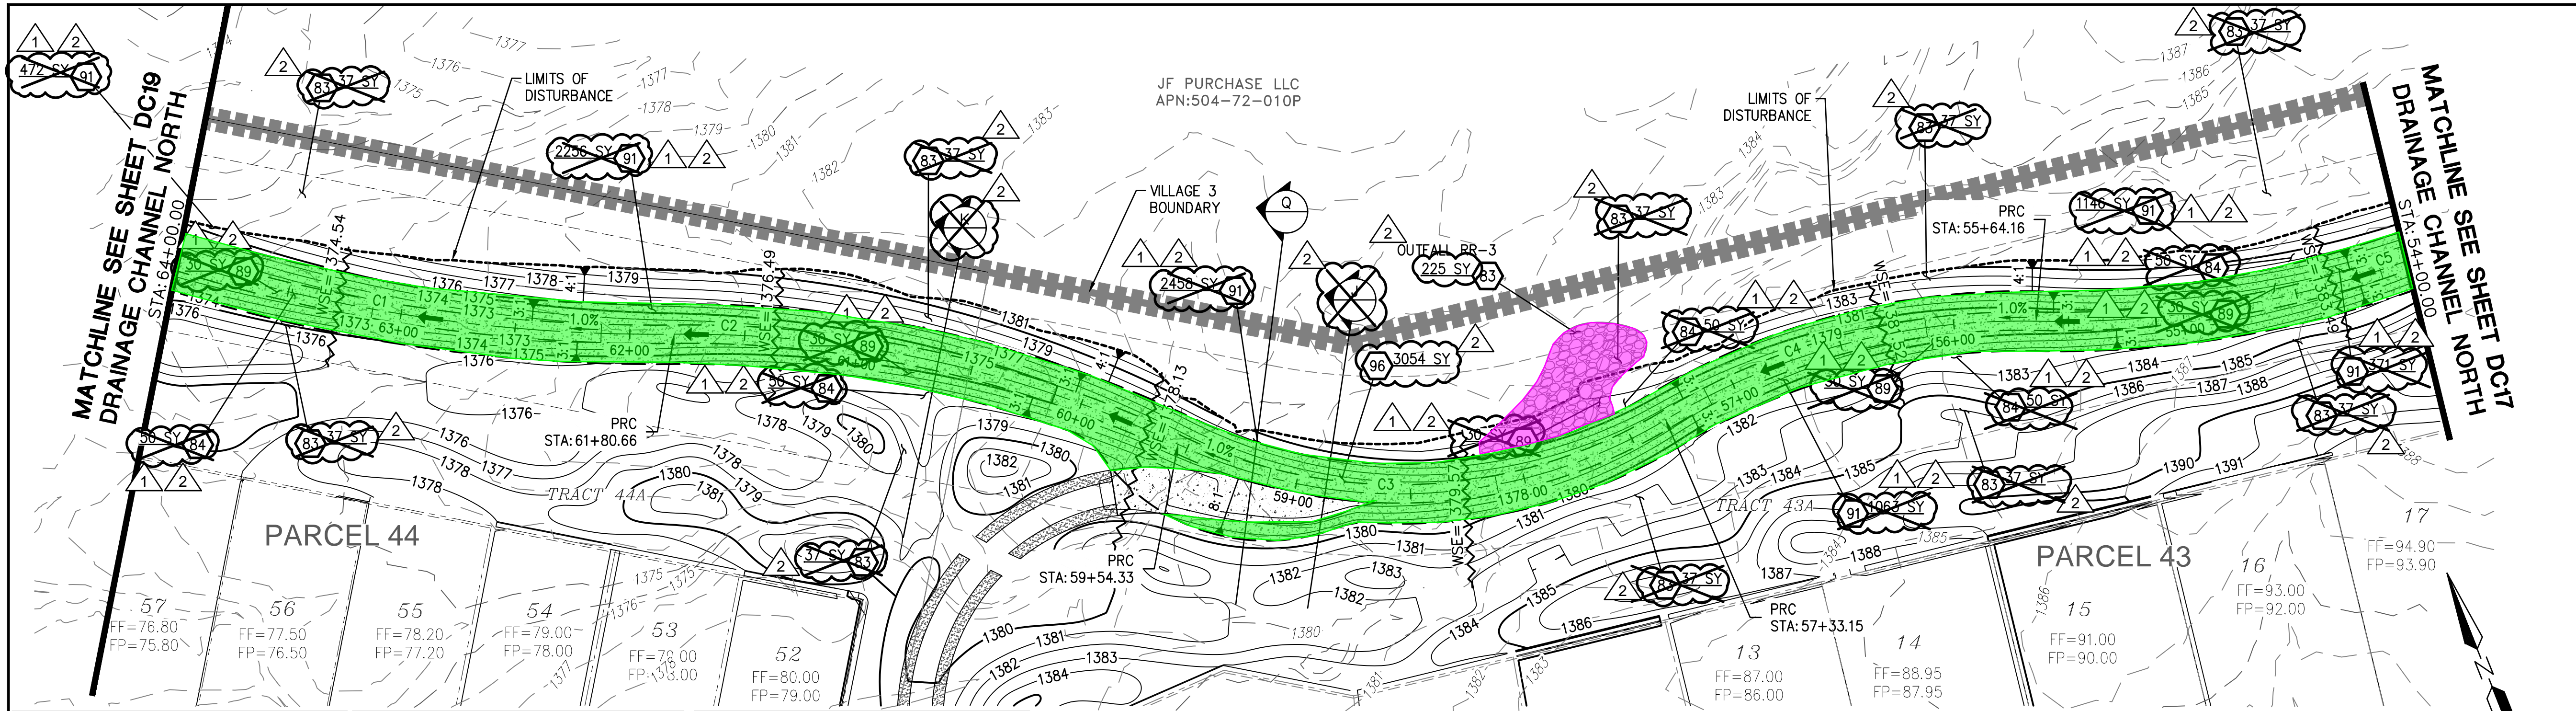


CURVE TABLE					CURVE TABLE					CURVE TABLE				
NO.	RADIUS	DELTA	LENGTH	TANGENT	NO.	RADIUS	DELTA	LENGTH	TANGENT	NO.	RADIUS	DELTA	LENGTH	TANGENT
C1	700.00'	024°26'05"	298.53'	151.57'	C3	225.00'	056°19'16"	221.17'	120.44'	C5	450.00'	028°07'59"	220.96'	112.75'
C2	500.00'	025°56'11"	226.34'	115.14'	C4	300.00'	032°16'31"	168.99'	86.80'					

DRAINAGE CHANNEL NORTH

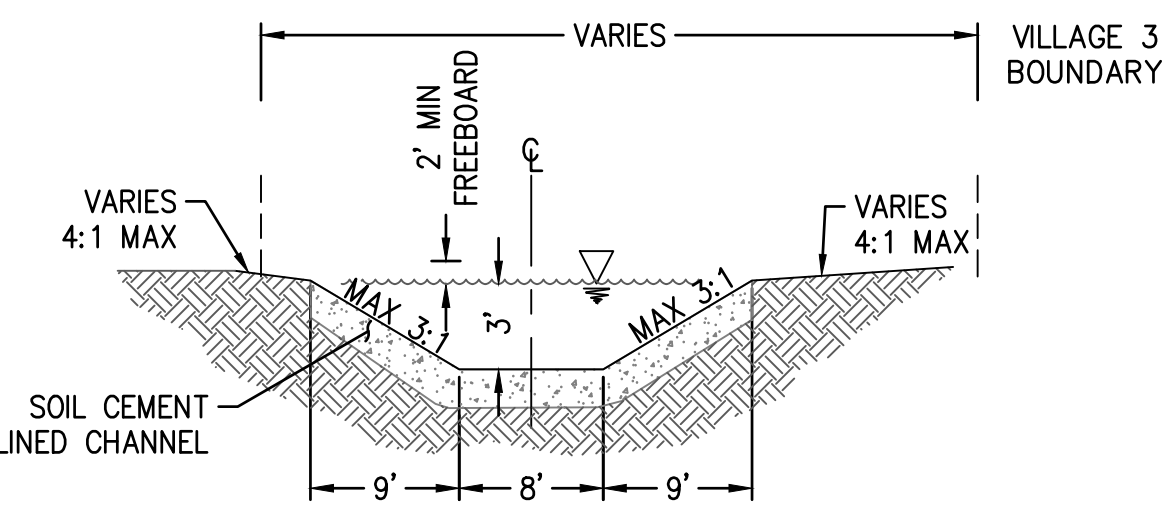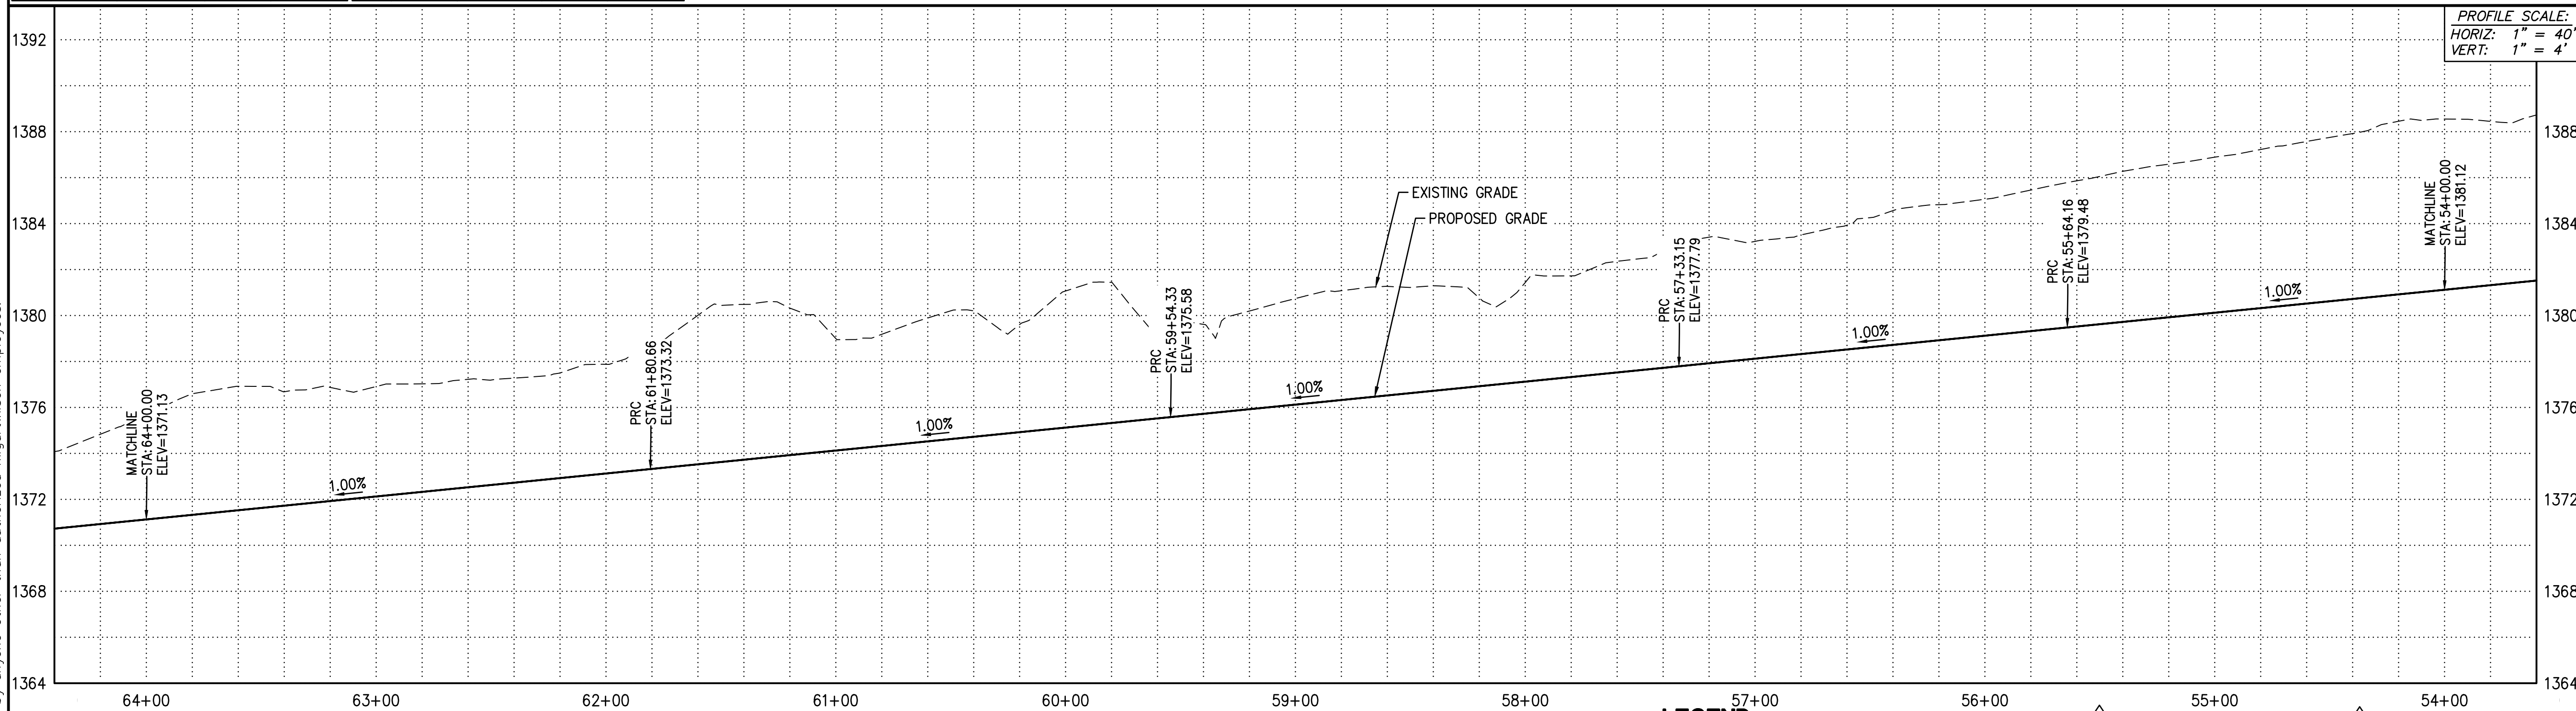


2 CHANNEL ALIGNMENT AND CHANNEL SECTION WIDTH CHANGED. SECTION J & K HAVE BEEN DELETED. GRADING AND WSE WERE REVISED. SOIL CEMENT AND GROUTED RIPRAP ADDED. DROP STRUCTURES WERE REMOVED.

- LEGEND**
- VILLAGE 3 BOUNDARY
 - EROSION HAZARD SETBACK
 - RIGHT OF WAY
 - LOT LINE
 - CENTER LINE
 - EASEMENT LINE
 - FLOW DIRECTIONAL INDICATOR
 - FINISH PAD ELEVATION (FINISH FLOOR IS 1' ABOVE FP)
 - EMERGENCY OUTFALL ARROW
 - HIGH POINT (HP)
 - LOW POINT (LP)
 - DUAL CHAMBER DRYWELL

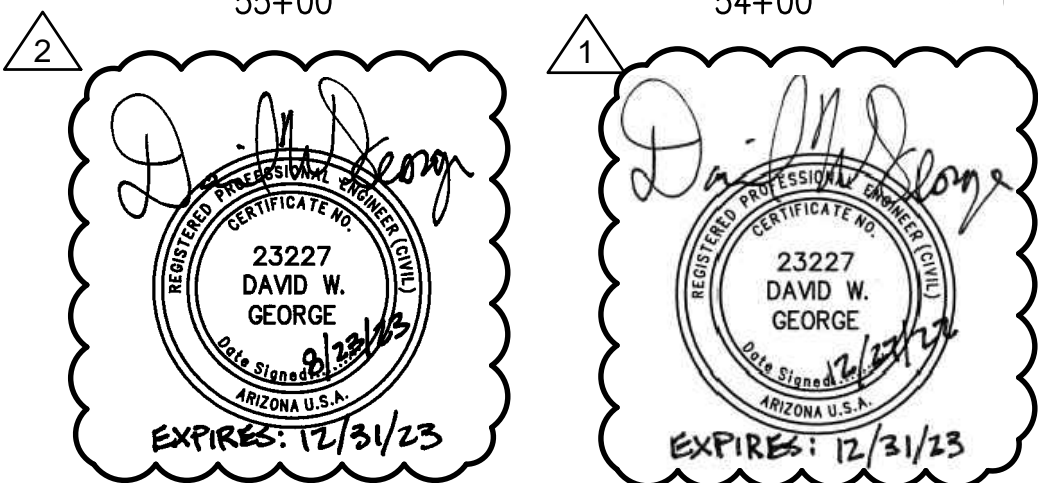

- STORM DRAIN CONSTRUCTION**
- 83 INSTALL LOOSE ANGULAR RIP-RAP PER MAG SPEC SEC. 220; D50=6", 12" THICK ON MIRAFI EROSION PROTECTION GEO-TEXTILE OR APPROVED EQUIVALENT. FABRIC TO HAVE APPARENT OPENING SIZE OF 0.425MM, PERMITTIVITY OF 50 GAL/MIN/FT AND WOVEN. SEE SHEET# DC21 FOR DETAIL AND PLAN SHEET FOR QUANTITY. COLOR PER DEVELOPER. 595 SY
 - 84 INSTALL GABIONS ON MACCAFERRI GEOTEXTILE MACTEX N47.1. PER DETAILS SEE SHEET# DC21. 250 SY
 - 89 INSTALL 2" OF SHOTCRETE ON TOP OF GABION BASKET WITH D50=6" EMBEDDED IN SHOTCRETE. 150 SY
 - 91 INSTALL ANGULAR LOOSE RIP-RAP PER MAG SPEC SECTION 220 D50=4" 6" THICK ON MIRAFI EROSION PROTECTION GEO-TEXTILE OR APPROVED EQUIVALENT. FABRIC TO HAVE APPARENT OPENING SIZE OF 0.425MM, PERMITTIVITY OF 50 gal/min/ft AND WOVEN. SPECIFIC WEIGHT = 165 lb/ft³. GRADATION PER TABLE 6.4 OF 2018 DRAINAGE DESIGN MANUAL FOR MARICOPA COUNTY, ARIZONA (HYDRAULICS). 7766 SY
 - 96 INSTALL SOIL CEMENT PER MAG SPEC 311; SEE DETAIL 1 ON SHEET DC21. 3054 SY
- NOTE: THE SCOUR DEPTH AT THE GABION STRUCTURE IS 0 AND THE THALWEG ELEVATION IS THE SAME AS THE BOTTOM ELEVATION LABELED IN THE PROFILE.

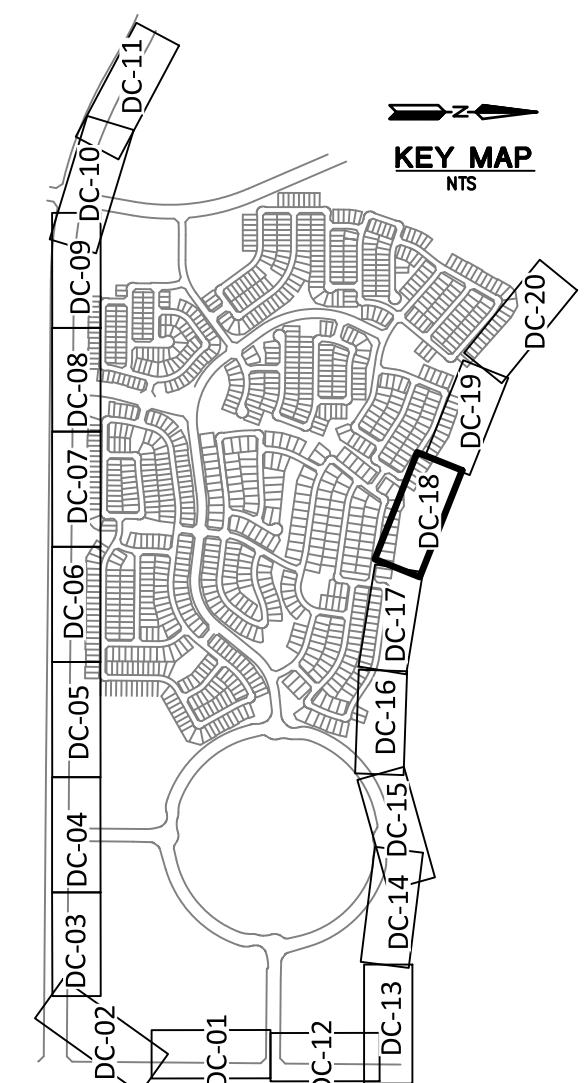

REVISIONS:

1	12/27/2022 - ROSEWOOD AVENUE WAS EXTENDED AND GRADING REVISED. CHANNEL WAS REVISED ALONG SUN VALLEY PARKWAY TO ACCOMMODATE AN ADDED SIDEWALK. GRADING FOR APS SUBSTATION ADDED & FIRE STATION. THE EROSION HAZARD SETBACK ALONG WAGNER WASH WAS REVISED.
2	8/23/2023 - REVISION TO CHANNEL ALIGNMENT AND REPLACE RIPRAP WITH SOIL CEMENT.

PLAN NAME
TRILLIUM VILLAGE 3 - UNITS 1 & 2 DRAINAGE CHANNEL PLAN

ENGINEER INFORMATION
HILGARTWILSON

COB PERMITTING APPROVED SEAL	COB ENGINEERING APPROVED SEAL
	APPROVED
	6/22/2022
	CITY OF BUCKEYE ENGINEERING
AS-BUILT SEAL	DESIGN SEAL
	23227 DAVID W. GEORGE
	EXPIRES: 12/31/23
ORIGINAL PLAN DATE	LATEST REVISION DATE
MAY 2022	AUG 2023
PROJECT NUMBER	SHEET NUMBER
1175	87 OF 90
DC18	

COB PLAN TRACKING # ENG-21-0220
COB PERMIT # 3R Submittal

Copyright, Hilgartwilson - This plan document set is the sole property of Hilgartwilson. No alterations to these plans, other than adding "as-built" information, are allowed by anyone other than authorized Hilgartwilson employees.

Copyright, Hilgartwilson - This plan document set is the sole property of Hilgartwilson. No alterations to these plans, other than adding "as-built" information, are allowed by anyone other than authorized Hilgartwilson employees.

MATCHLINE SEE SHEET DC20
DRAINAGE CHANNEL NORTH

DRAINAGE CHANNEL NORTH
MATCHLINE SEE SHEET DC18

LINE TABLE			CURVE TABLE					CURVE TABLE				
NO.	DIRECTION	LENGTH	NO.	RADIUS	DELTA	LENGTH	TANGENT	NO.	RADIUS	DELTA	LENGTH	TANGENT
L1	N70°15'07"W	137.68'	C1	700.00'	024°26'05"	298.53'	151.57	C4	600.00'	008°55'01"	93.38'	46.78
			C2	300.00'	040°45'06"	213.38'	111.43	C5	200.00'	011°32'20"	40.28'	20.21
			C3	400.00'	023°55'22"	167.01'	84.74	C6	300.00'	024°50'25"	130.06'	66.07


DRAINAGE CHANNEL NORTH

40 20 0 40 80
SCALE: 1" = 40'

PROFILE SCALE:
HORIZ: 1" = 40'
VERT: 1" = 4'

LEGEND


- VILLAGE 3 BOUNDARY
- EROSION HAZARD SETBACK
- RIGHT OF WAY
- LOT LINE
- CENTER LINE
- EASEMENT LINE
- FLOW DIRECTIONAL INDICATOR
- FINISH PAD ELEVATION (FINISH FLOOR IS 1' ABOVE FP)
- EMERGENCY OUTFALL ARROW
- (HP) HIGH POINT
- (LP) LOW POINT
- DUAL CHAMBER DRYWELL

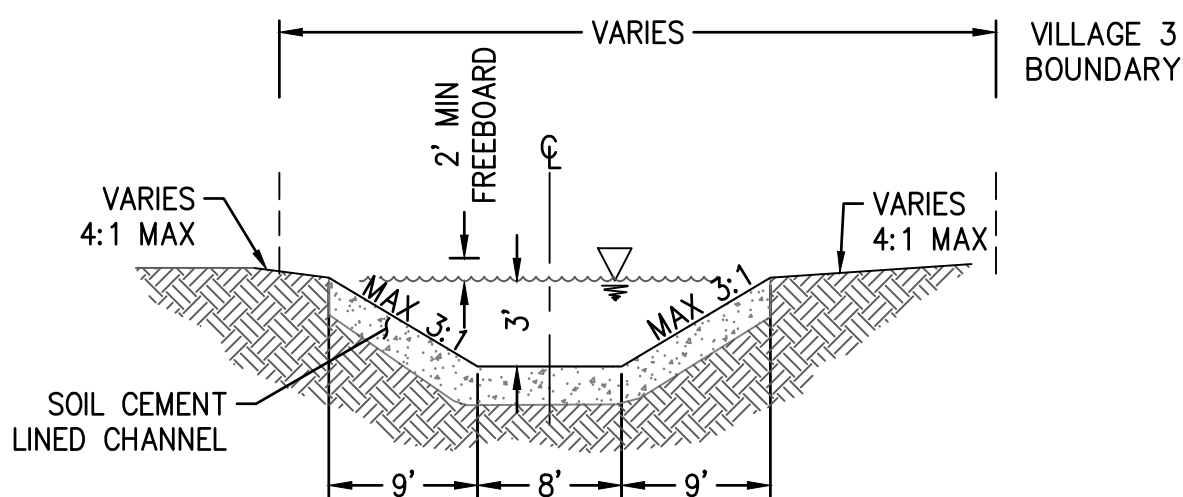

TYPICAL DRAINAGE
SECTION-NORTH


NTS

CHANNEL ALIGNMENT AND CHANNEL SECTION WIDTH CHANGED. SECTION J & K HAVE BEEN DELETED. GRADING AND WSE WERE REVISED. SOIL CEMENT AND GROUTED RIPRAP ADDED. DROP STRUCTURES WERE REMOVED.

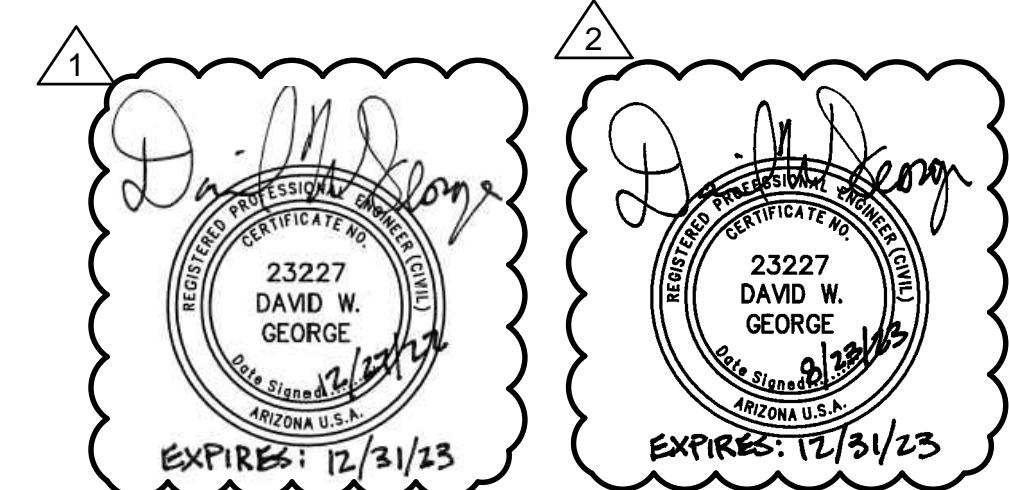

STORM DRAIN CONSTRUCTION

- INSTALL LOOSE ANGULAR RIP-RAP PER MAG SPEC SEC. 220; D50=6", 12" THICK ON MIRAFI EROSION PROTECTION GEO-TEXTILE OR APPROVED EQUIVALENT. FABRIC TO HAVE APPARENT OPENING SIZE OF 0.425MM, PERMITTIVITY OF 50 GAL/MIN/FT AND WOVEN. SEE SHEET# DC21 FOR DETAIL AND PLAN SHEET FOR QUANTITY. COLOR PER DEVELOPER. 384 SY
- INSTALL GABIONS ON MACCAFERRI GEOTEXTILE MASTEX N47.1. PER DETAILS SEE SHEET# DC21. 50 SY
- INSTALL 2" OF SHOTCRETE ON TOP OF GABION BASKET WITH D50=6" EMBEDDED IN SHOTCRETE. 30 SY
- INSTALL ANGULAR LOOSE RIP-RAP PER MAG SPEC SECTION 220 D50=6" THICK ON MIRAFI EROSION PROTECTION GEO-TEXTILE OR APPROVED EQUIVALENT. FABRIC TO HAVE APPARENT OPENING SIZE OF 0.425MM, PERMITTIVITY OF 50 gal/min/ft and woven. SPECIFIC WEIGHT 165 lb/H3. GRADATION PER TABLE 6.4 OF 2013 DRAINAGE DESIGN MANUAL FOR MARICOPA COUNTY, ARIZONA (HYDRAULICS). 5389 SY
- INSTALL SOIL CEMENT PER MAG SPEC 311; SEE DETAIL 1 ON SHEET DC21. 2600 SY
- PLACE GROUTED RIP-RAP D50=15", THICKNESS 30" ON FILTER FABRIC, MIRAFI EROSION PROTECTION GEO-TEXTILE OR APPROVED EQUIVALENT. COLOR PER DEVELOPER'S REPRESENTATIVE. 63 SY

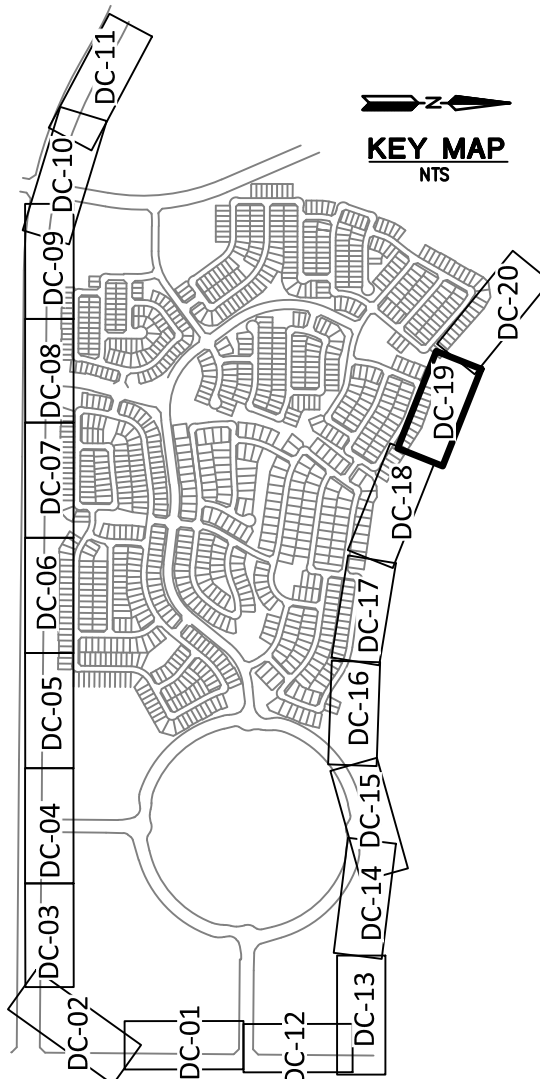

REVISIONS:

- 12/27/2022 - ROSEWOOD AVENUE WAS EXTENDED AND GRADING REVISED. CHANNEL WAS REVISED ALONG SUN VALLEY PARKWAY TO ACCOMMODATE AN ADDED SIDEWALK. GRADING FOR APS SUBSTATION ADDED & FIRE STATION. THE EROSION HAZARD SETBACK ALONG WAGNER WASH WAS REVISED.
- 8/23/2023 - REVISION TO CHANNEL ALIGNMENT AND REPLACE RIPRAP WITH SOIL CEMENT.


PLAN NAME

**TRILLIUM
VILLAGE 3 - UNITS 1 & 2
DRAINAGE CHANNEL PLAN**

ENGINEER INFORMATION


HILGARTWILSON		SUBMITTAL: 3R Submittal
COB PERMITTING APPROVED SEAL	COB ENGINEERING APPROVED SEAL 6/22/2022 CITY OF BUCKEYE ENGINEERING	
AS-BUILT SEAL	DESIGN SEAL 23227 DAVID W. GEORGE EXPIRES: 12/31/23	COB PLAN TRACKING # ENG-21-0220 COB PERMIT #
ORIGINAL PLAN DATE MAY 2022	LATEST REVISION DATE AUG 2023	
PROJECT NUMBER 1175	SHEET NUMBER DC19 88 OF 90	

Copyright, Hilgartwilson. This plan document set is the sole property of Hilgartwilson. No alterations to these plans, other than adding "as-built" information, are allowed by anyone other than authorized Hilgartwilson employees.

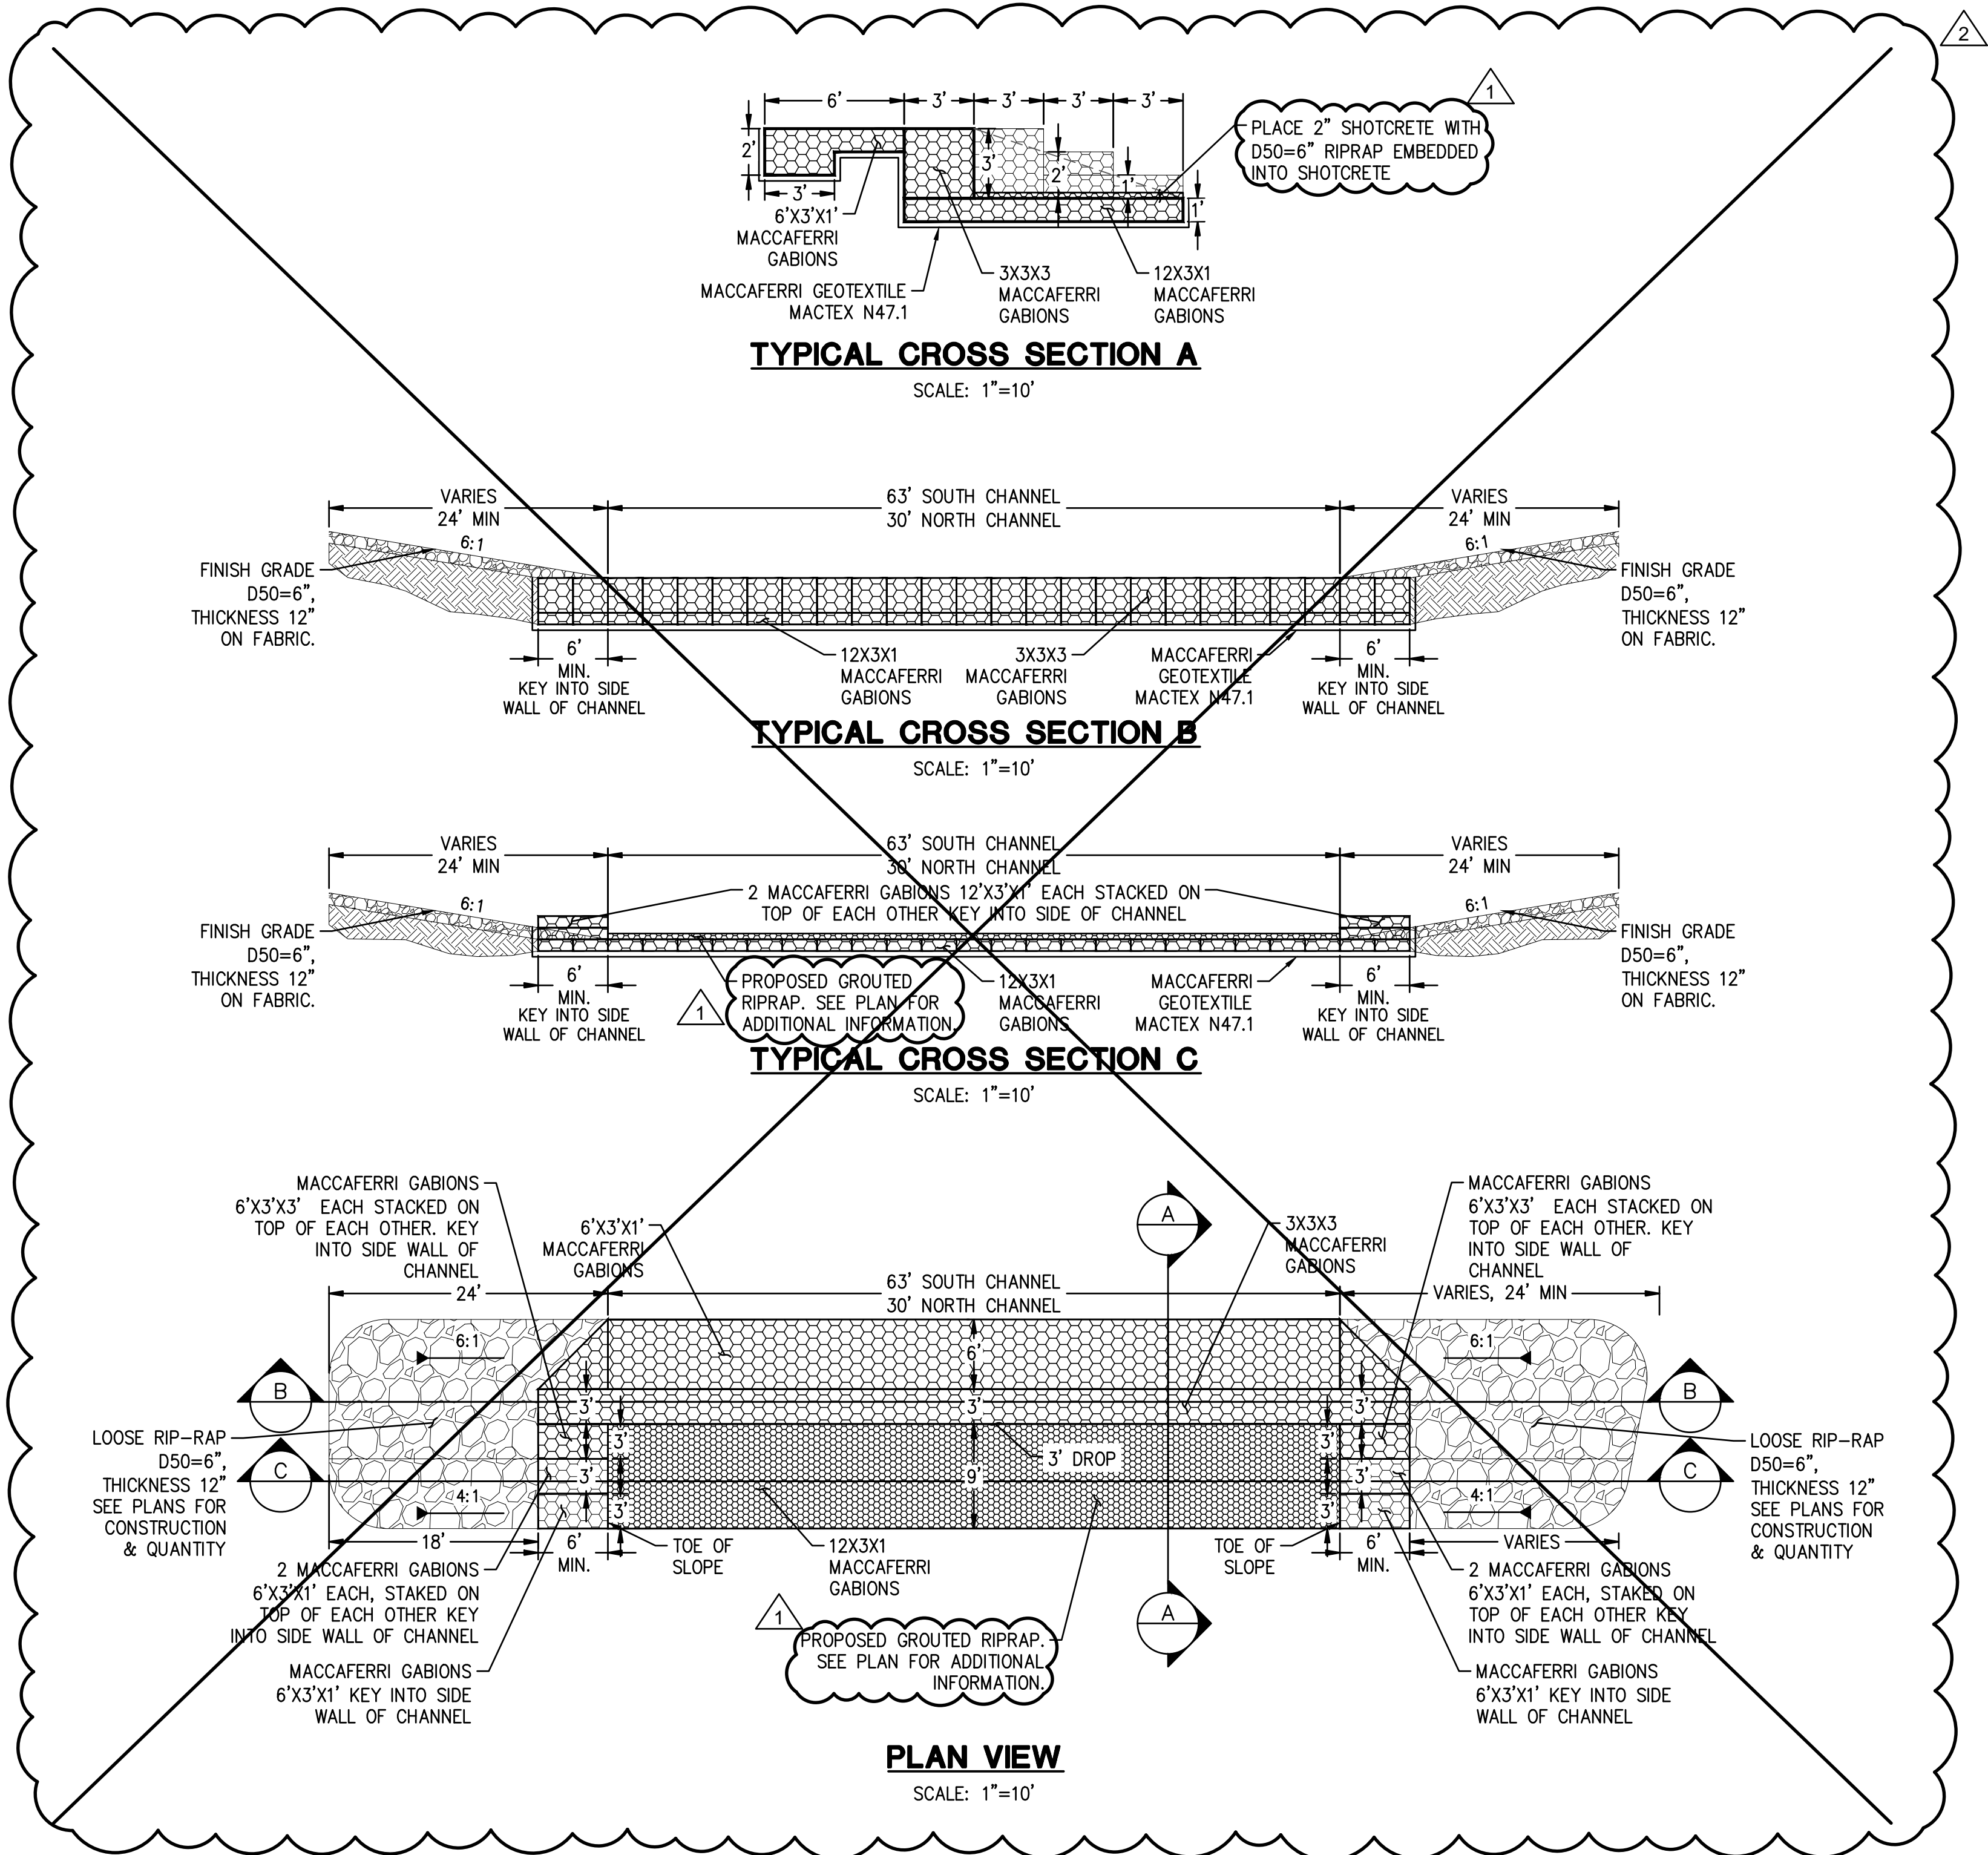

**TABLE 6.4
RIPRAP GRADATION LIMITS**

STONE SIZE RANGE (FT)	STONE WEIGHT RANGE (LB)	PERCENT OF GRADATION SMALLER THAN
1.5 d50 TO 1.7 d50	3.0 W50 TO 5.0 W50	100
1.2 d50 TO 1.4 d50	2.0 W50 TO 2.75 W50	85
1.0 d50 TO 1.15 d50	1.0 W50 TO 1.5 W50	50
0.4 d50 TO 0.6 d50	0.1 W50 TO 0.2 W50	15

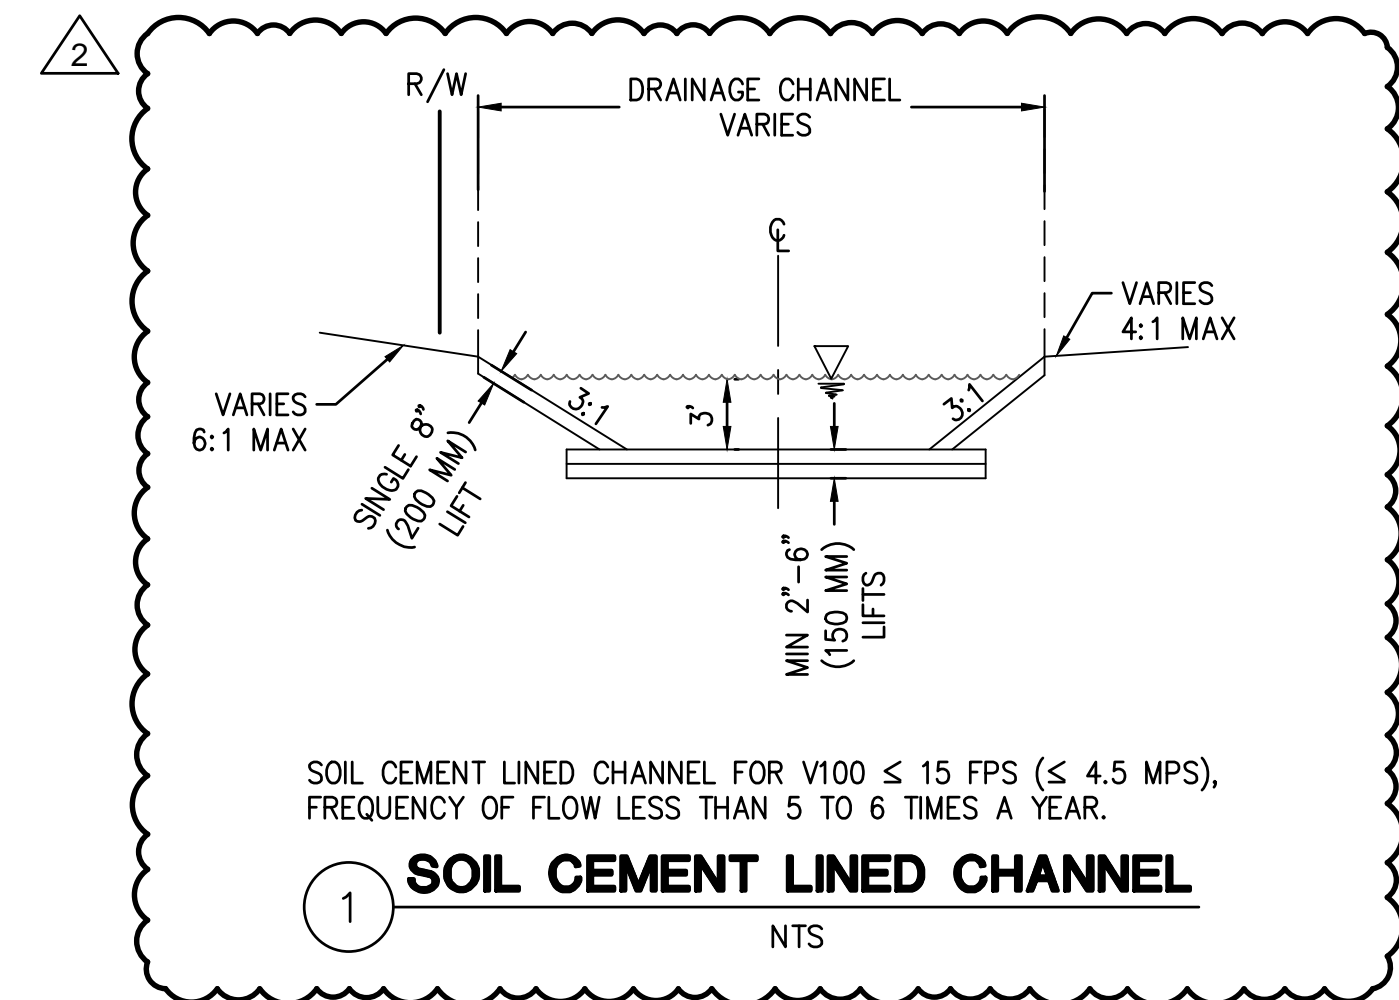

REVISIONS:

12/27/2022 – ROSEWOOD AVENUE WAS EXTENDED AND GRADING REVISED. CHANNEL WAS REVISED ALONG SUN VALLEY PARKWAY TO ACCOMMODATE AN ADDED SIDEWALK. GRADING FOR APS SUBSTATION ADDED & FIRE STATION. THE EROSION HAZARD SETBACK ALONG WAGNER WASH WAS REVISED.

8/23/2023 – REVISION TO CHANNEL ALIGNMENT AND REPLACE RIPRAP WITH SOIL CEMENT.

PLAN NAME
**TRILLIUM
VILLAGE 3 - UNITS 1 & 2
DRAINAGE CHANNEL PLAN**

ENGINEER INFORMATION
HILGARTWILSON

COB PERMITTING APPROVED SEAL
COB ENGINEERING APPROVED SEAL
APPROVED
6/22/2022
CITY OF BUCKEYE ENGINEERING

AS-BUILT SEAL
DESIGN SEAL
23227
DAVID W. GEORGE
EXPIRES: 12/31/23

ORIGINAL PLAN DATE
MAY 2022
LATEST REVISION DATE
AUG 2023

PROJECT NUMBER
1175
SHEET NUMBER
DC21
SHT.
90 OF 90

SUBMITTAL:
3R Submittal

COB PLAN TRACKING #
ENG-21-0220

COB PERMIT #

