








STATE OF ARIZONA
DEPARTMENT OF TRANSPORTATION
PROJECT DELIVERY AND OPERATIONS DIVISION
PROJECT PLANS

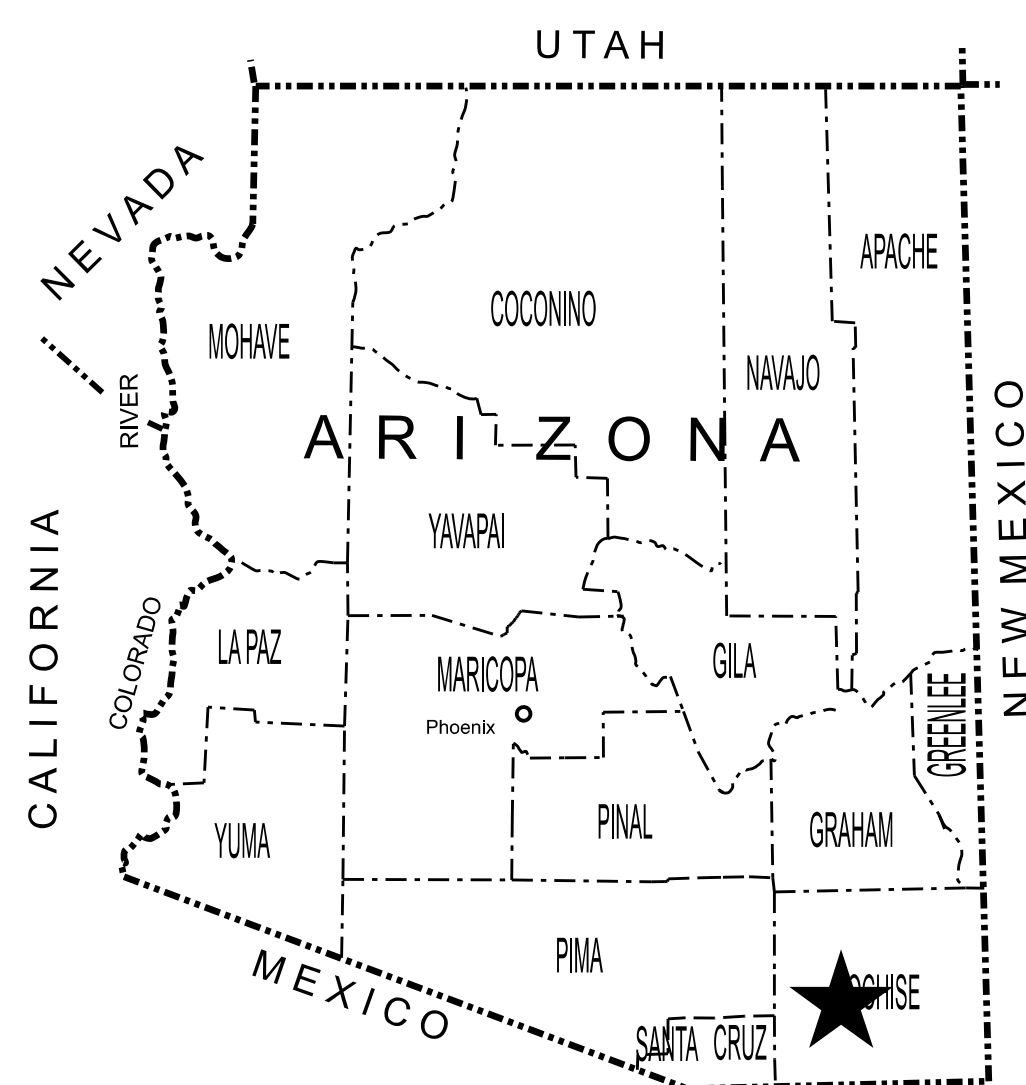

STATE HIGHWAY
NOGALES - TOMBSTONE HIGHWAY
SR 82

ROADWAY STAGE V CROSS SECTIONS
SAN PEDRO RIVER BRIDGE
PROJECT NO. 082 CH 061 F0522 01C
FEDERAL AID NO. FA 082-A(210)T

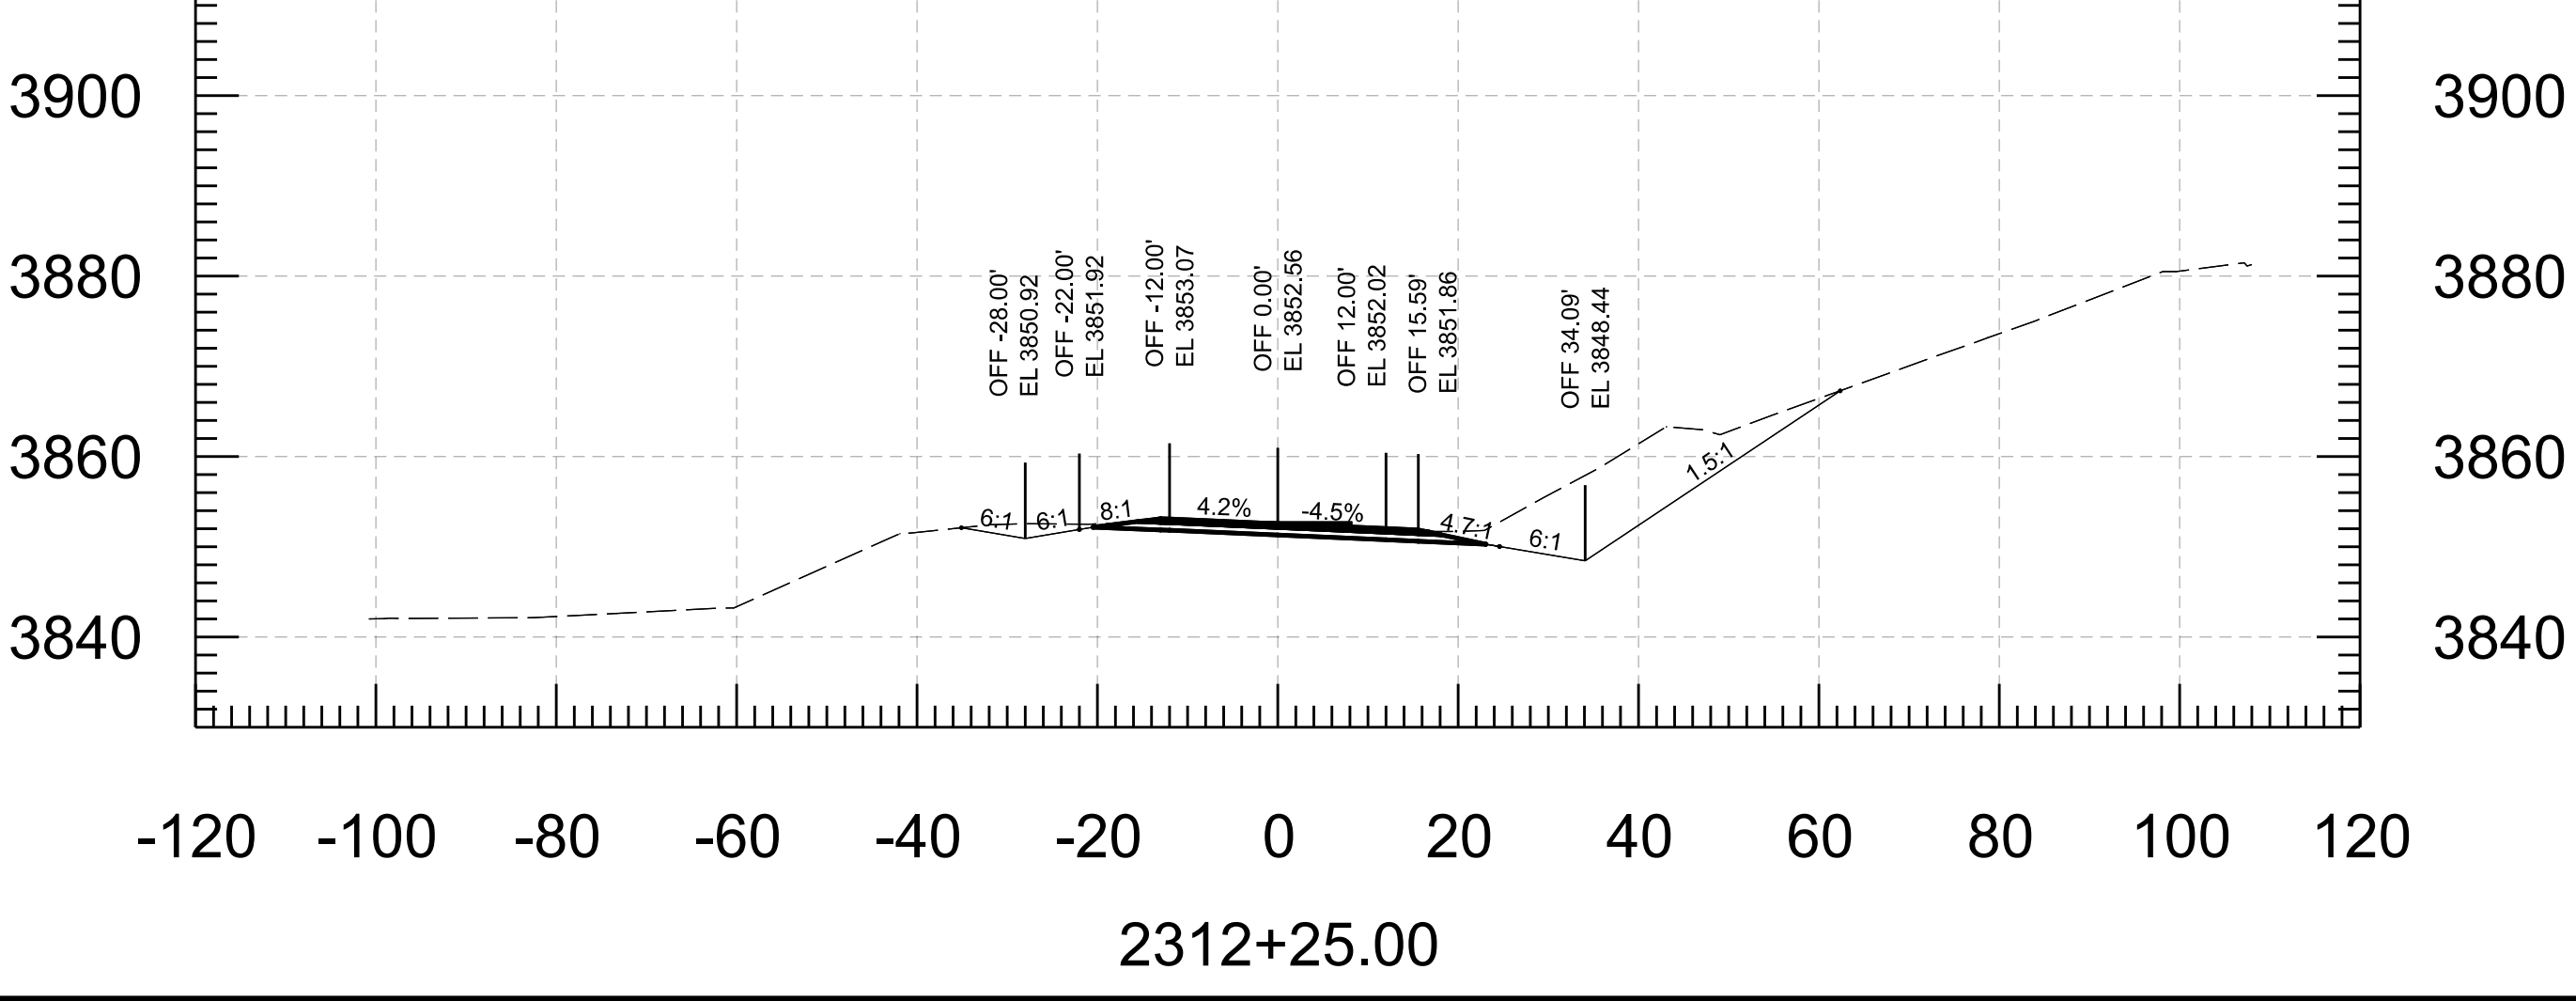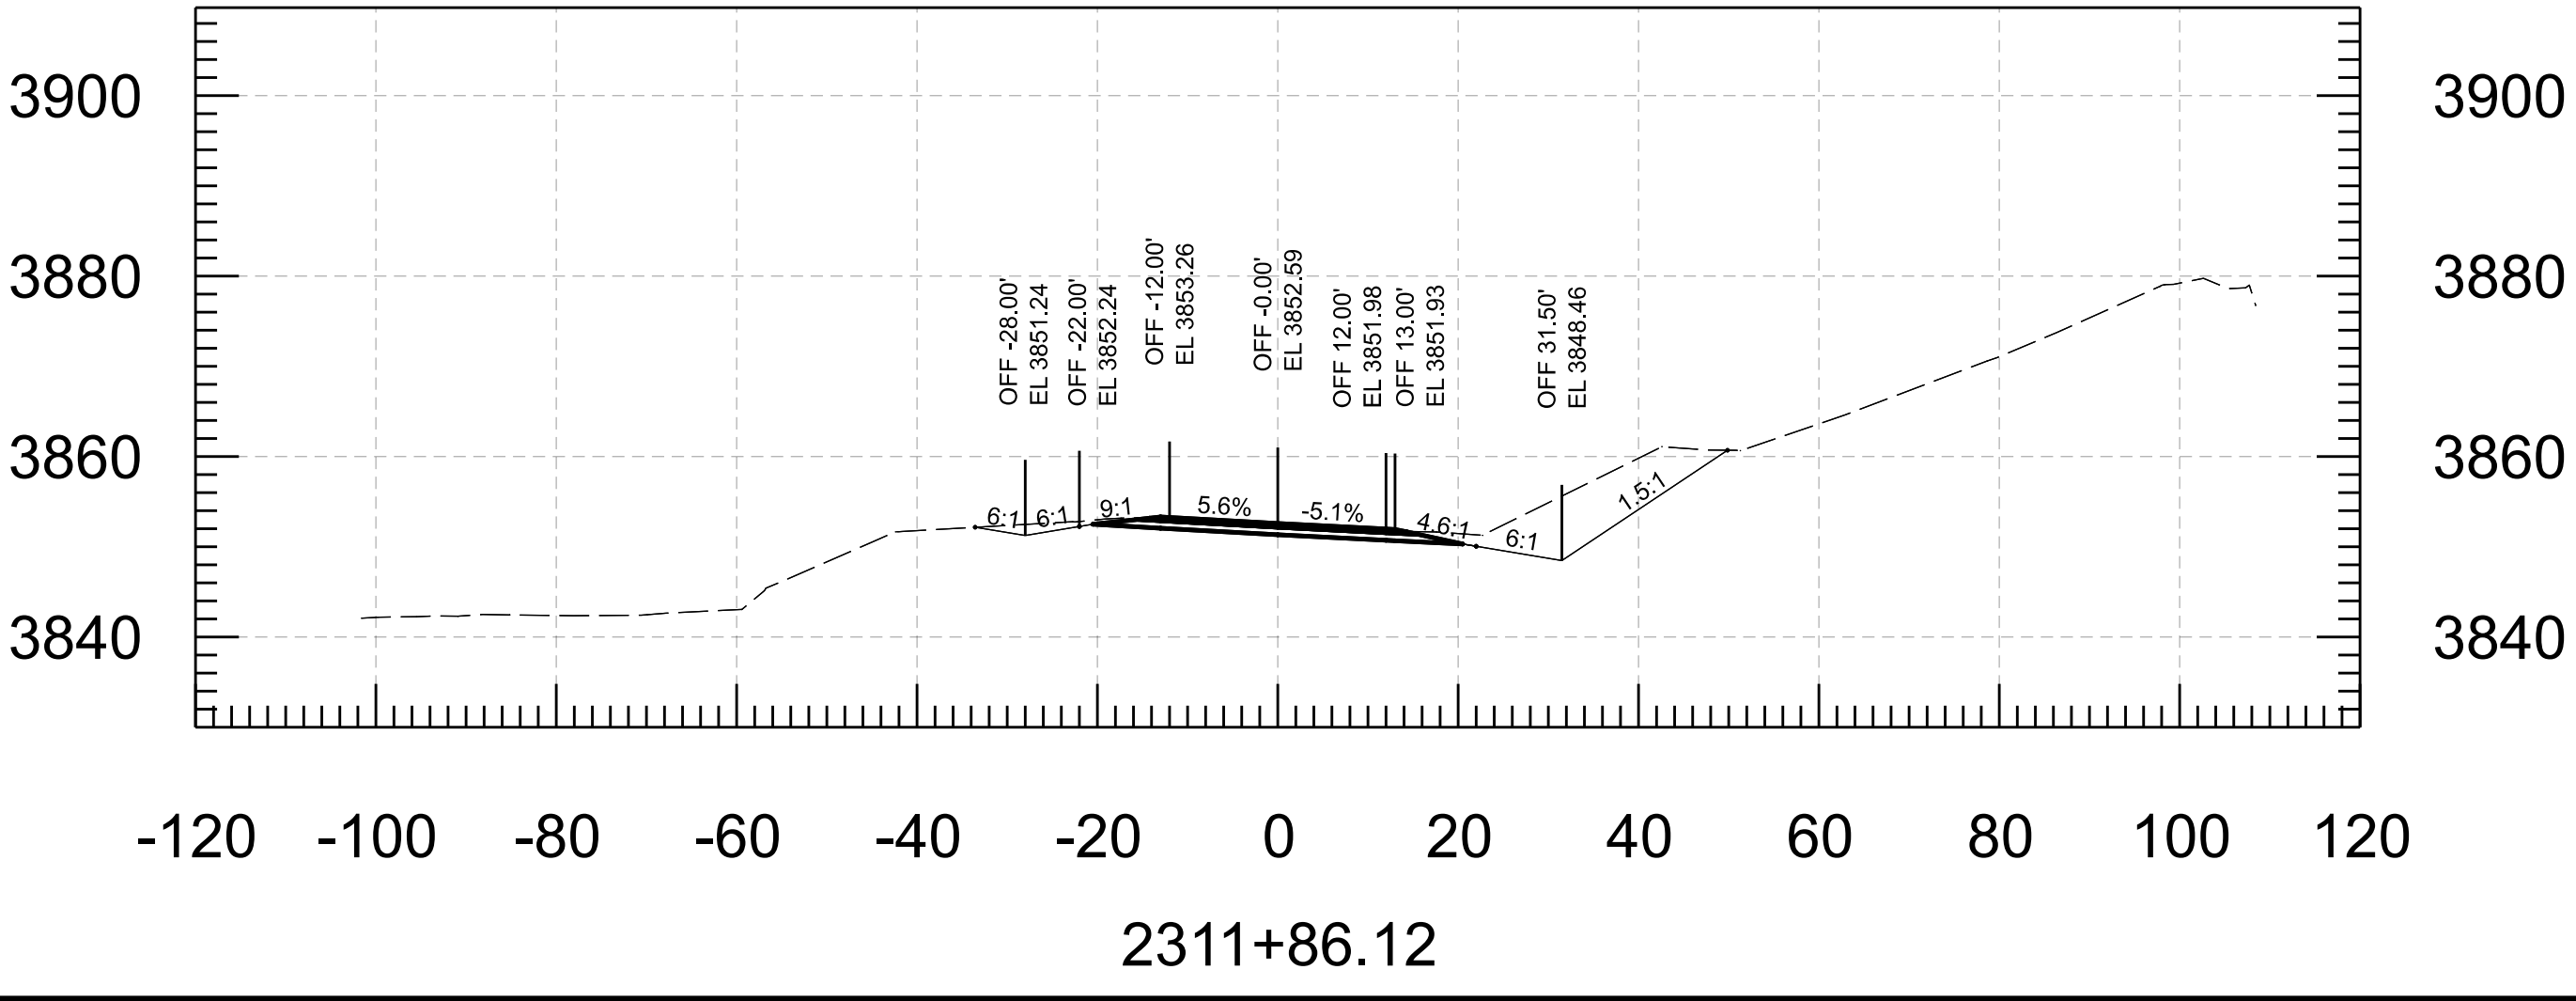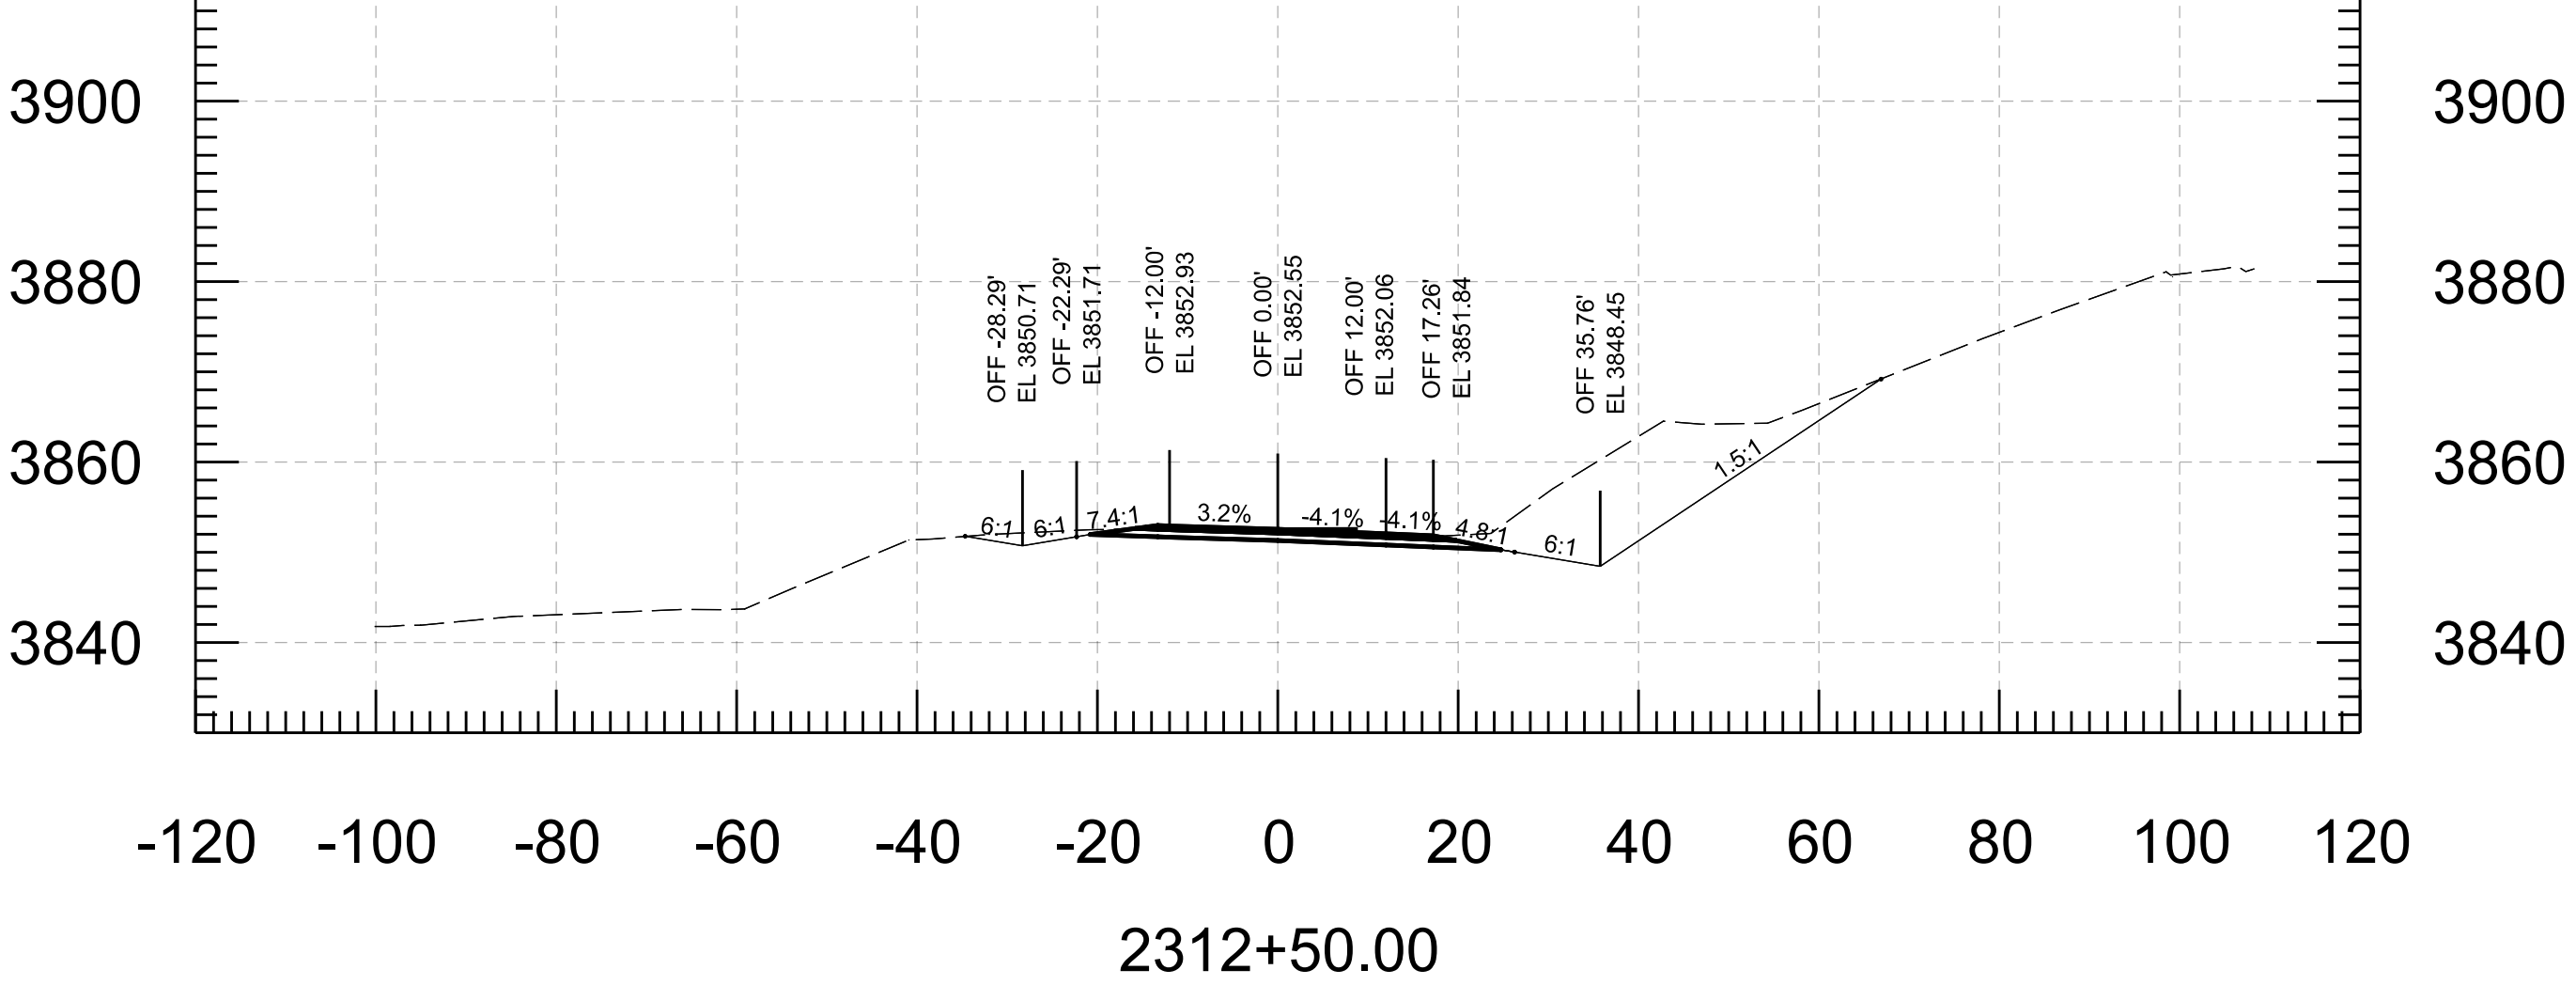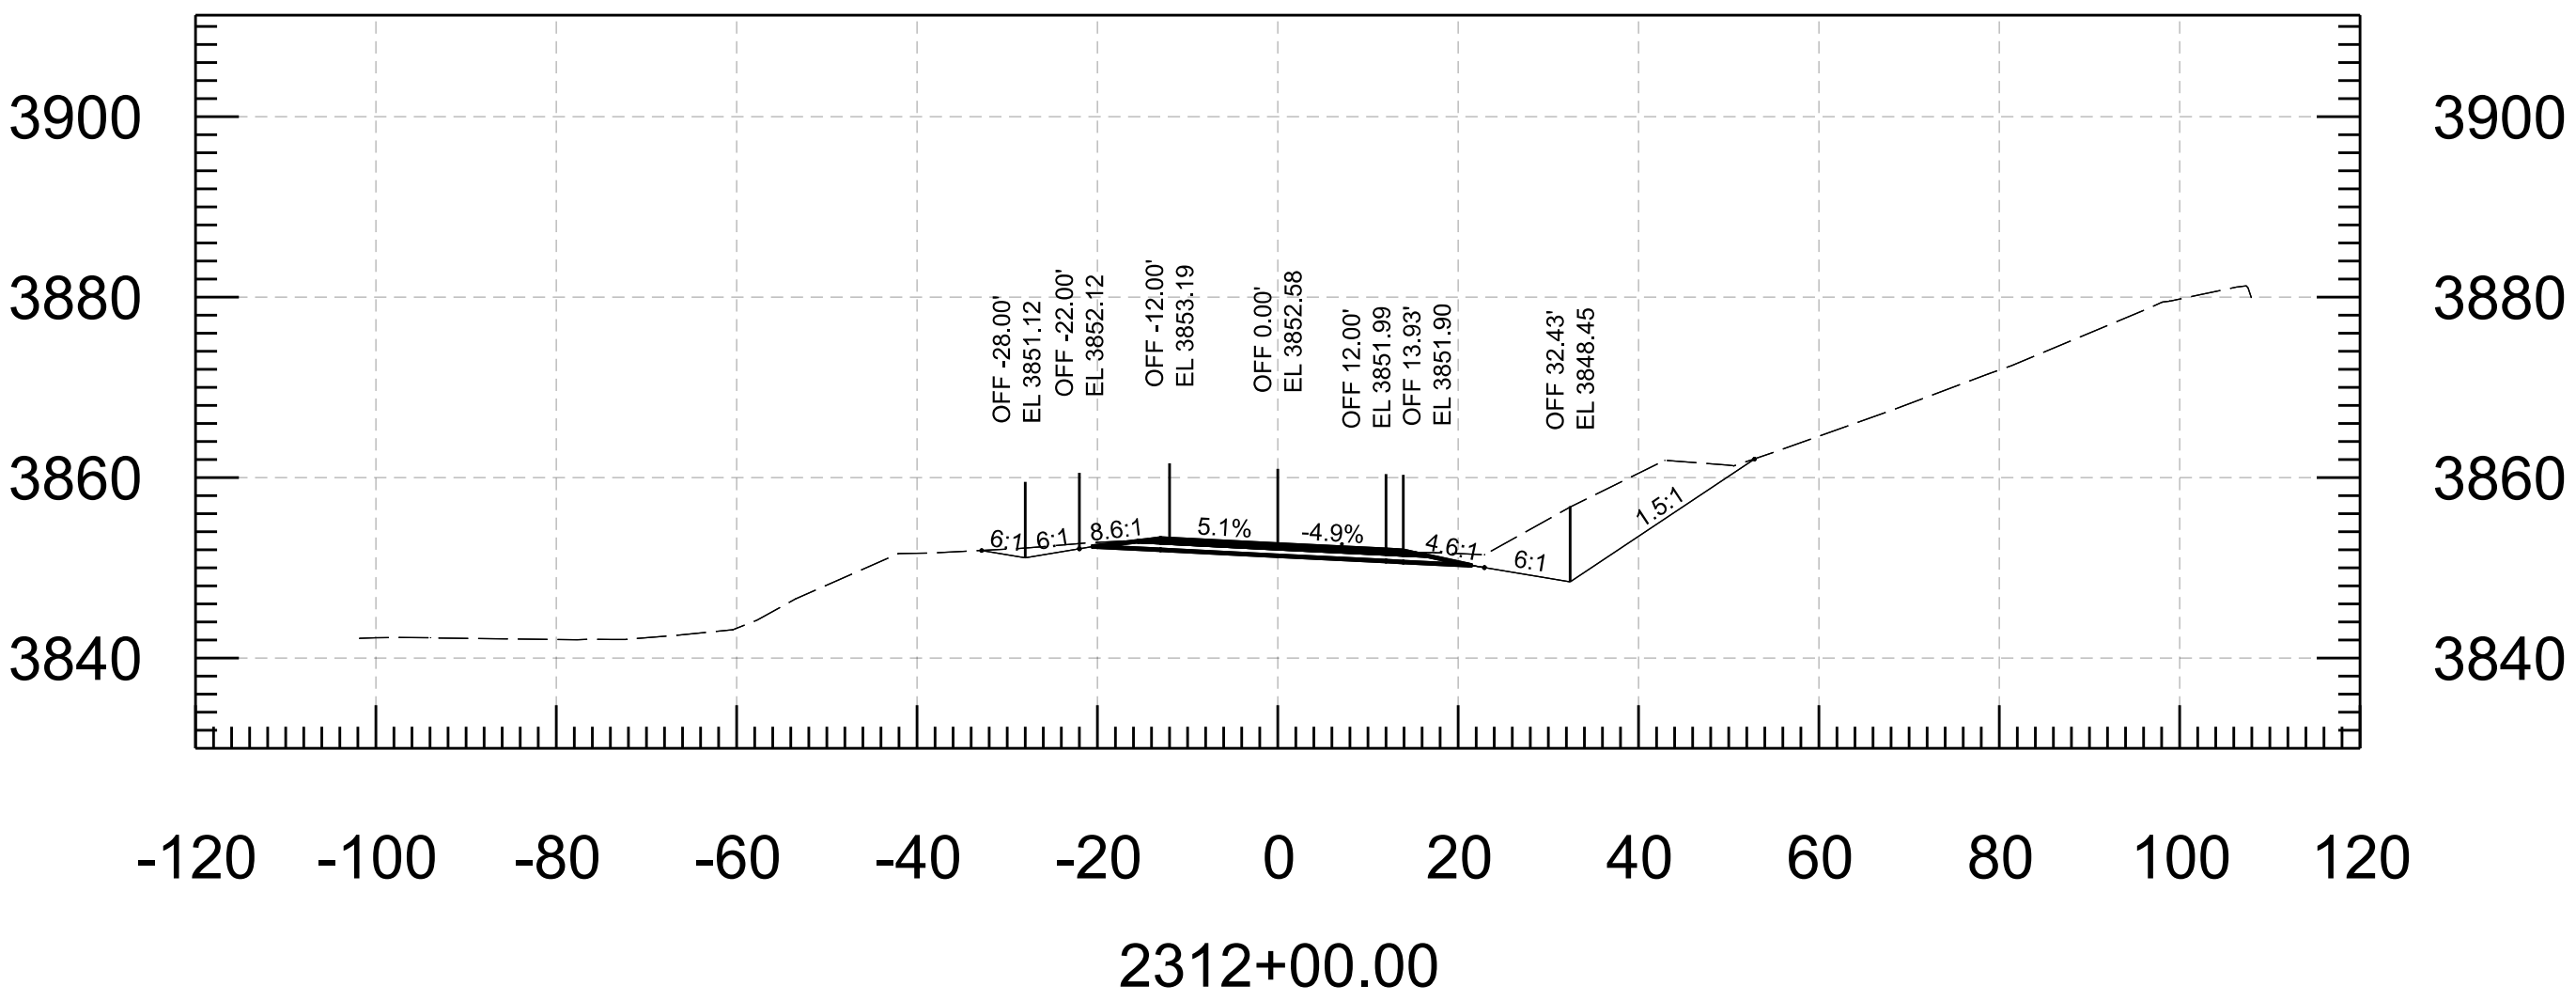

PRELIMINARY
STAGE V
Review
NOT FOR
CONSTRUCTION
OR RECORDING

	NAME	DATE
DESIGN	I. BYSTROV	3/26
DRAWN	P. MEEK	3/26
CHECKED	E. EGGEN	3/26
TEAM LEADER	E. EGGEN	3/26

ARIZONA DEPARTMENT OF TRANSPORTATION
PROJECT DELIVERY AND OPERATIONS DIVISION
ROADWAY DESIGN SECTION

CROSS SECTIONS

ROUTE
SR 82

MILEPOST

STRUCTURE NO.

F.H.W.A. Arizona Division

STATE
ARIZ.

PROJECT NO.
082 CH 061

FEDERAL ID NO.
082-A(210)T

SHEET
NO.
1




TOTAL
SHEETS
9

RECORD DRAWING




LOCATION
SAN PEDRO RIVER BRIDGE NO. 20310

TRACS NO. **F0522 01C**

SHEET
OF
___ OF ___

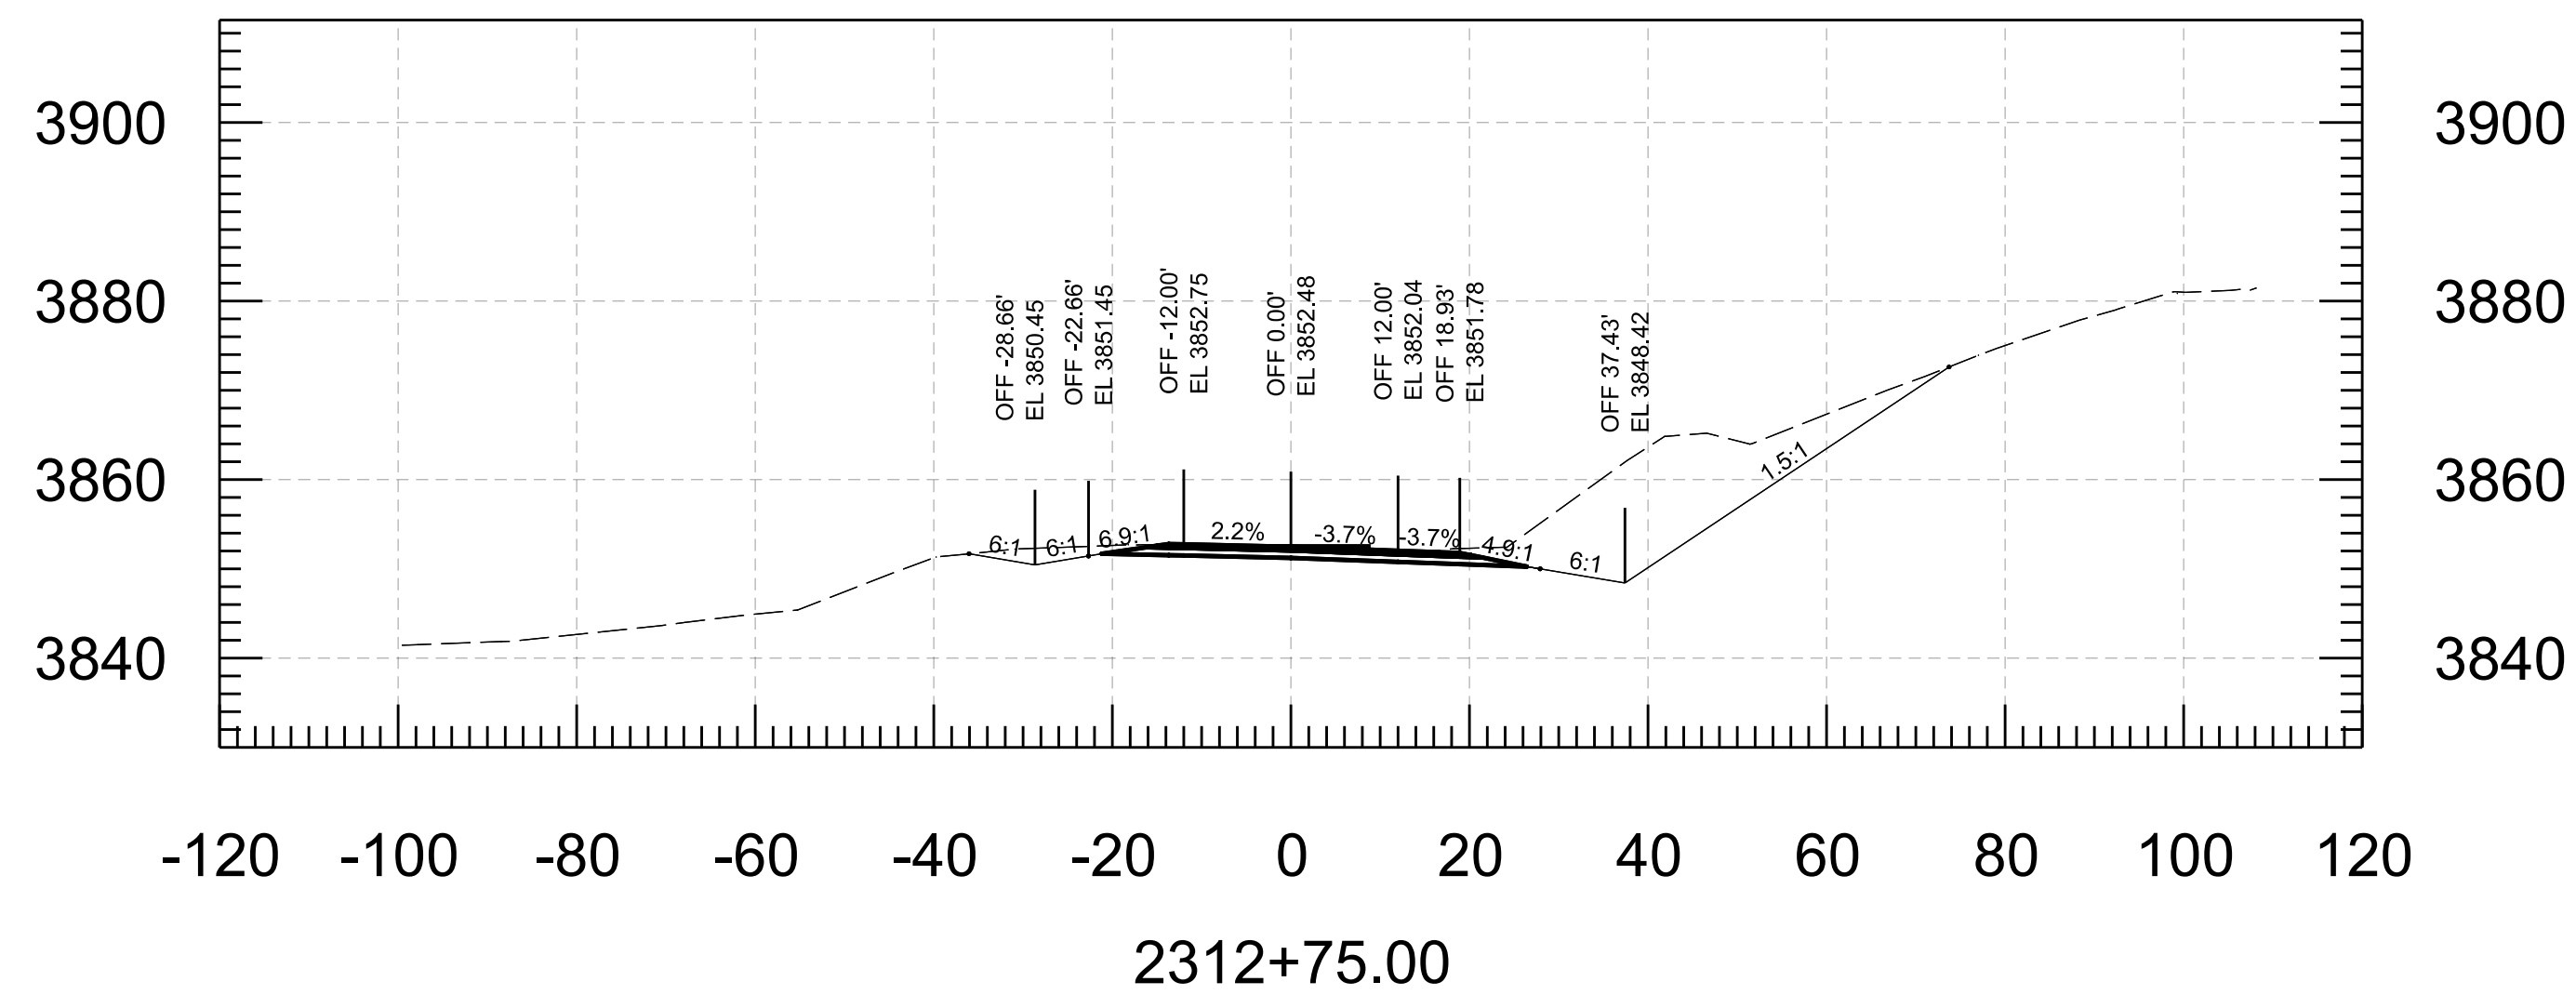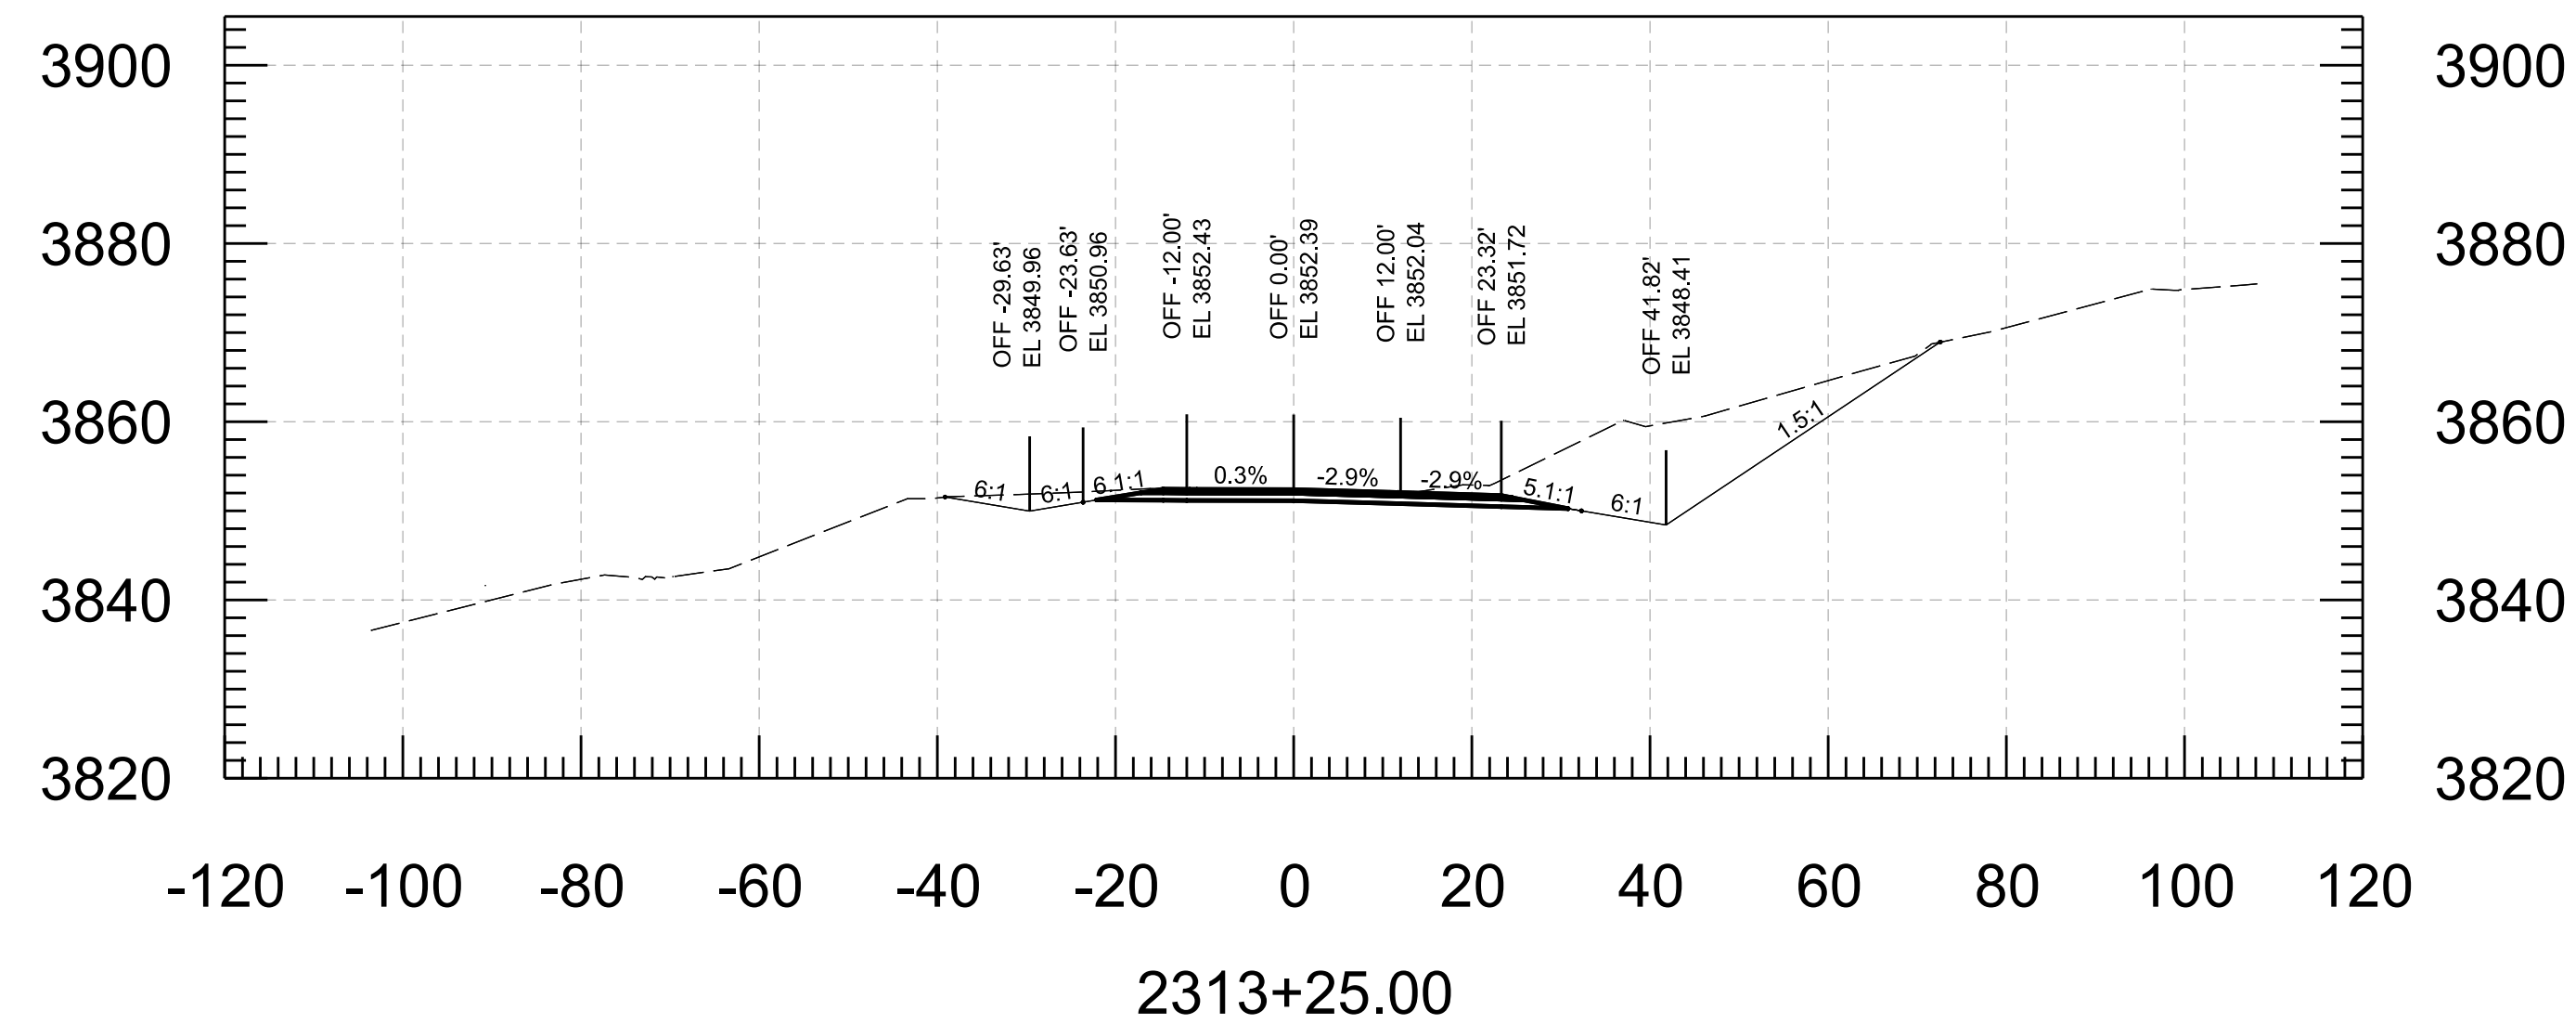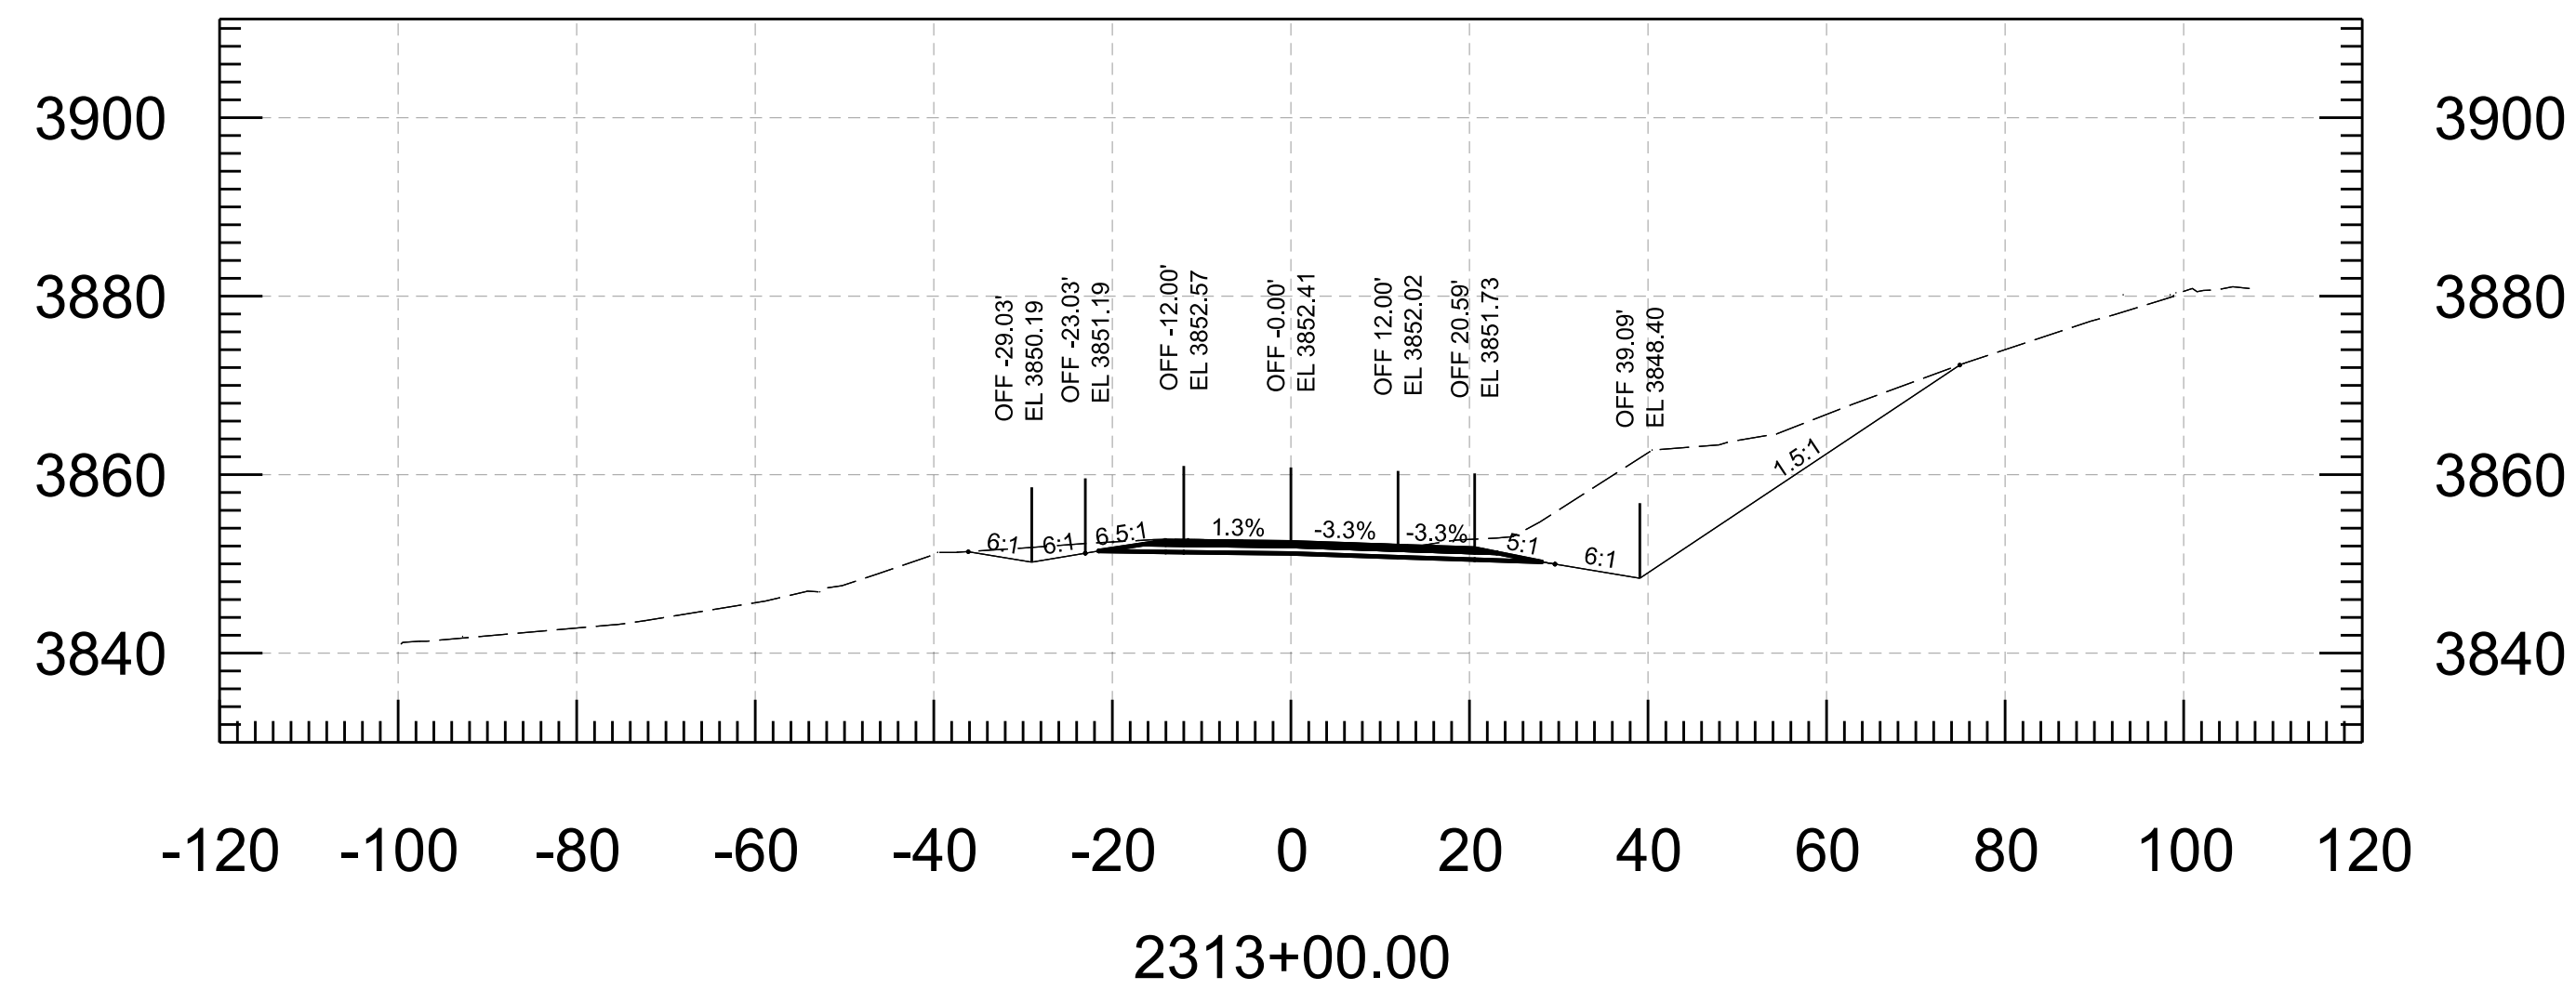

	PRELIMINARY STAGE V Review NOT FOR CONSTRUCTION OR RECORDING		NAME	DATE	ARIZONA DEPARTMENT OF TRANSPORTATION PROJECT DELIVERY AND OPERATIONS DIVISION ROADWAY DESIGN SECTION	ROUTE	F.H.W.A. Arizona Division	STATE ARIZ.	PROJECT NO.	FEDERAL ID NO.	SHEET NO.	TOTAL SHEETS	RECORD DRAWING
		DESIGN	I. BYSTROV	3/26		CROSS SECTIONS			MILEPOST	SAN PEDRO RIVER BRIDGE NO. 20310	SHEET OF		
		DRAWN	P. MEEK	3/26									
		CHECKED	E. EGGEN	3/26									
		TEAM LEADER	E. EGGEN	3/26	TRACS NO. F0522 01C			___ OF ___					

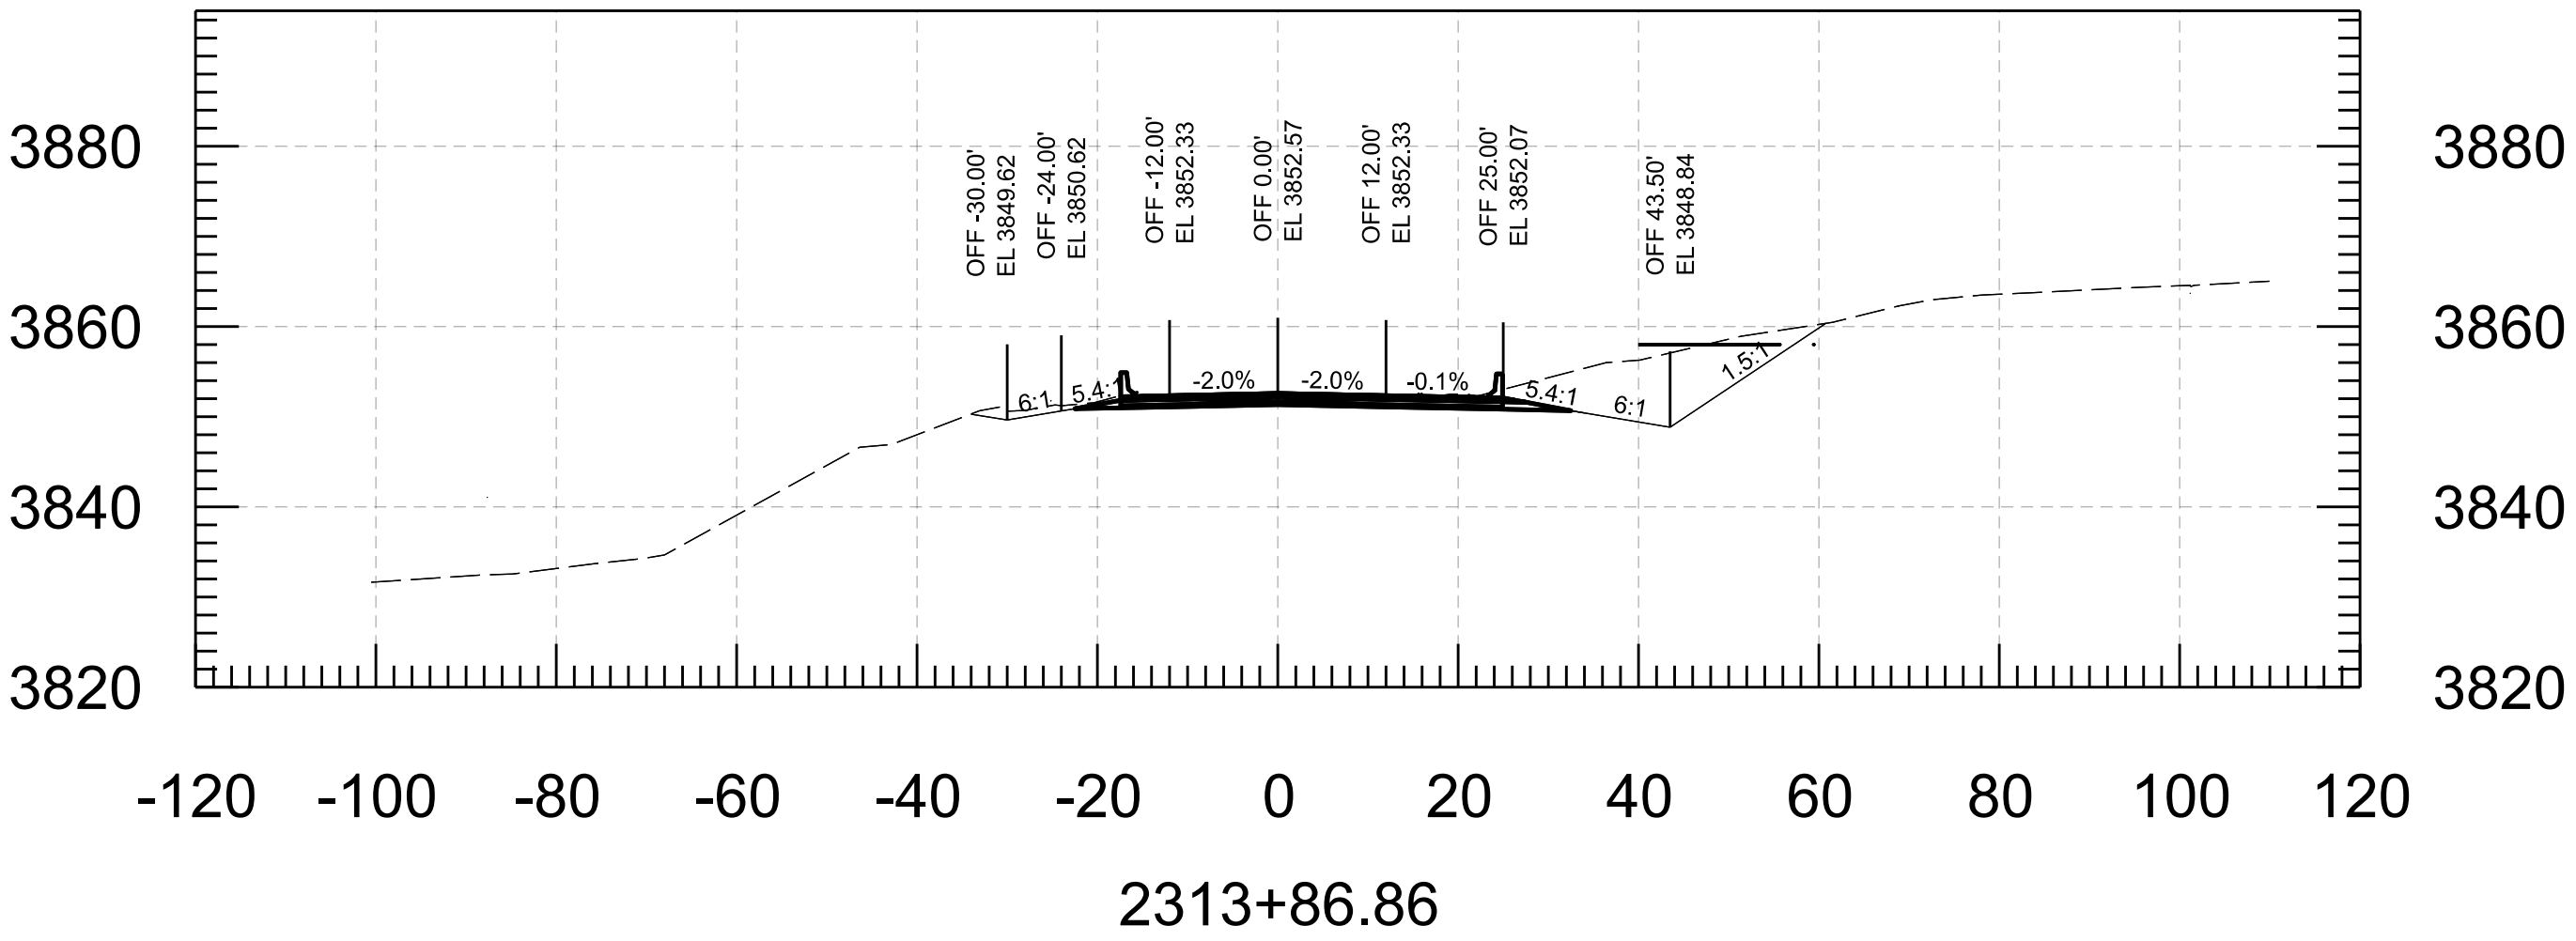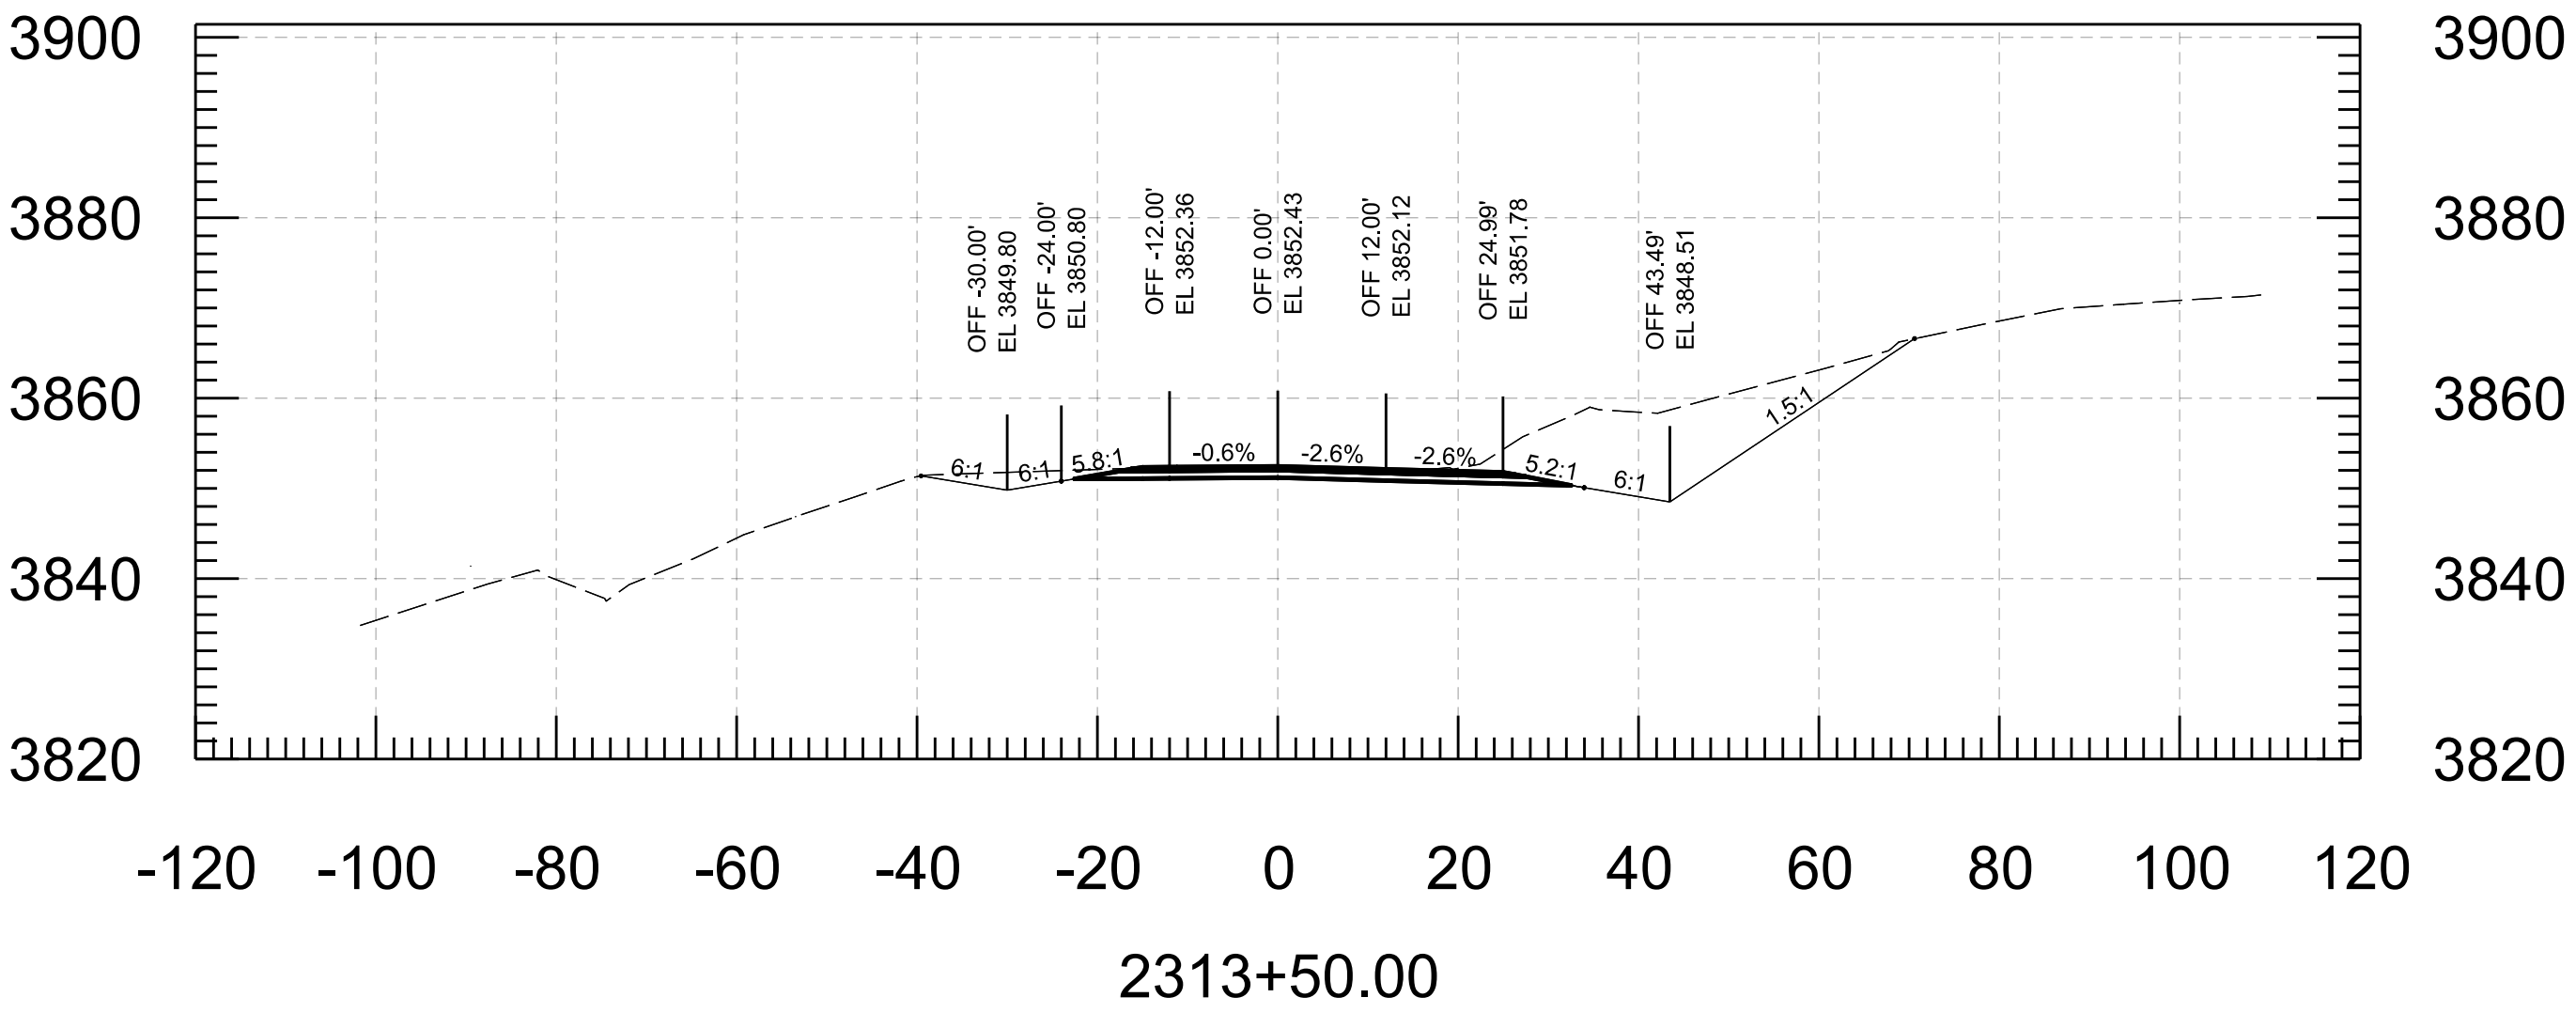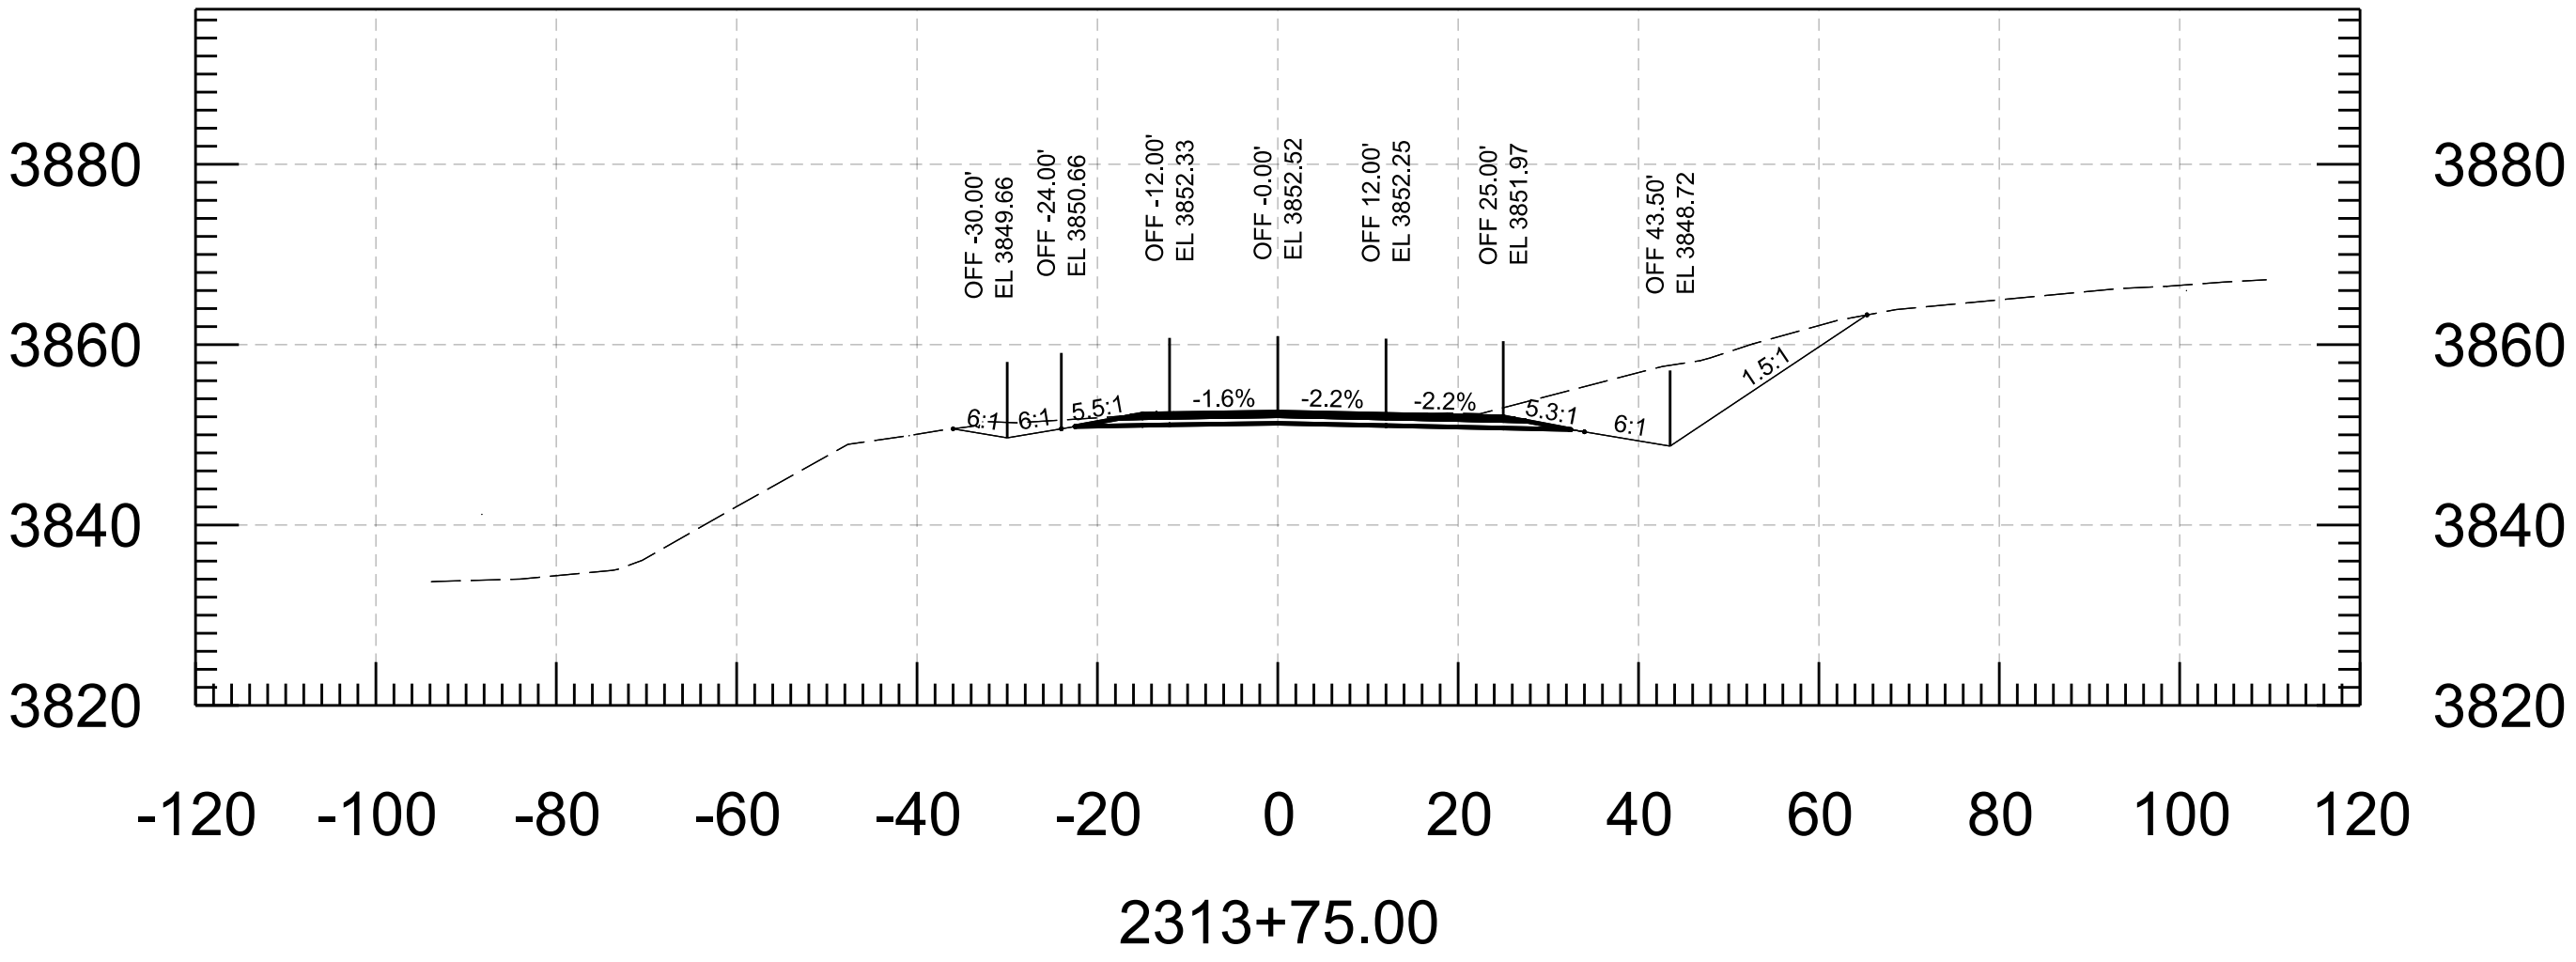

PRELIMINARY
STAGE V
Review
NOT FOR
CONSTRUCTION
OR RECORDING

	NAME	DATE
DESIGN	I. BYSTROV	3/26
DRAWN	P. MEEK	3/26
CHECKED	E. EGGEN	3/26
TEAM LEADER	E. EGGEN	3/26

ARIZONA DEPARTMENT OF TRANSPORTATION
PROJECT DELIVERY AND OPERATIONS DIVISION
ROADWAY DESIGN SECTION

CROSS SECTIONS

ROUTE
SR 82

MILEPOST

STRUCTURE NO.

F.H.W.A. Arizona Division

STATE
ARIZ.

PROJECT NO.
082 CH 061

FEDERAL ID NO.
082-A(210)T

SHEET
NO.

3

TOTAL
SHEETS







9

RECORD DRAWING







LOCATION
SAN PEDRO RIVER BRIDGE NO. 20310

TRACS NO. F0522 01C

SHEET OF
___ OF ___

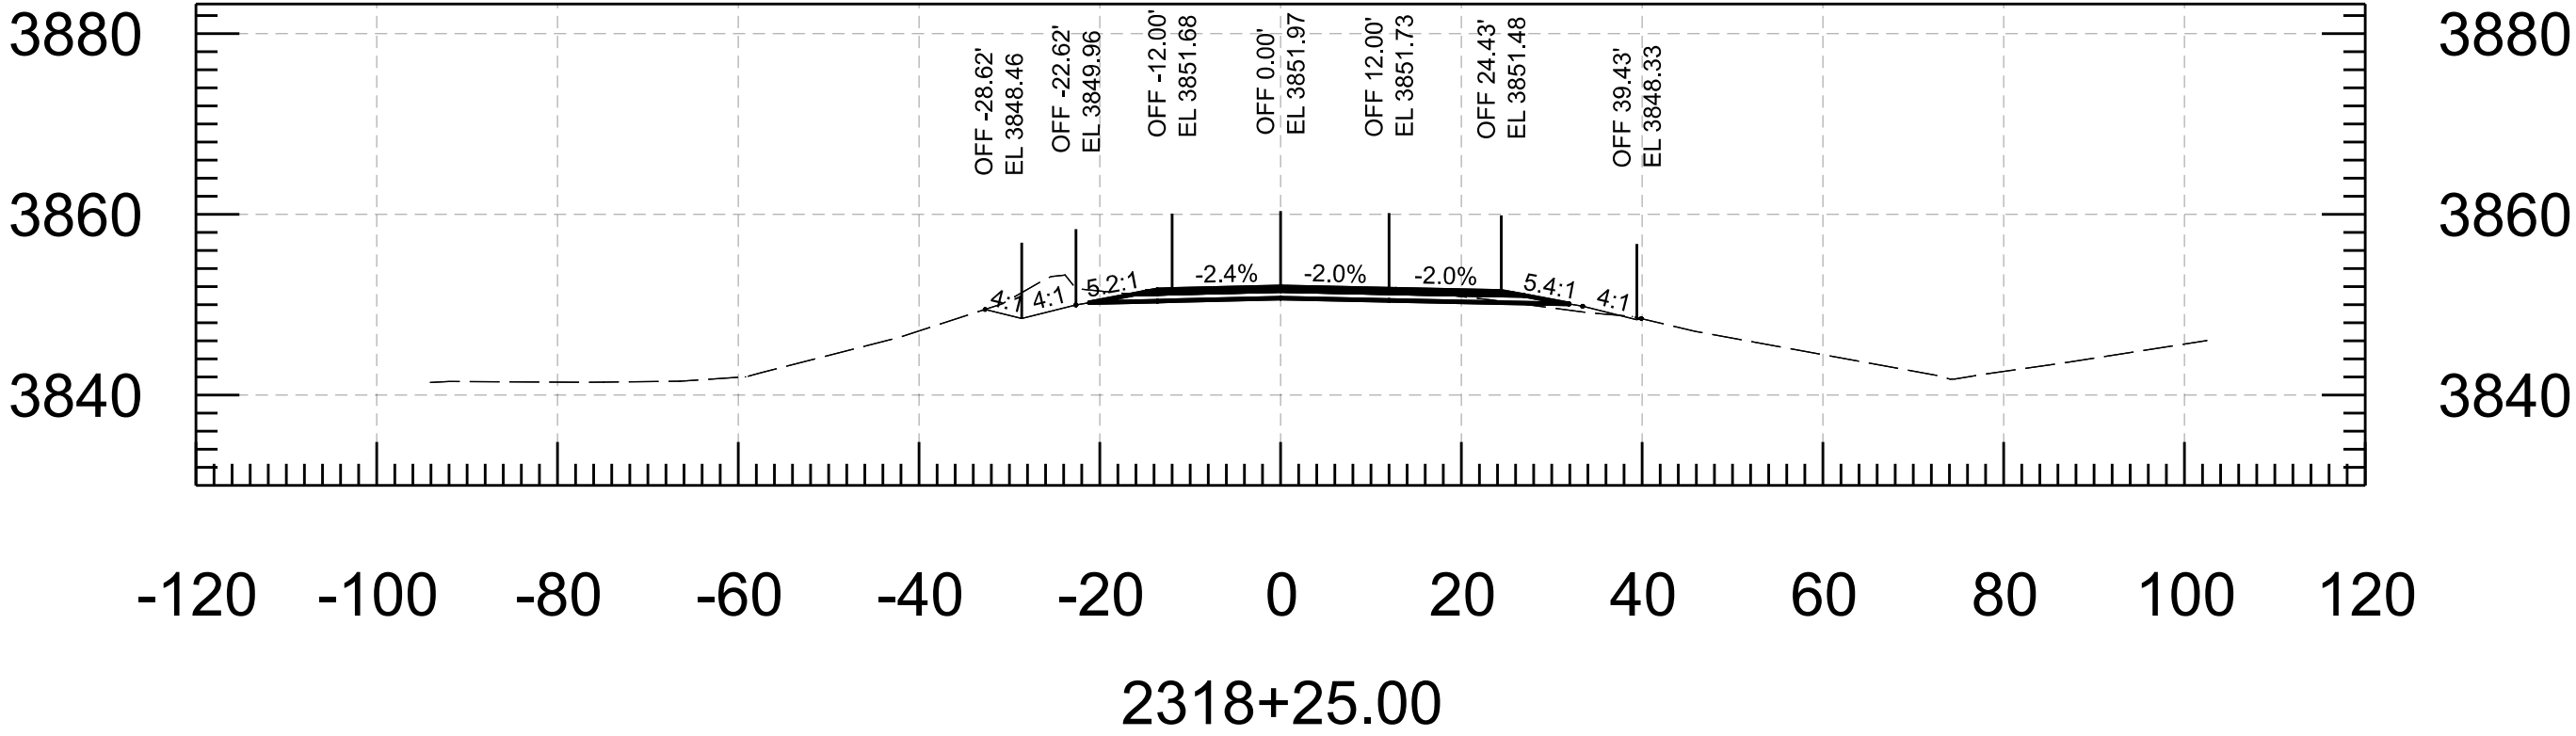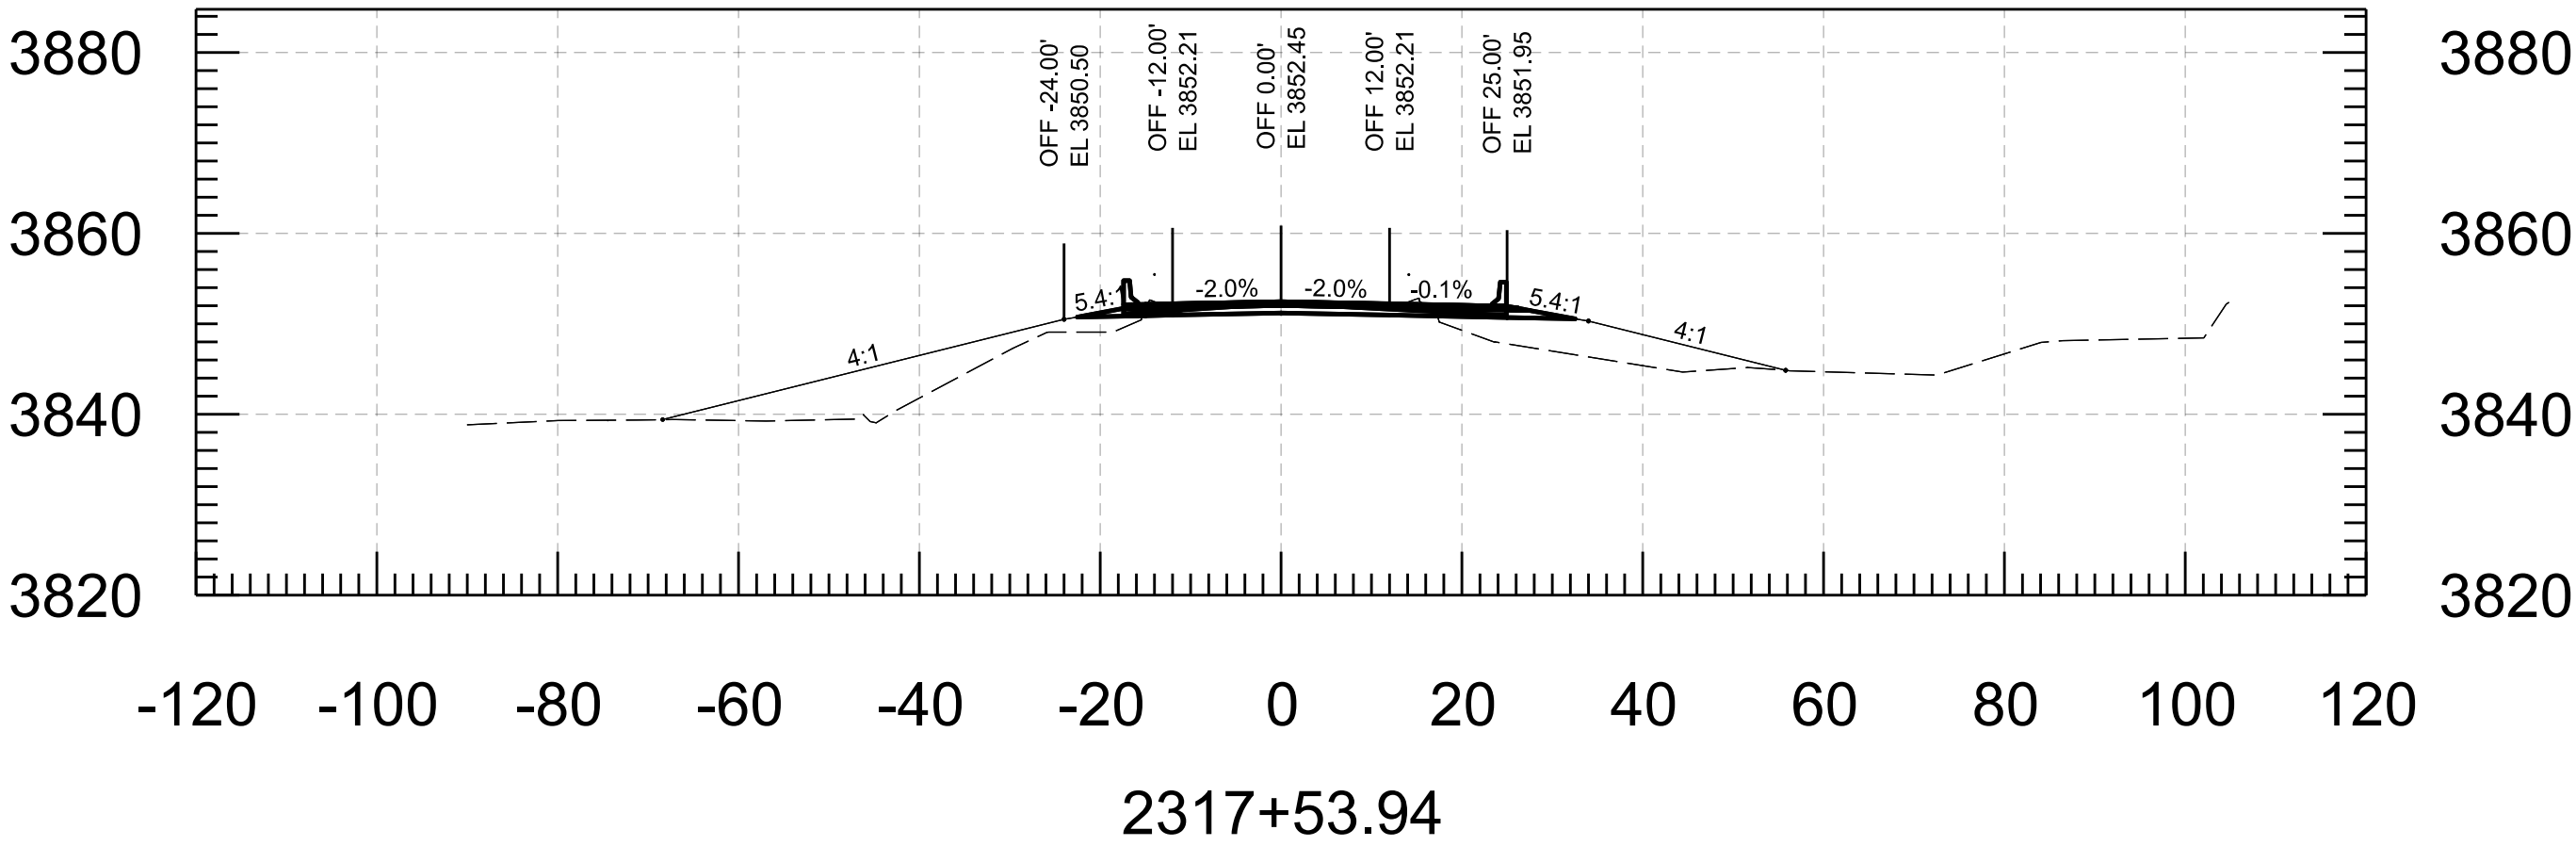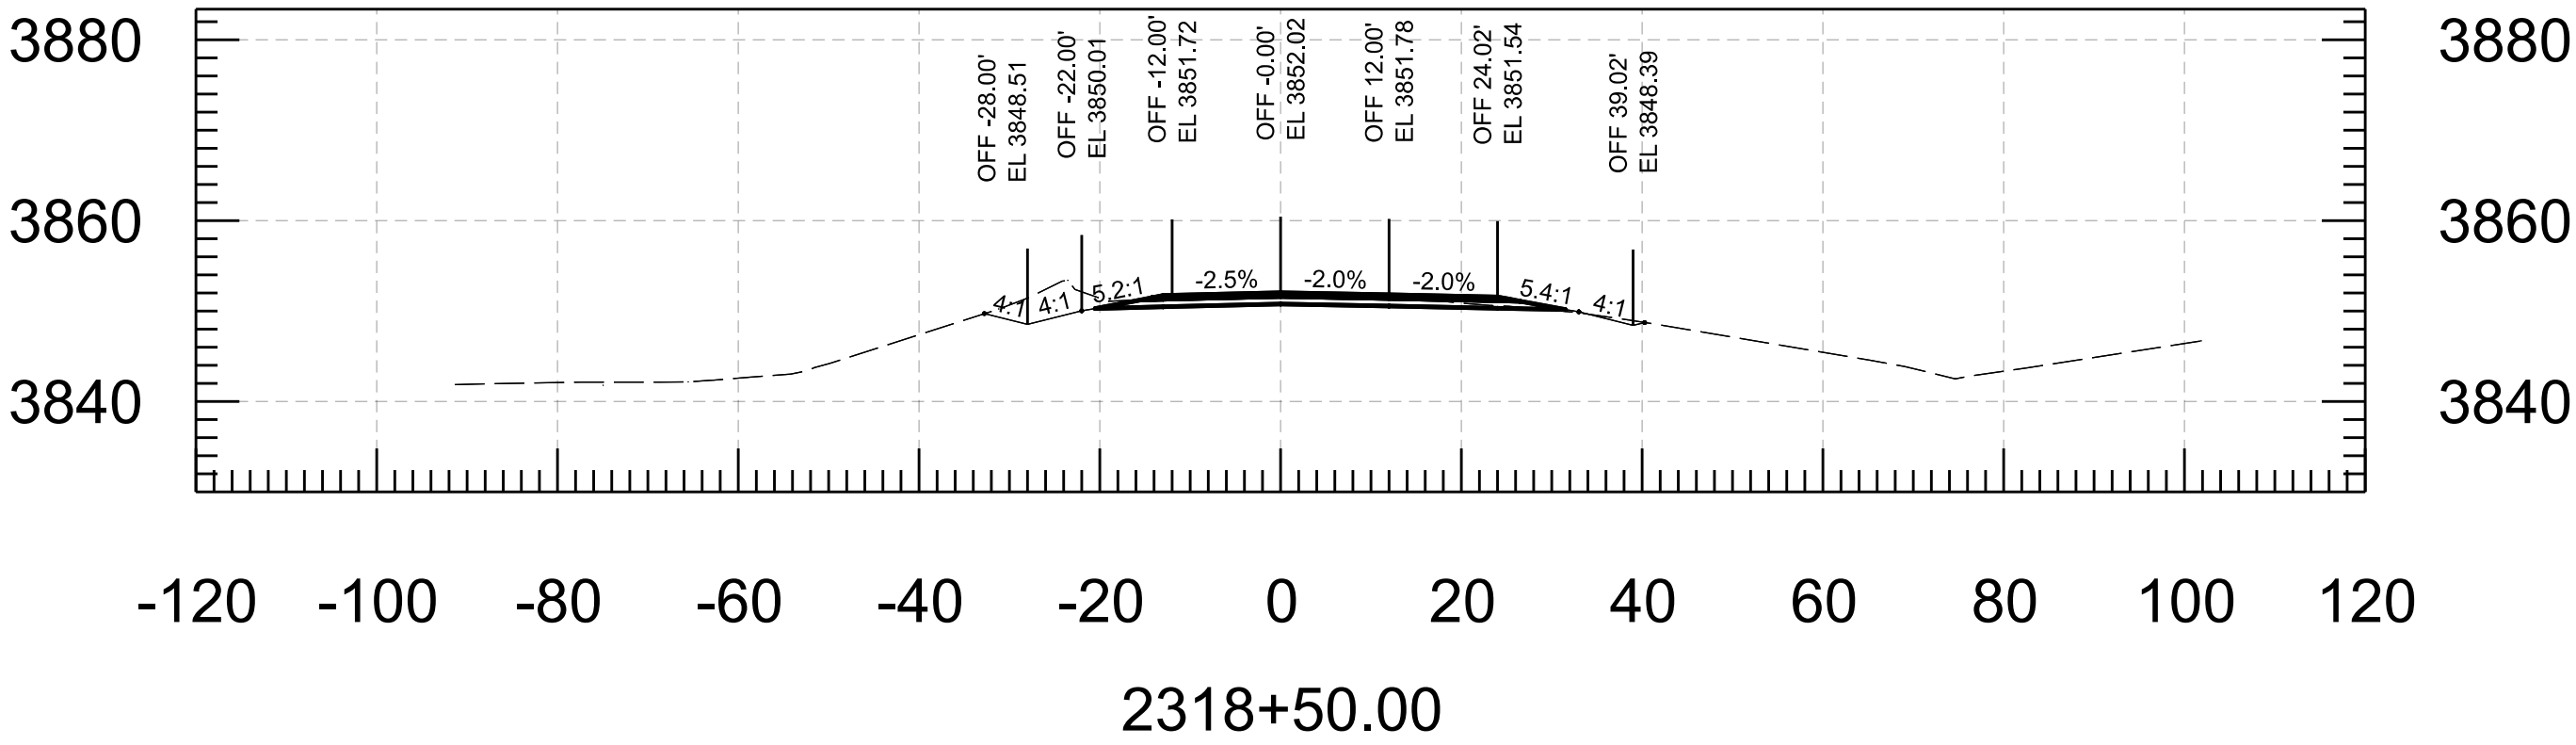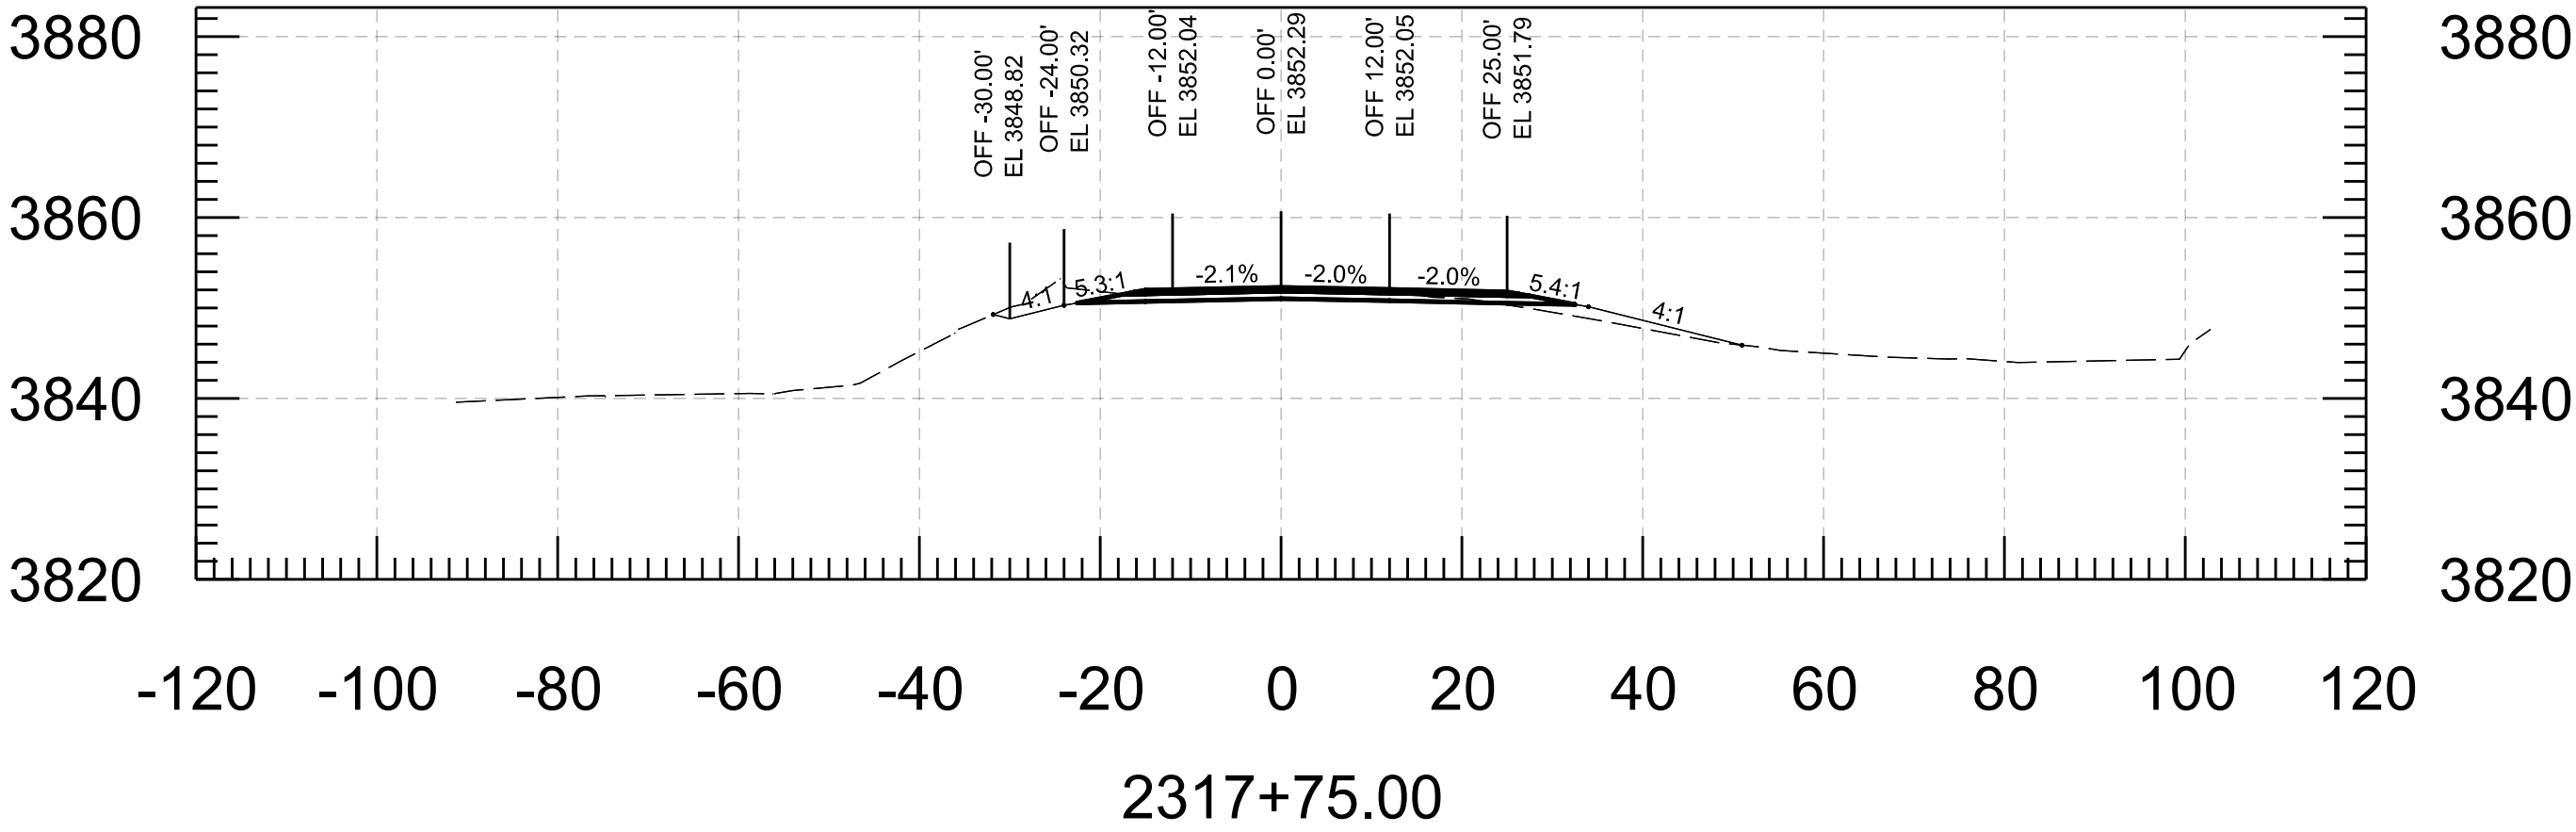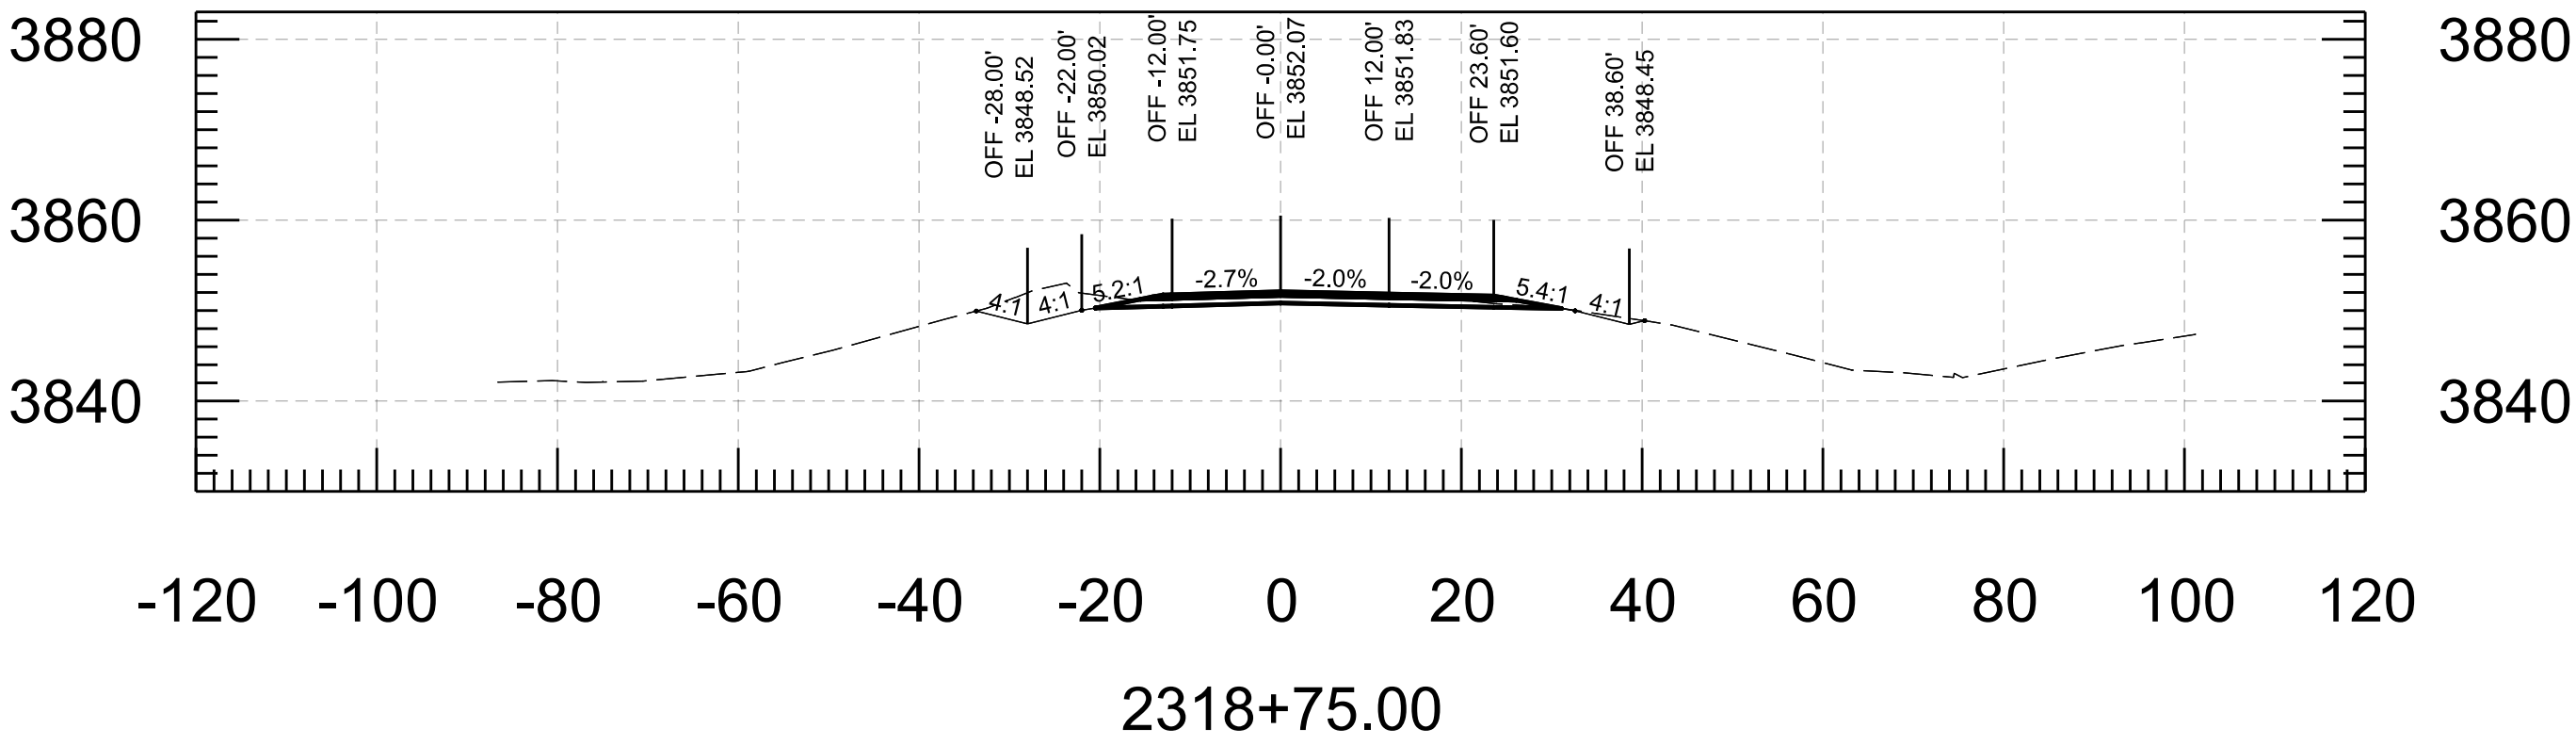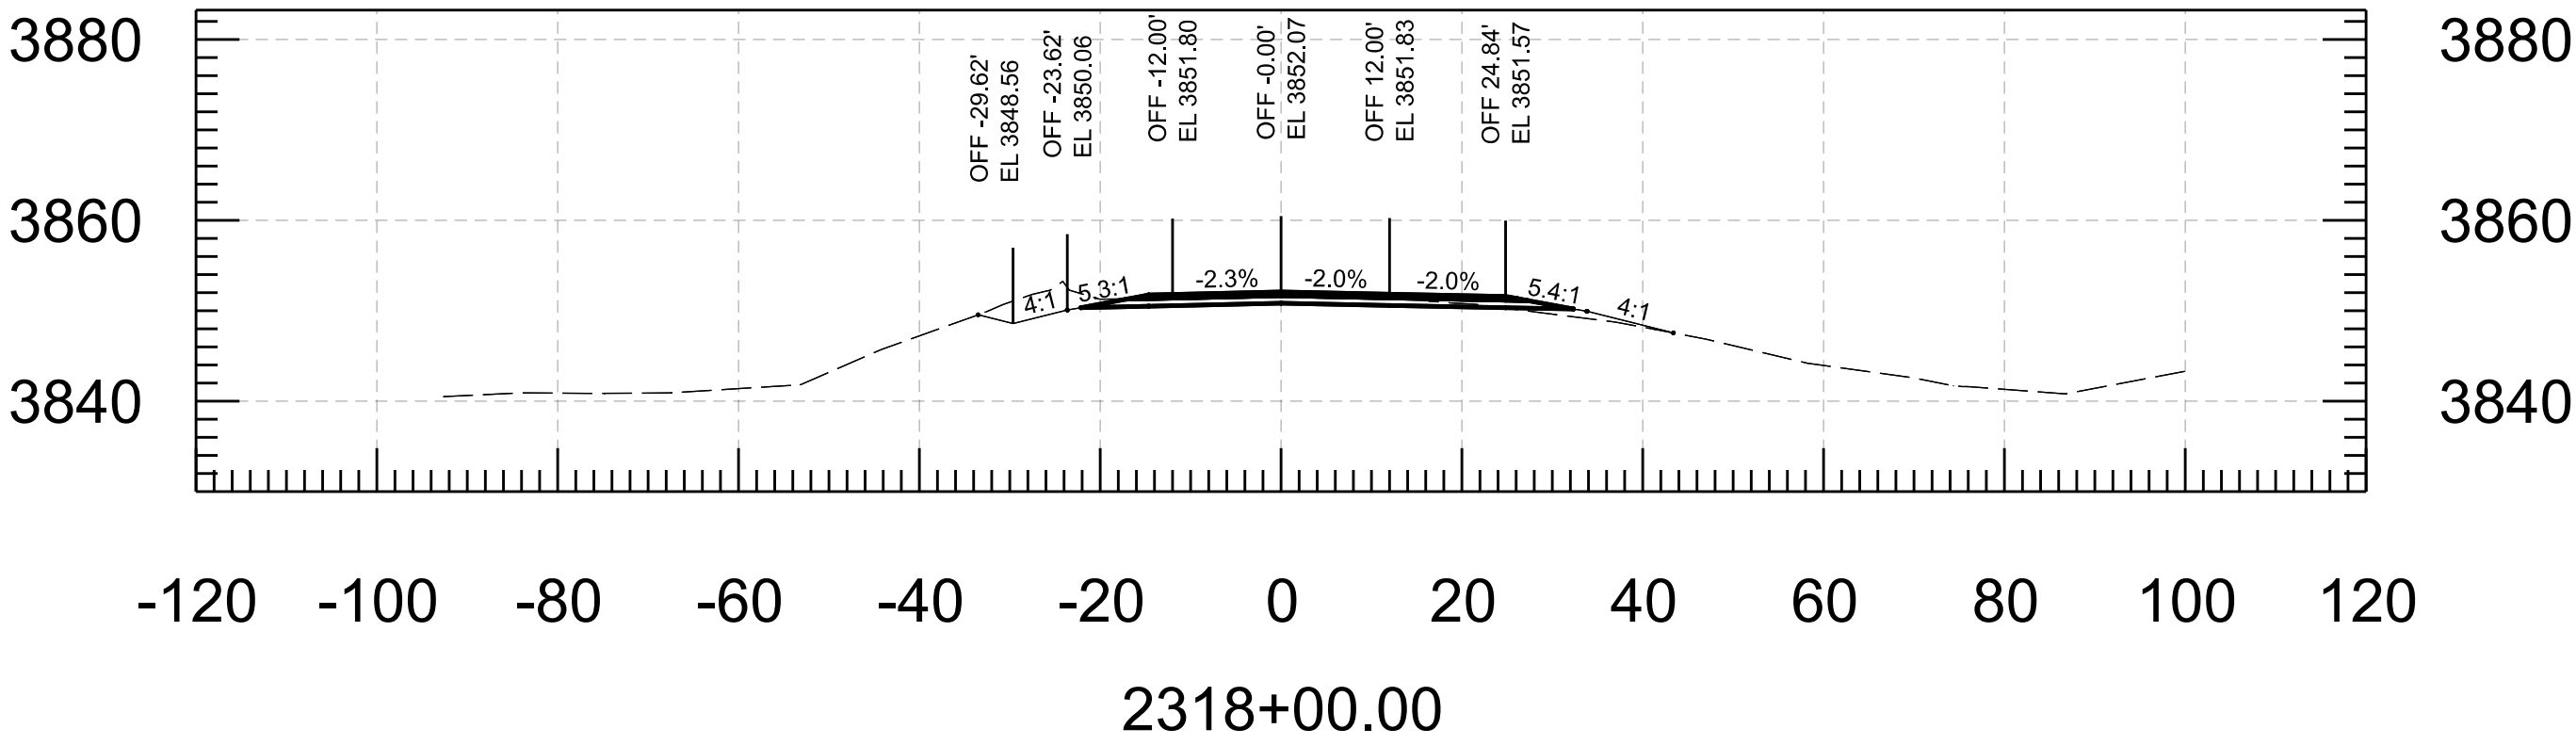

PRELIMINARY STAGE V Review NOT FOR CONSTRUCTION OR RECORDING		NAME	DATE	ARIZONA DEPARTMENT OF TRANSPORTATION PROJECT DELIVERY AND OPERATIONS DIVISION ROADWAY DESIGN SECTION	ROUTE	F.H.W.A. Arizona Division	STATE ARIZ.	PROJECT NO.	FEDERAL ID NO.	SHEET NO.	TOTAL SHEETS	RECORD DRAWING			
	DESIGN	I. BYSTROV	3/26		MILEPOST			082 CH 061	082-A(210)T	4	9				
	DRAWN	P. MEEK	3/26			STRUCTURE NO.	LOCATION SAN PEDRO RIVER BRIDGE NO. 20310							SHEET	OF
	CHECKED	E. EGGEN	3/26				TRACS NO. F0522 01C							___ OF ___	
	TEAM LEADER	E. EGGEN	3/26												
				CROSS SECTIONS											

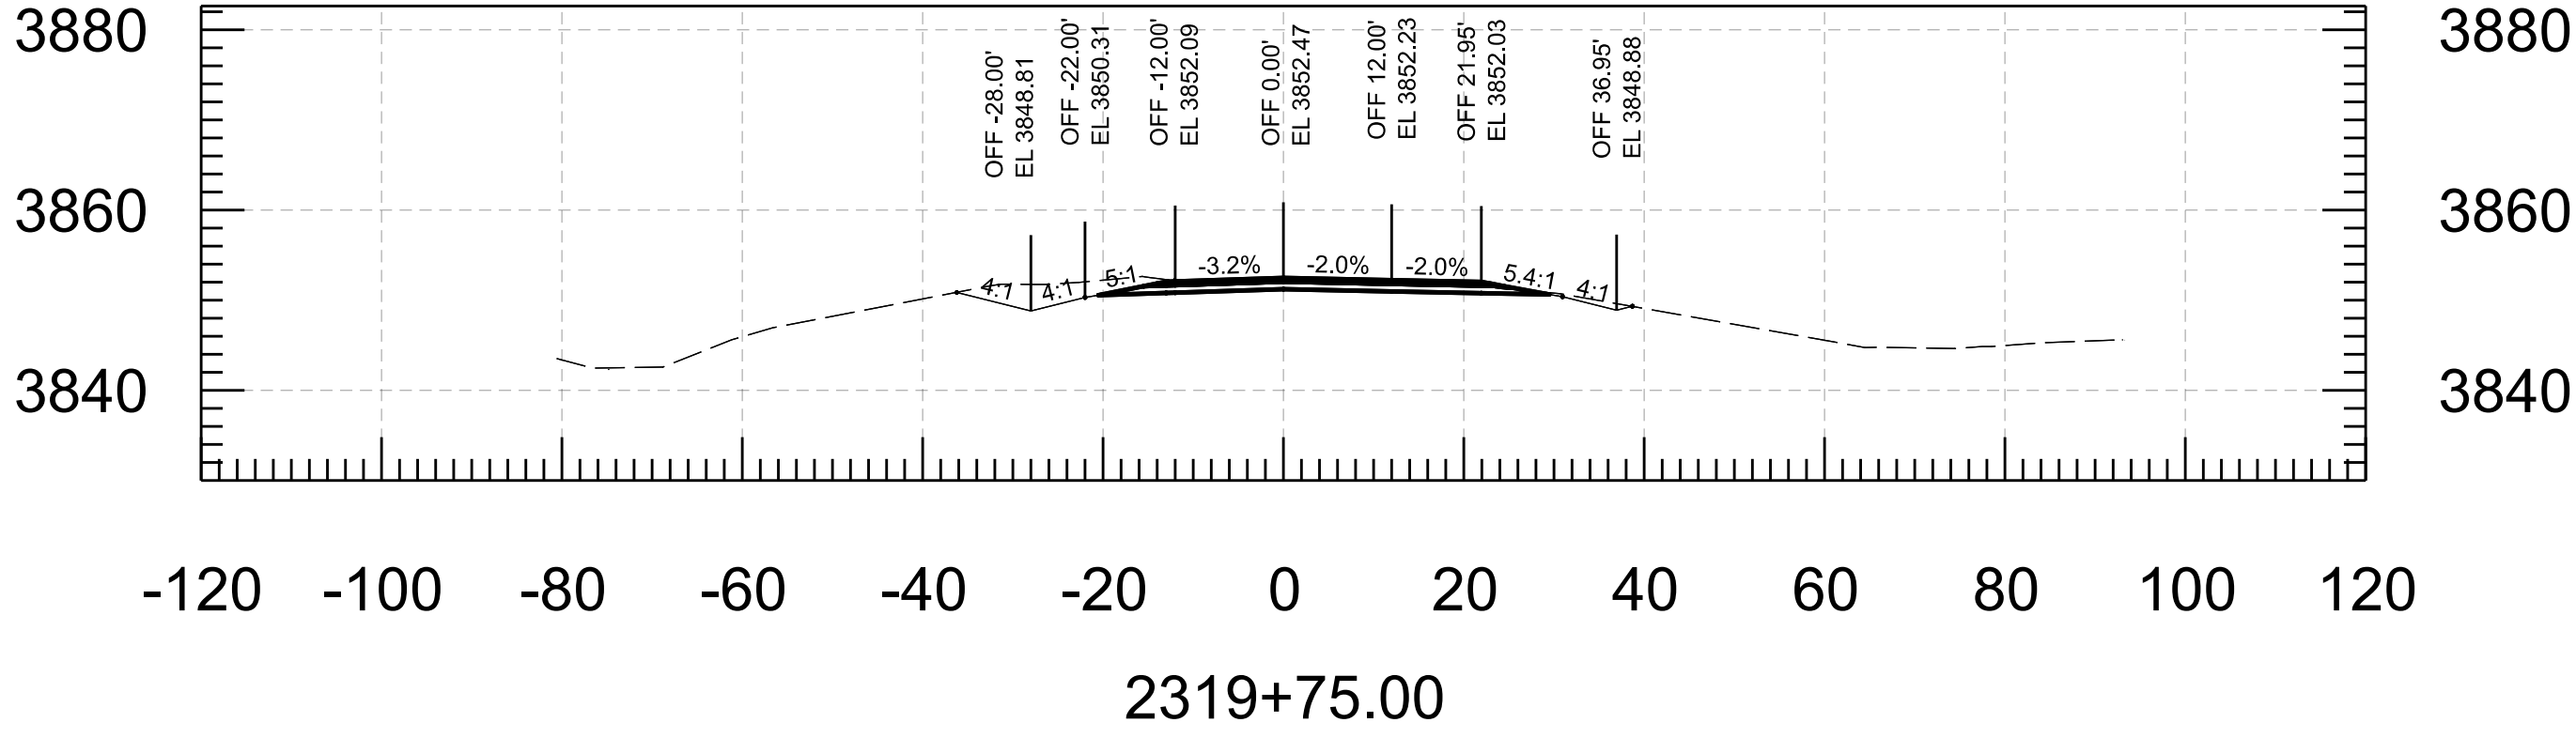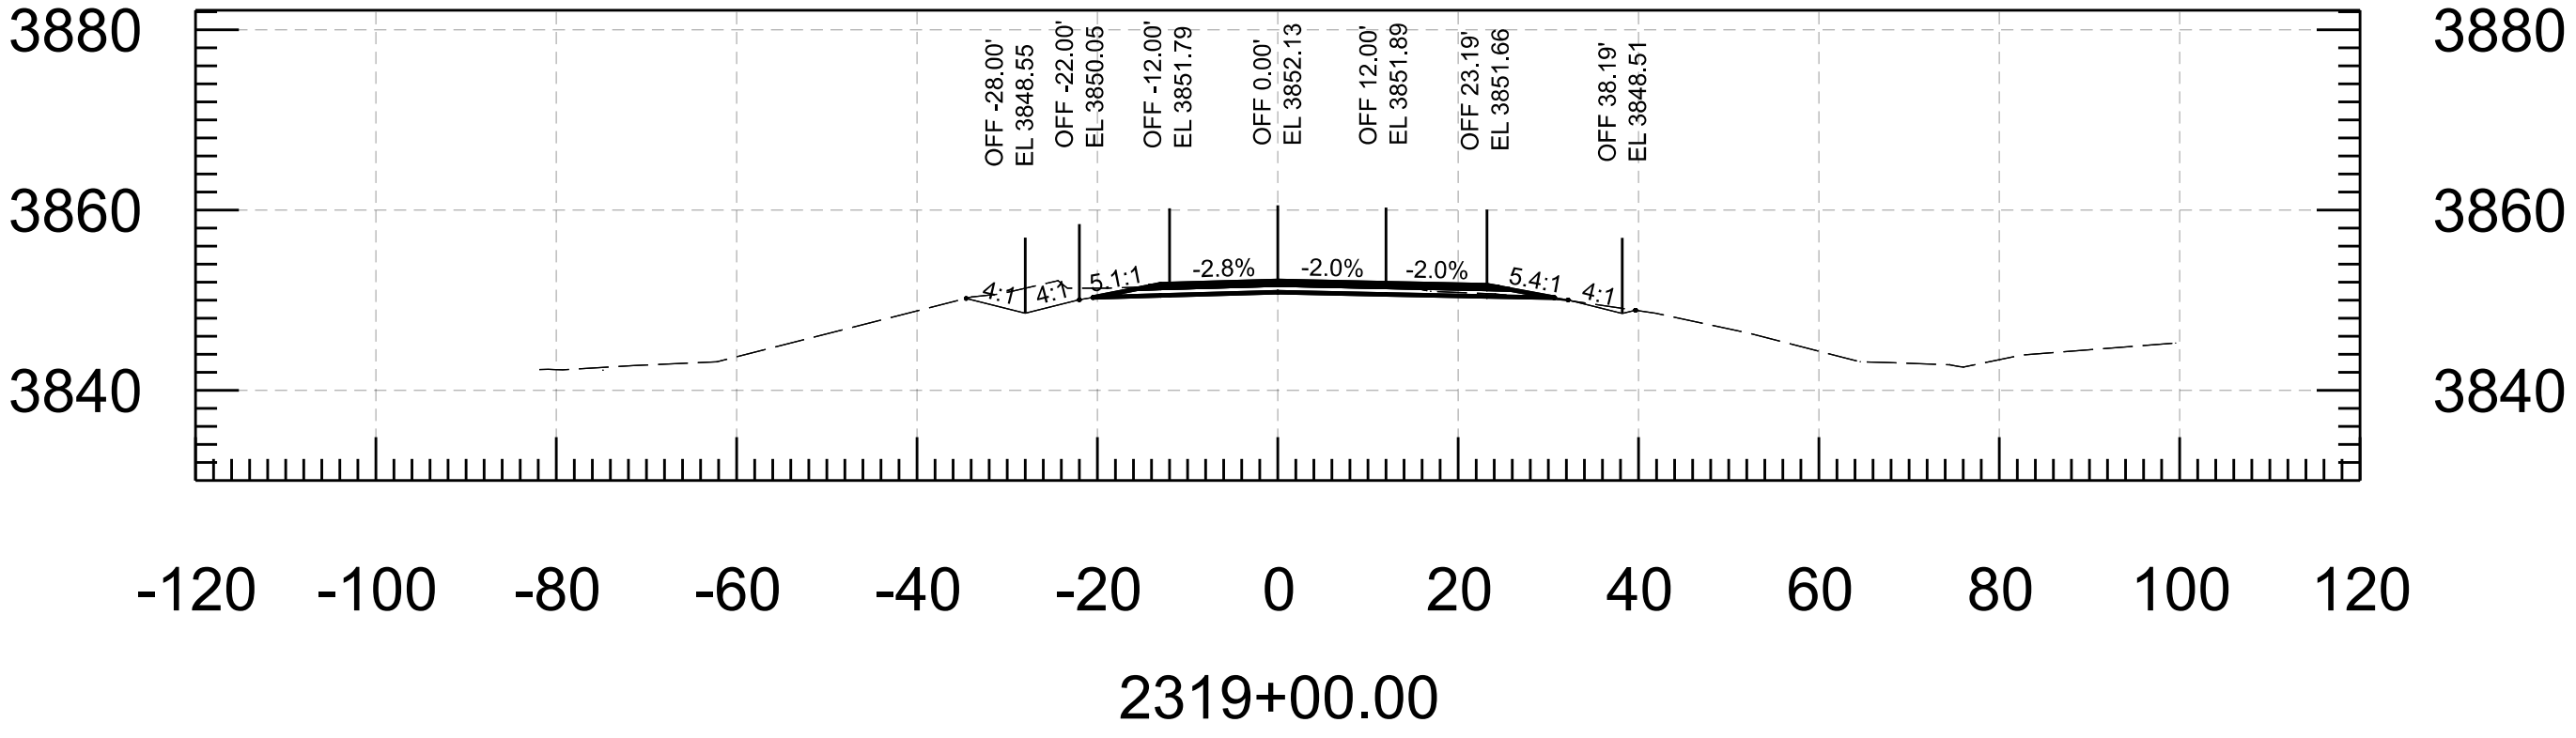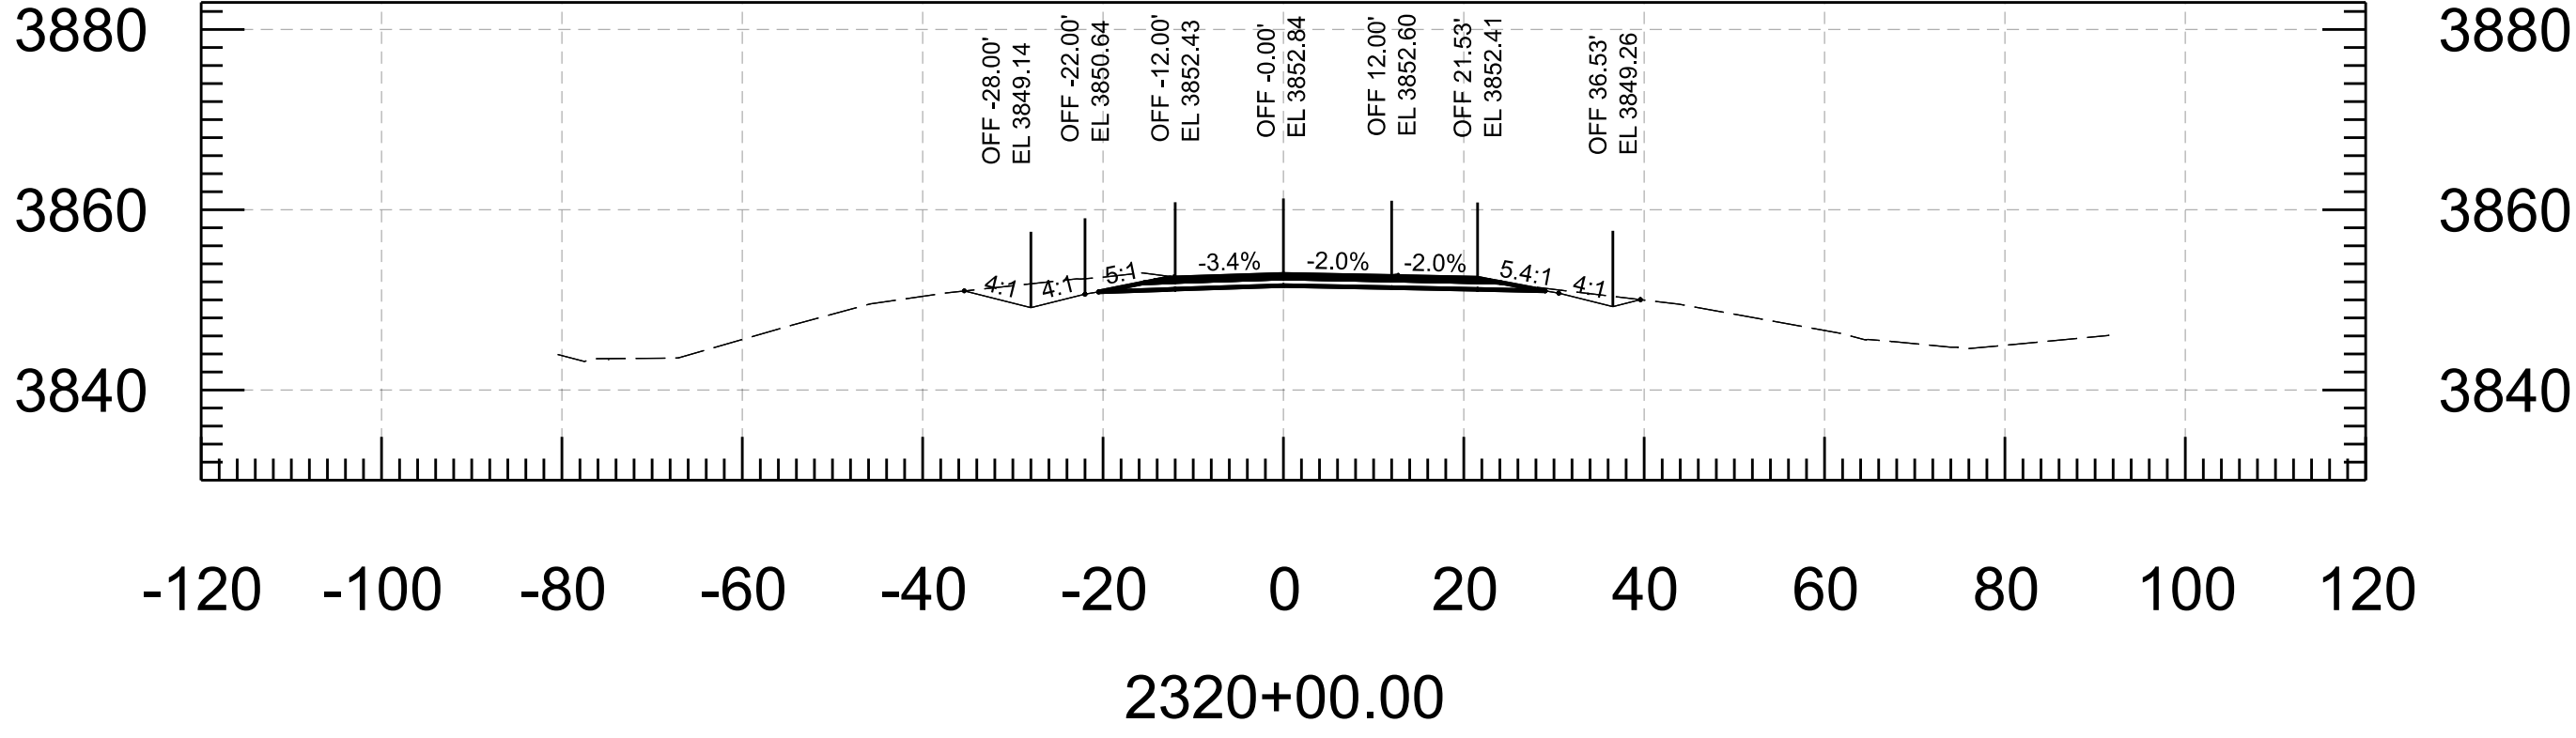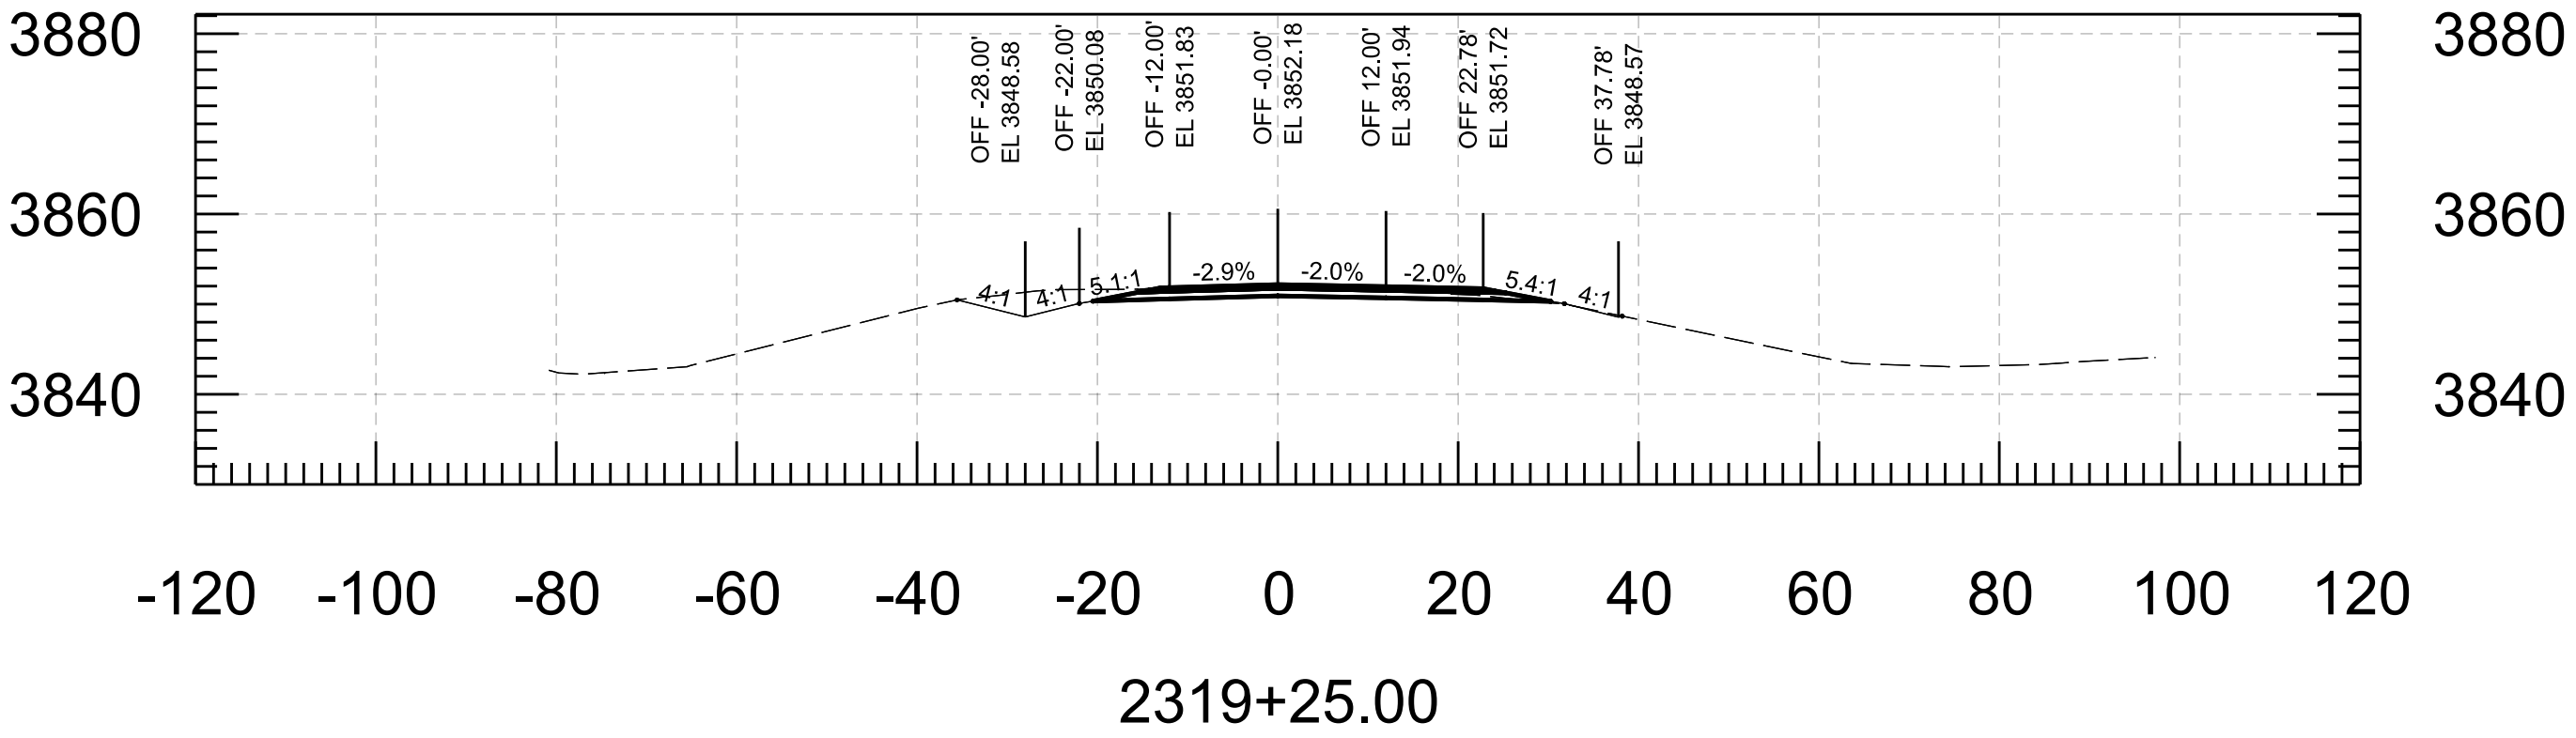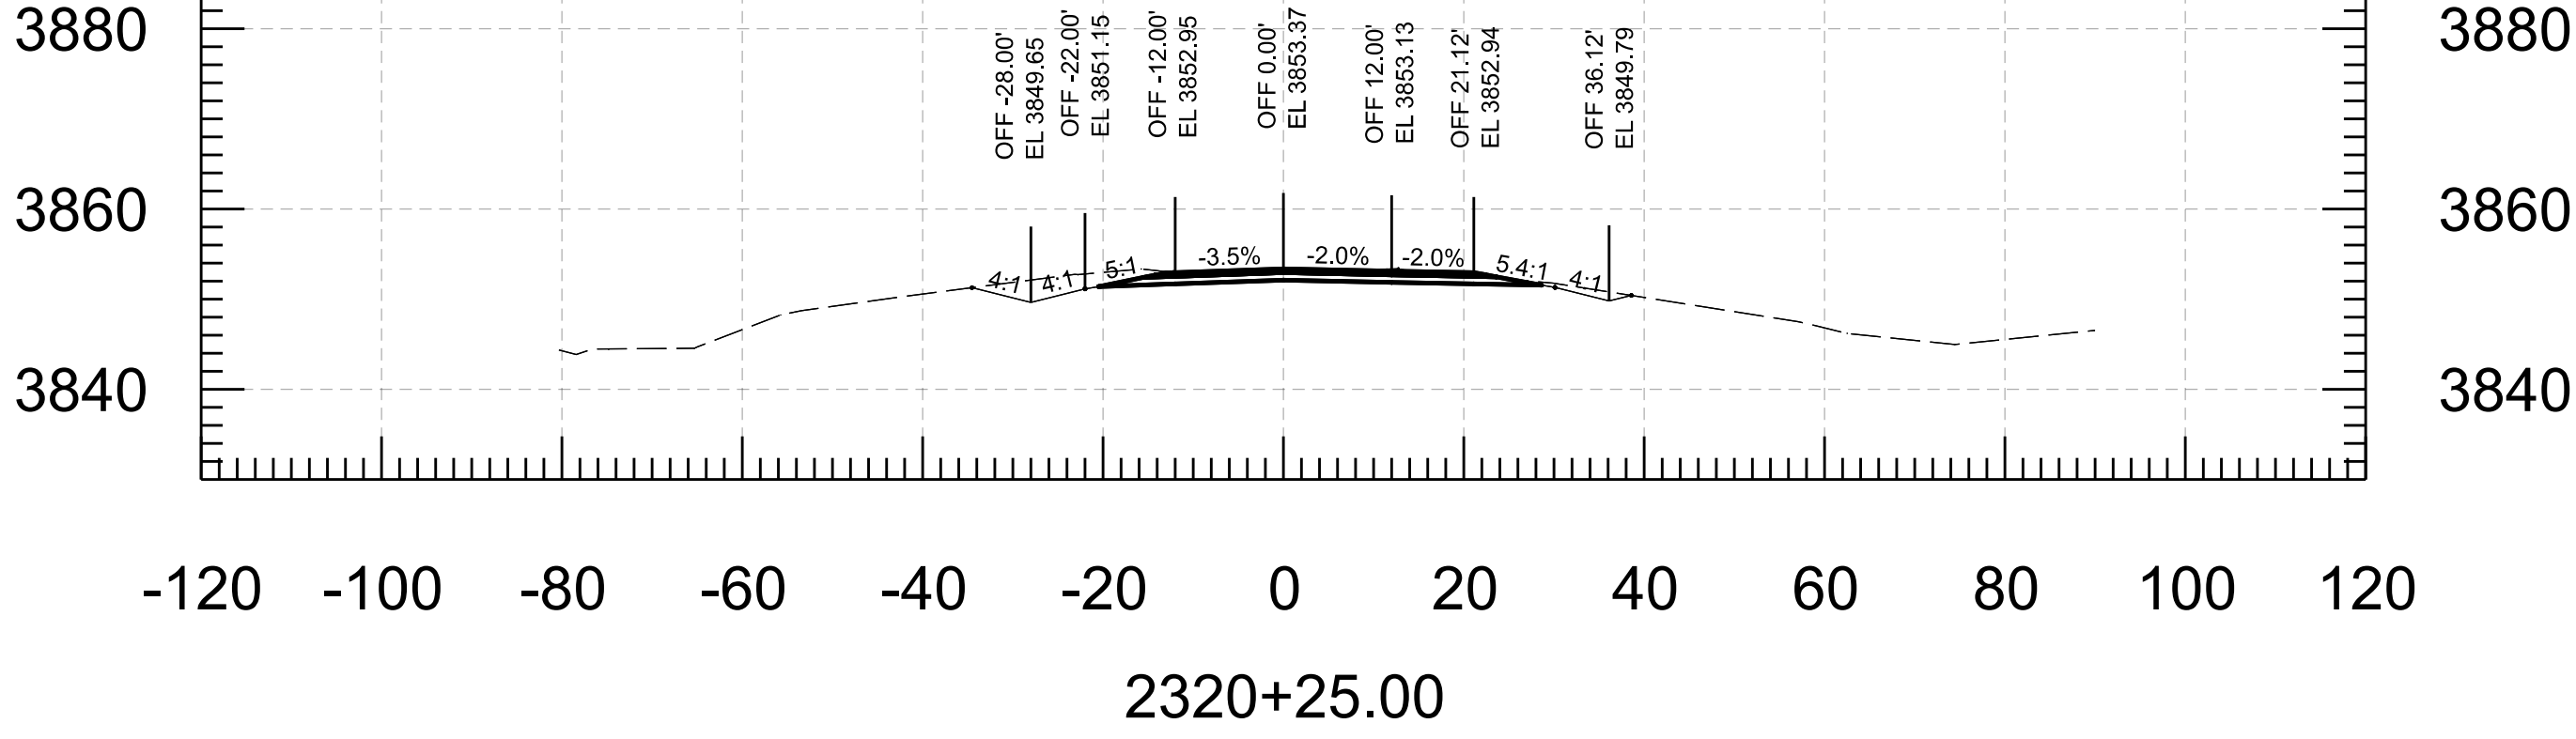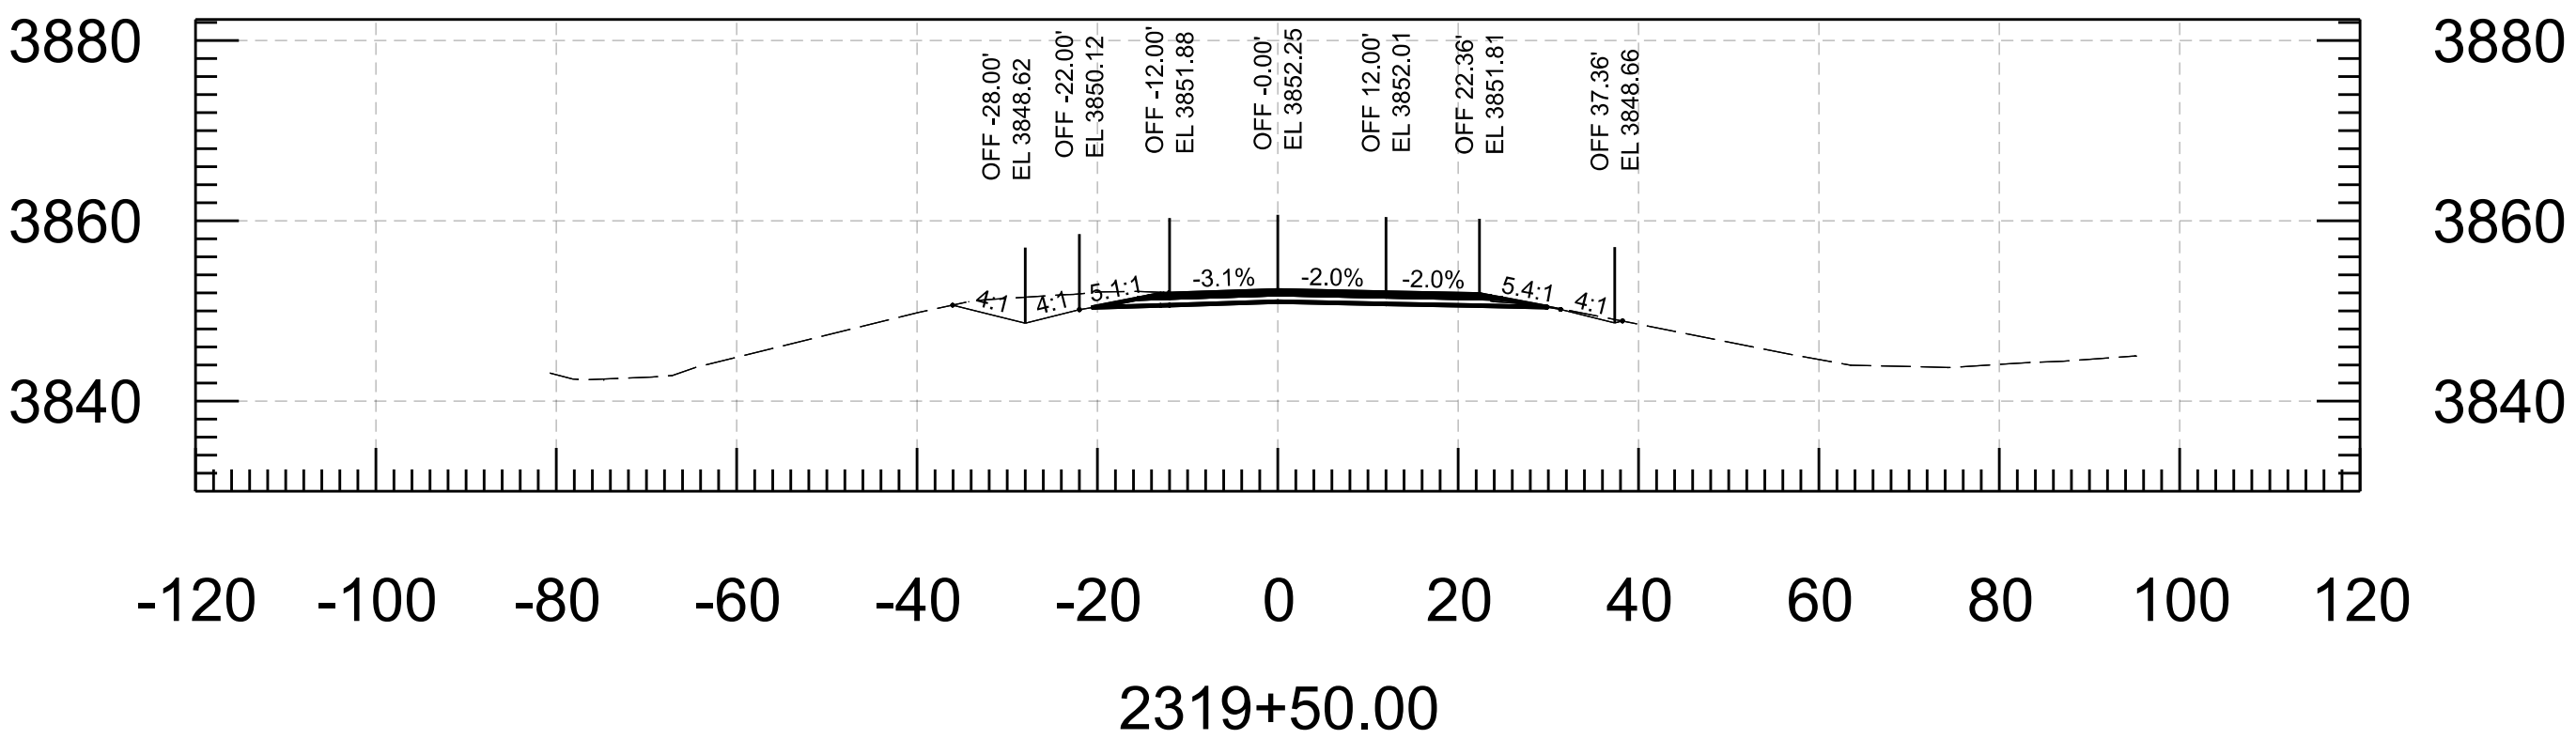

PRELIMINARY
STAGE V
Review
NOT FOR
CONSTRUCTION
OR RECORDING

	NAME	DATE
DESIGN	I. BYSTROV	3/26
DRAWN	P. MEEK	3/26
CHECKED	E. EGGEN	3/26
TEAM LEADER	E. EGGEN	3/26

ARIZONA DEPARTMENT OF TRANSPORTATION
PROJECT DELIVERY AND OPERATIONS DIVISION
ROADWAY DESIGN SECTION

CROSS SECTIONS

ROUTE
SR 82

MILEPOST

STRUCTURE NO.

F.H.W.A. Arizona Division

STATE
ARIZ.

PROJECT NO.
082 CH 061

FEDERAL ID NO.
082-A(210)T

SHEET
NO.

5

TOTAL
SHEETS

9







RECORD DRAWING

LOCATION
SAN PEDRO RIVER BRIDGE NO. 20310

TRACS NO. **F0522 01C**

SHEET OF

OF

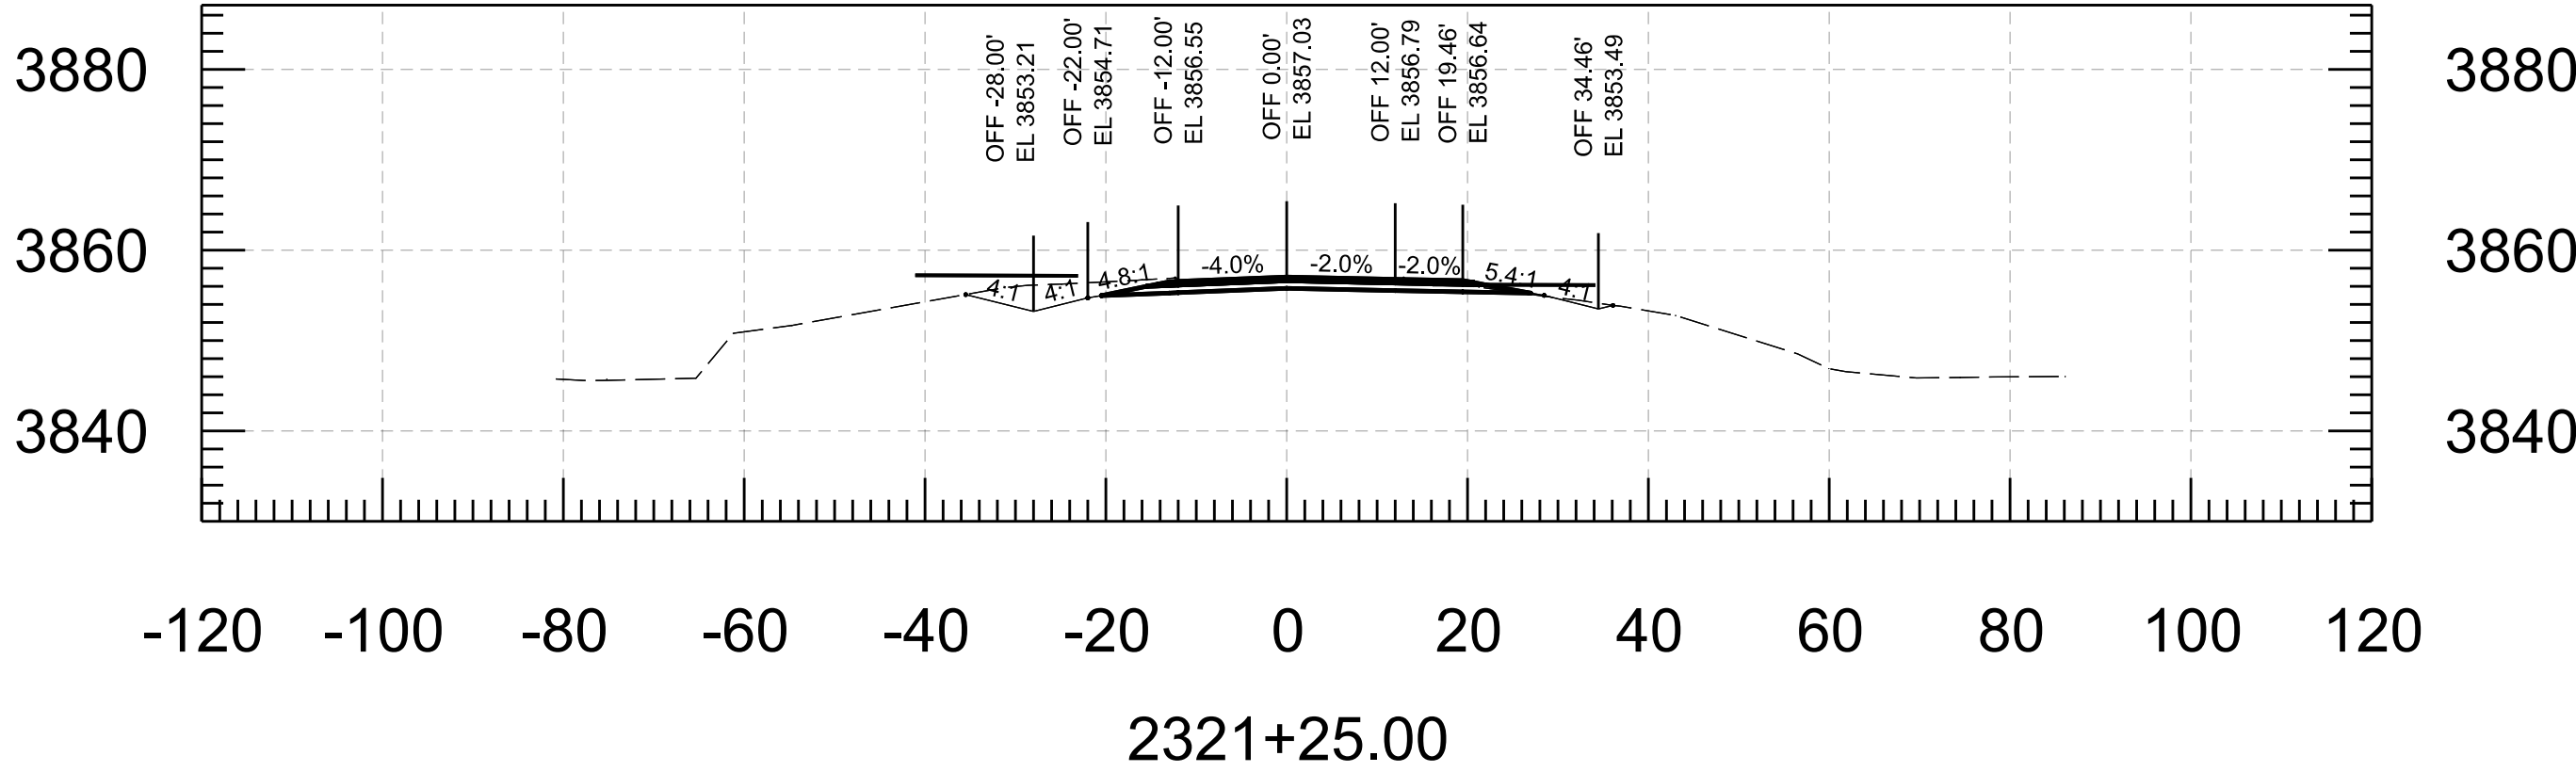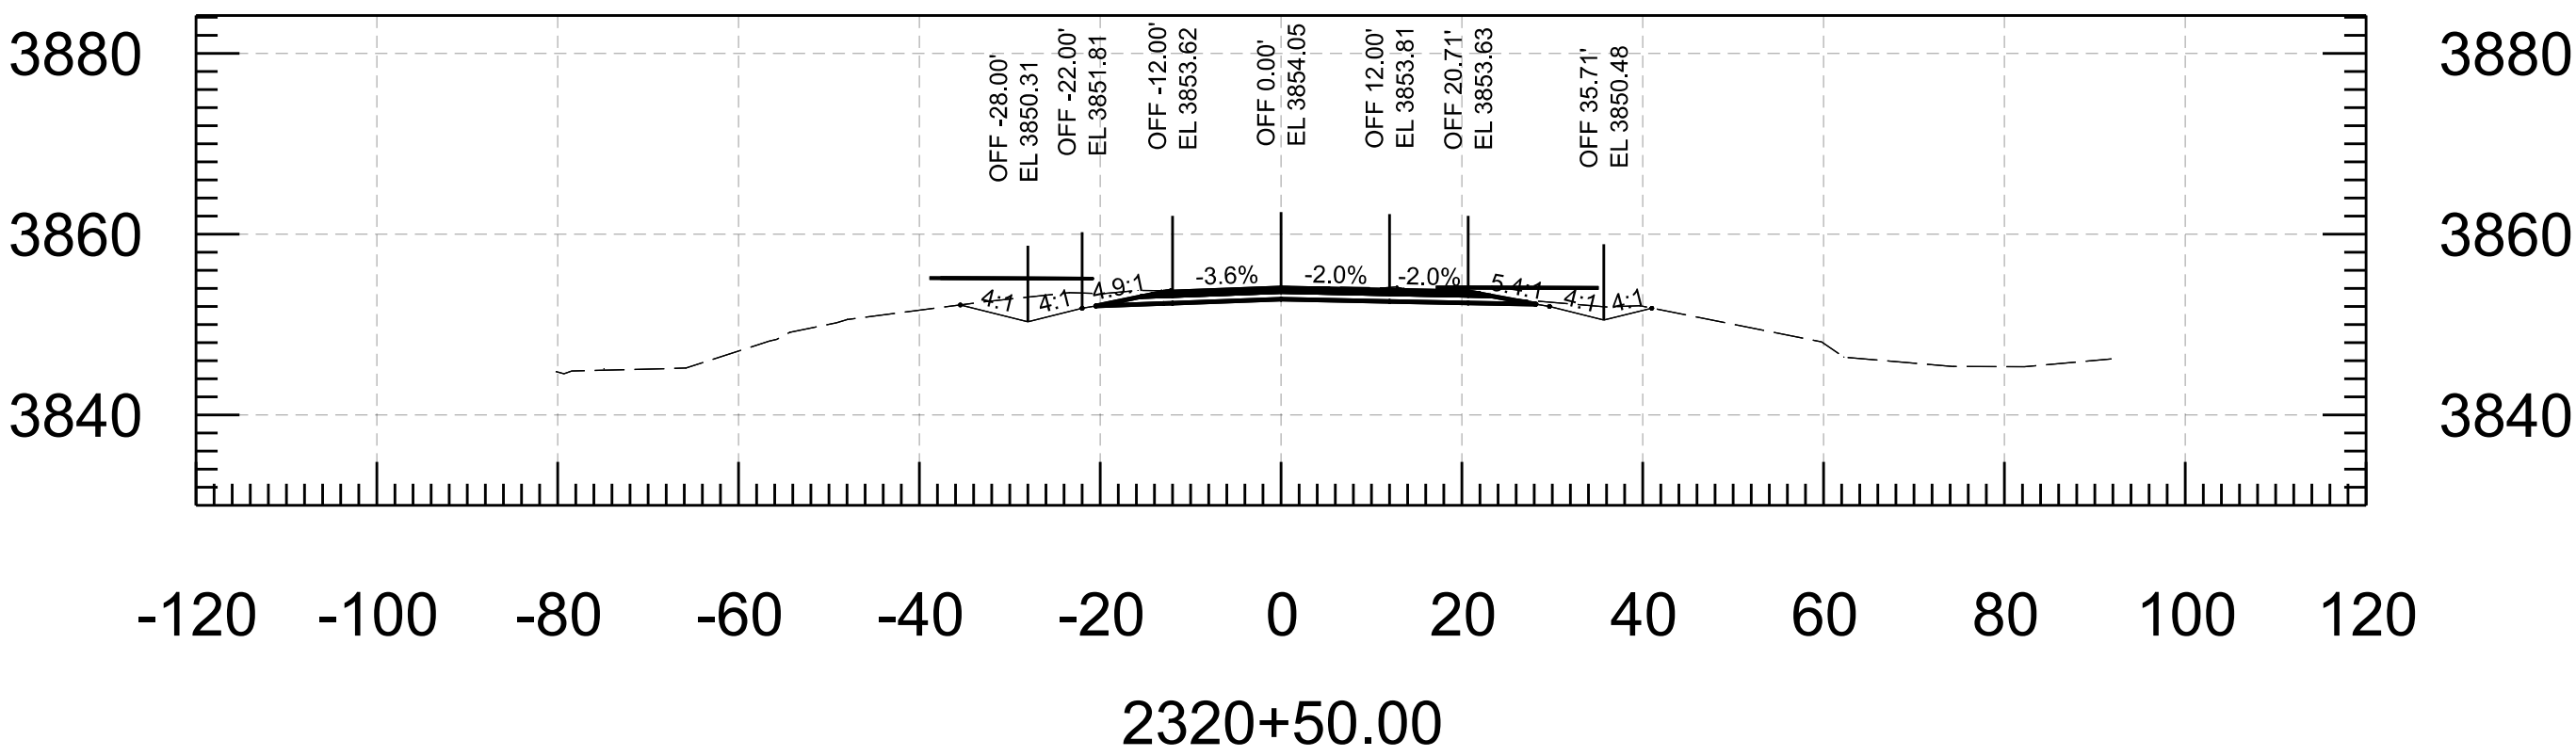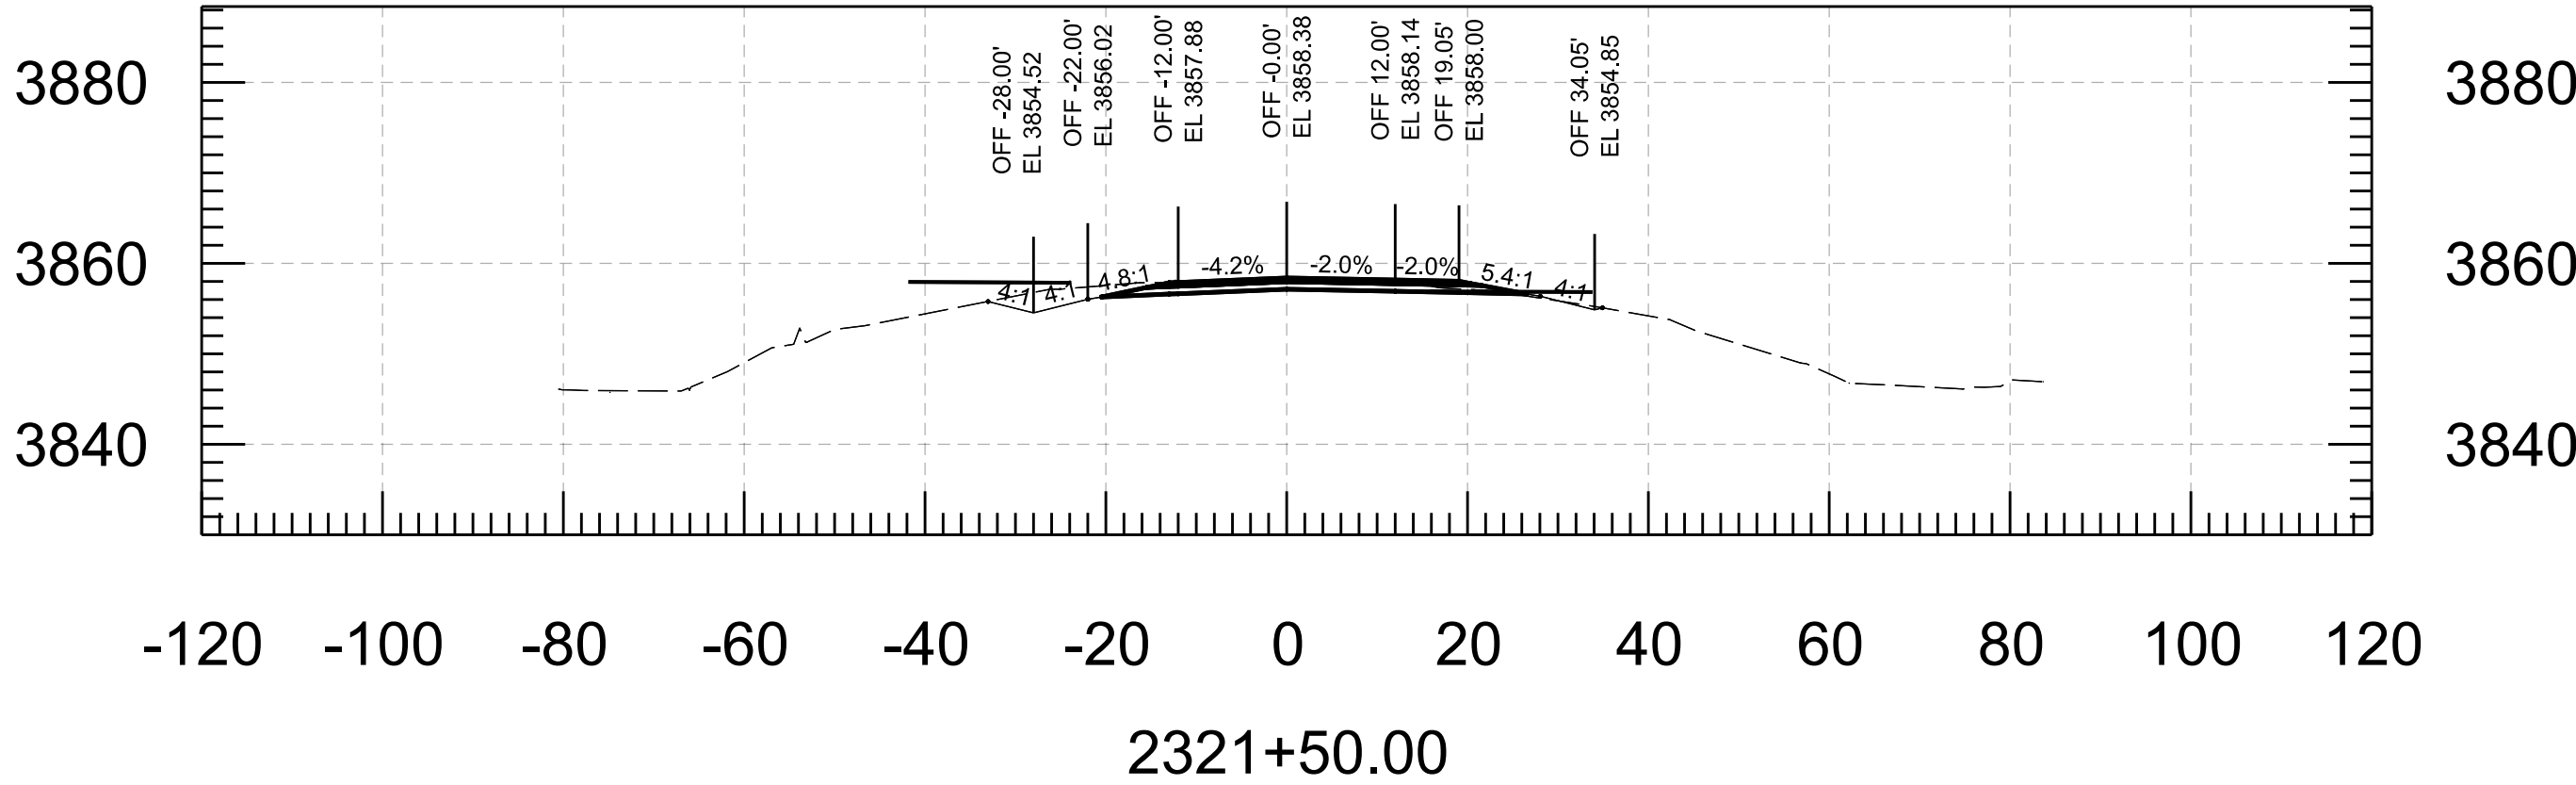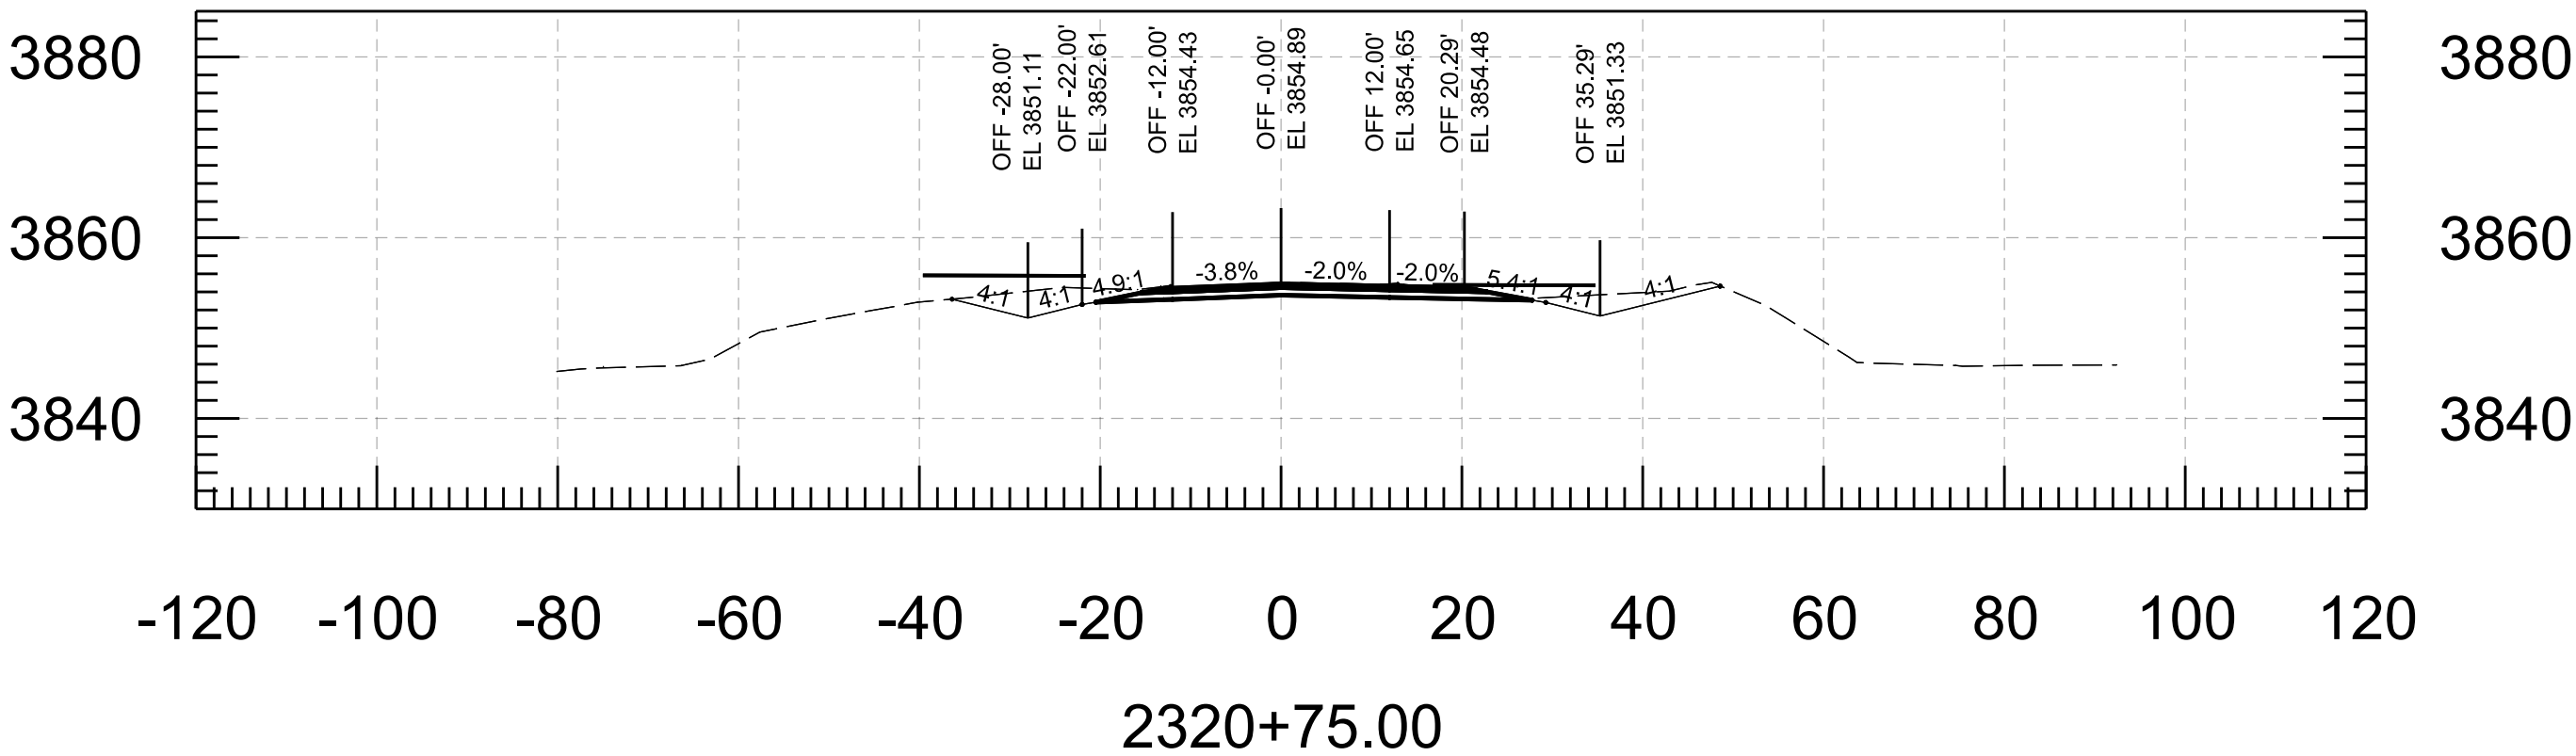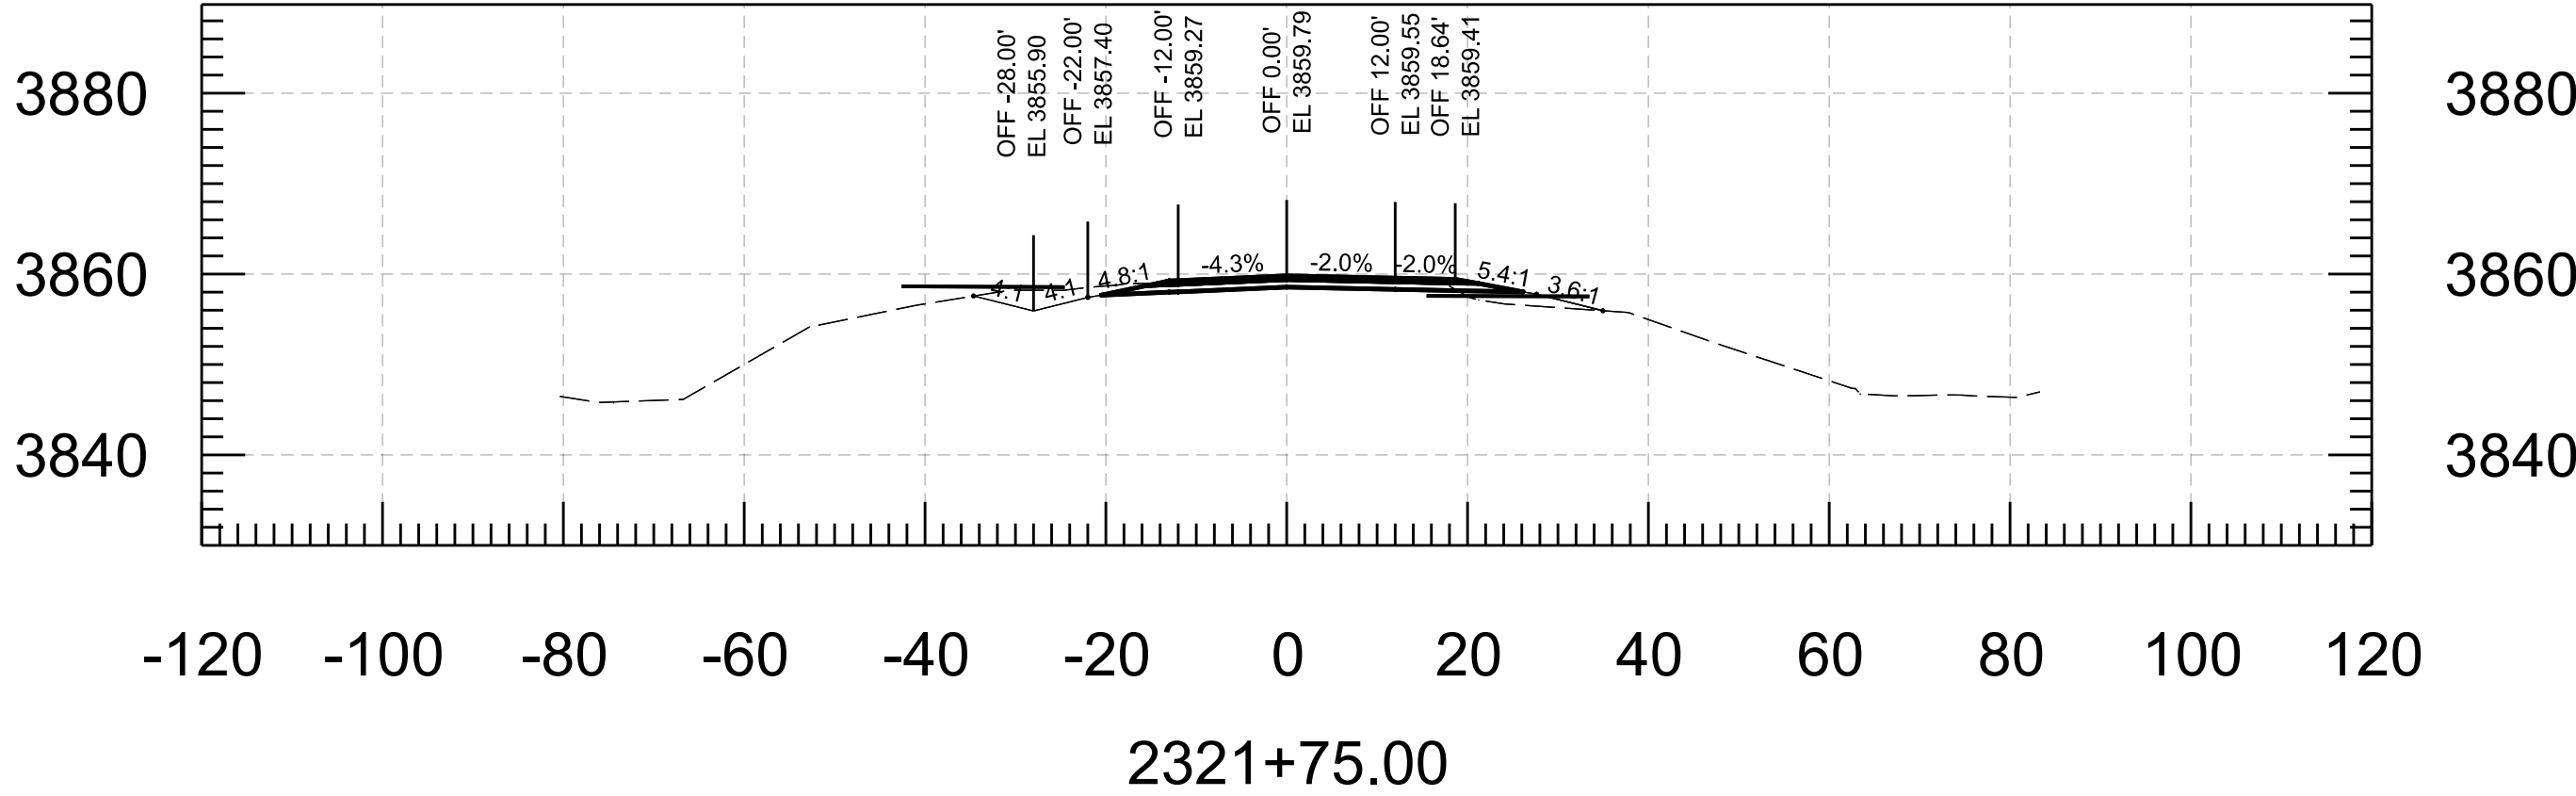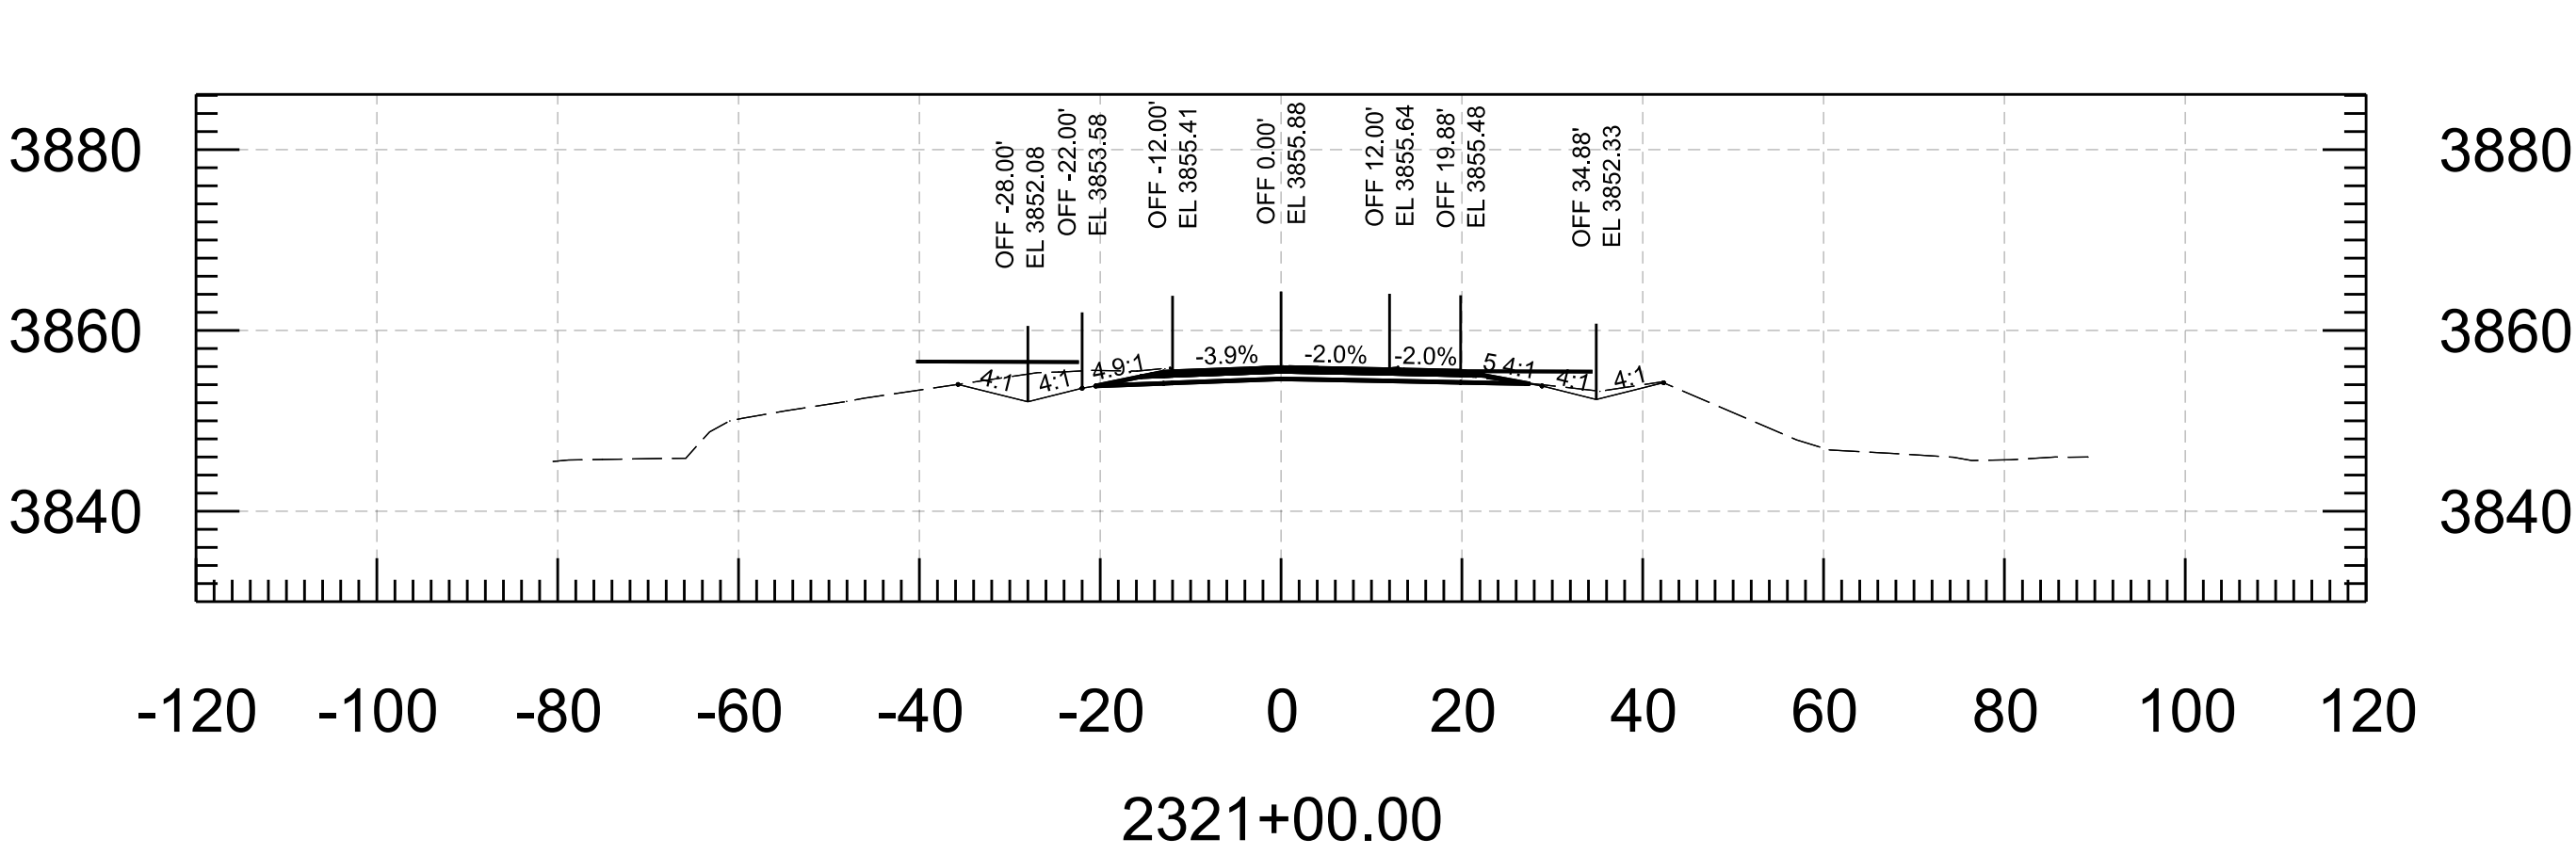

PRELIMINARY
STAGE V
Review
NOT FOR
CONSTRUCTION
OR RECORDING

	NAME	DATE
DESIGN	I. BYSTROV	3/26
DRAWN	P. MEEK	3/26
CHECKED	E. EGGEN	3/26
TEAM LEADER	E. EGGEN	3/26

ARIZONA DEPARTMENT OF TRANSPORTATION
PROJECT DELIVERY AND OPERATIONS DIVISION
ROADWAY DESIGN SECTION

CROSS SECTIONS

ROUTE
SR 82

MILEPOST

STRUCTURE NO.

F.H.W.A. Arizona Division

STATE
ARIZ.

PROJECT NO.
082 CH 061

FEDERAL ID NO.
082-A(210)T

SHEET
NO.

TOTAL
SHEETS







RECORD
DRAWING

LOCATION
SAN PEDRO RIVER BRIDGE NO. 20310

TRACS NO. **F0522 01C**

SHEET OF

OF OF

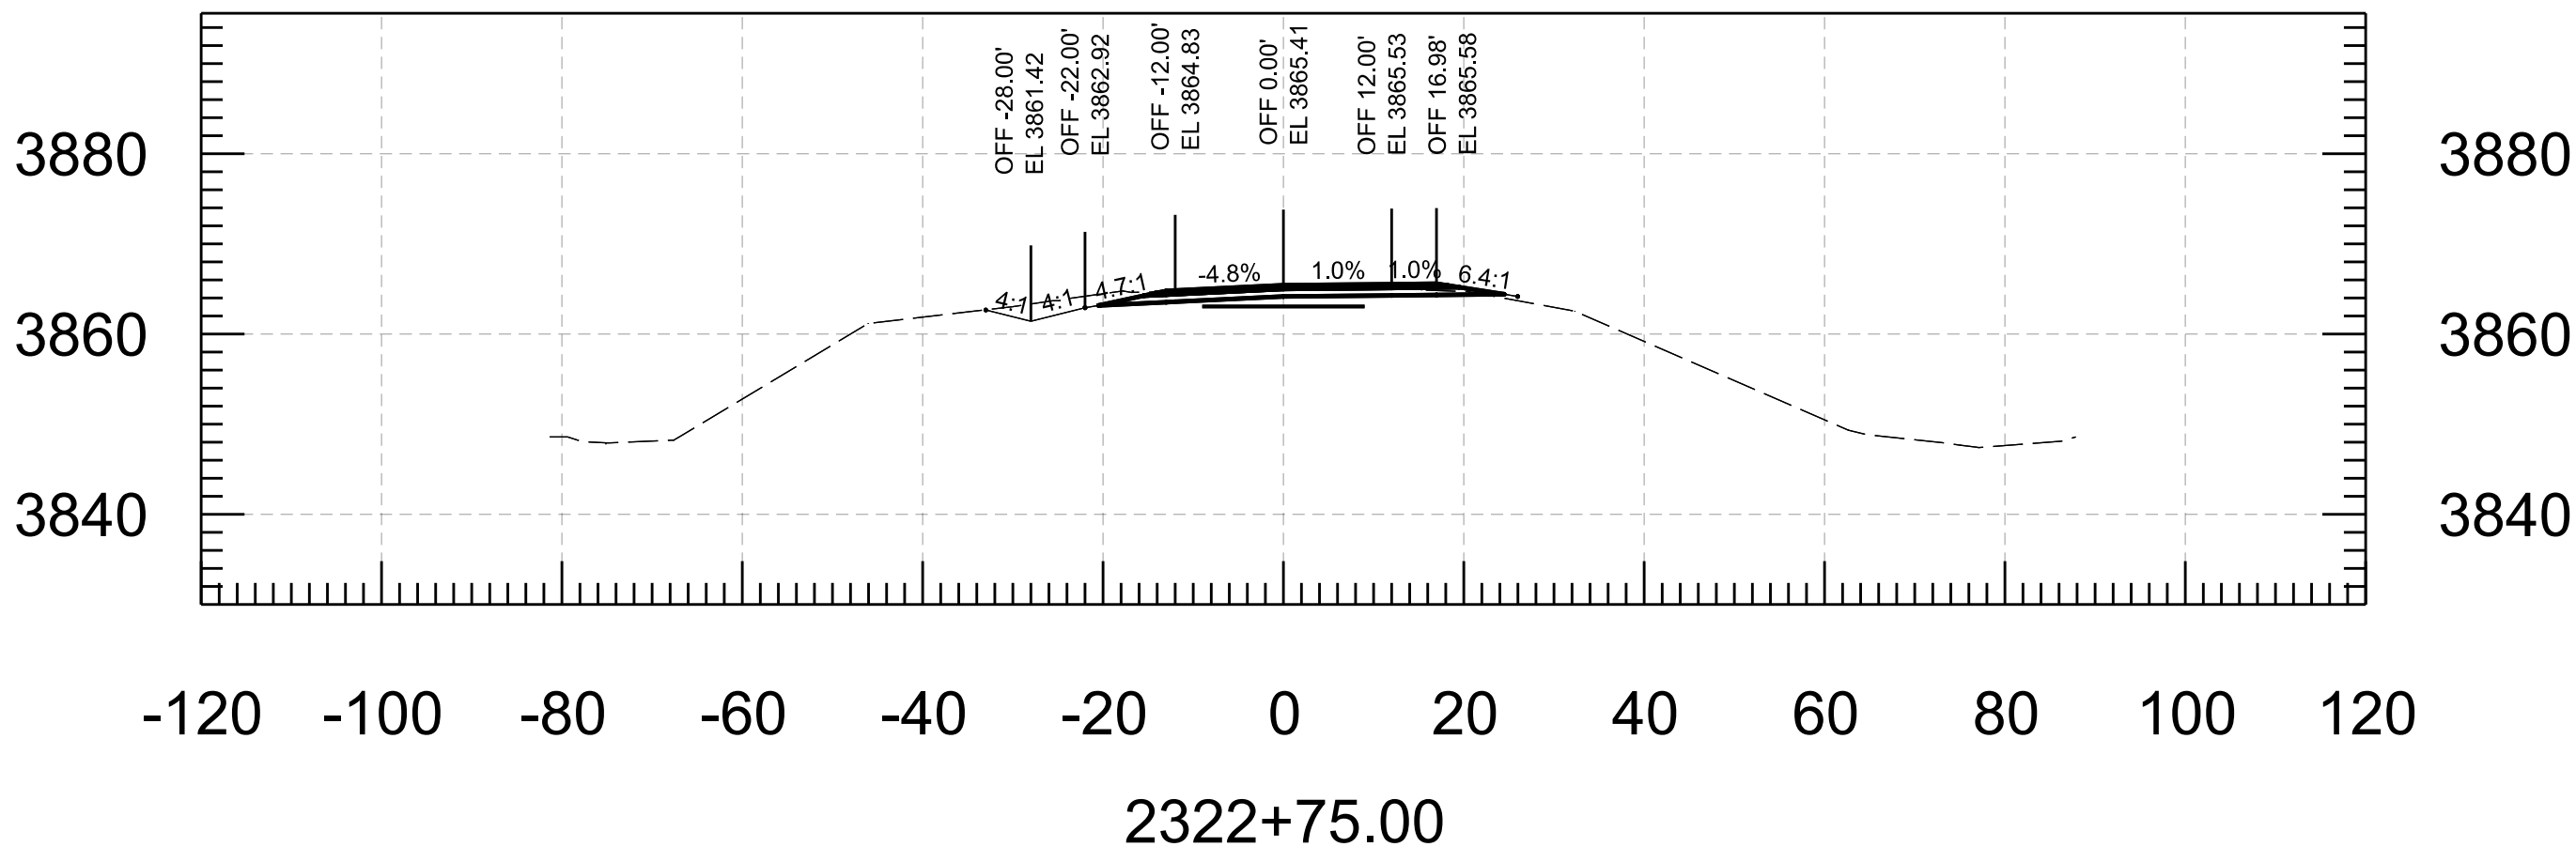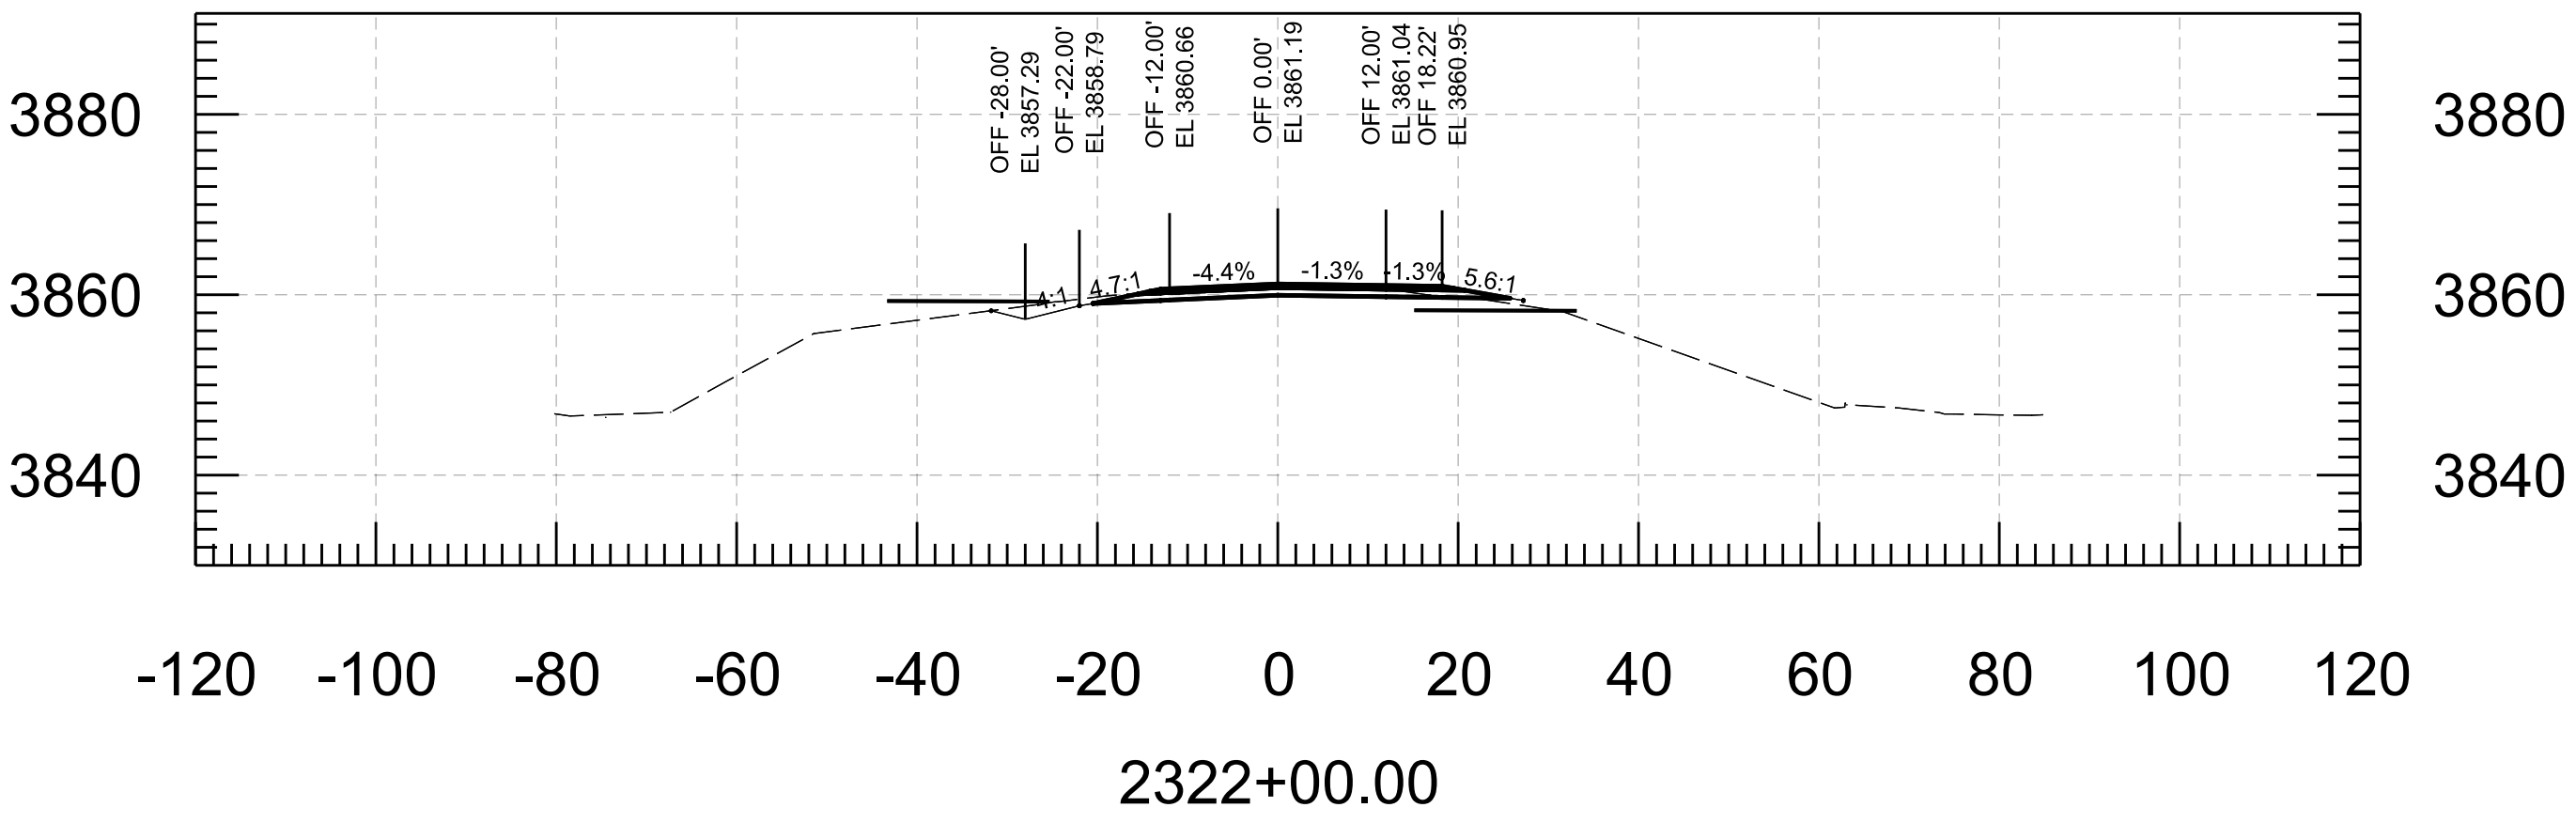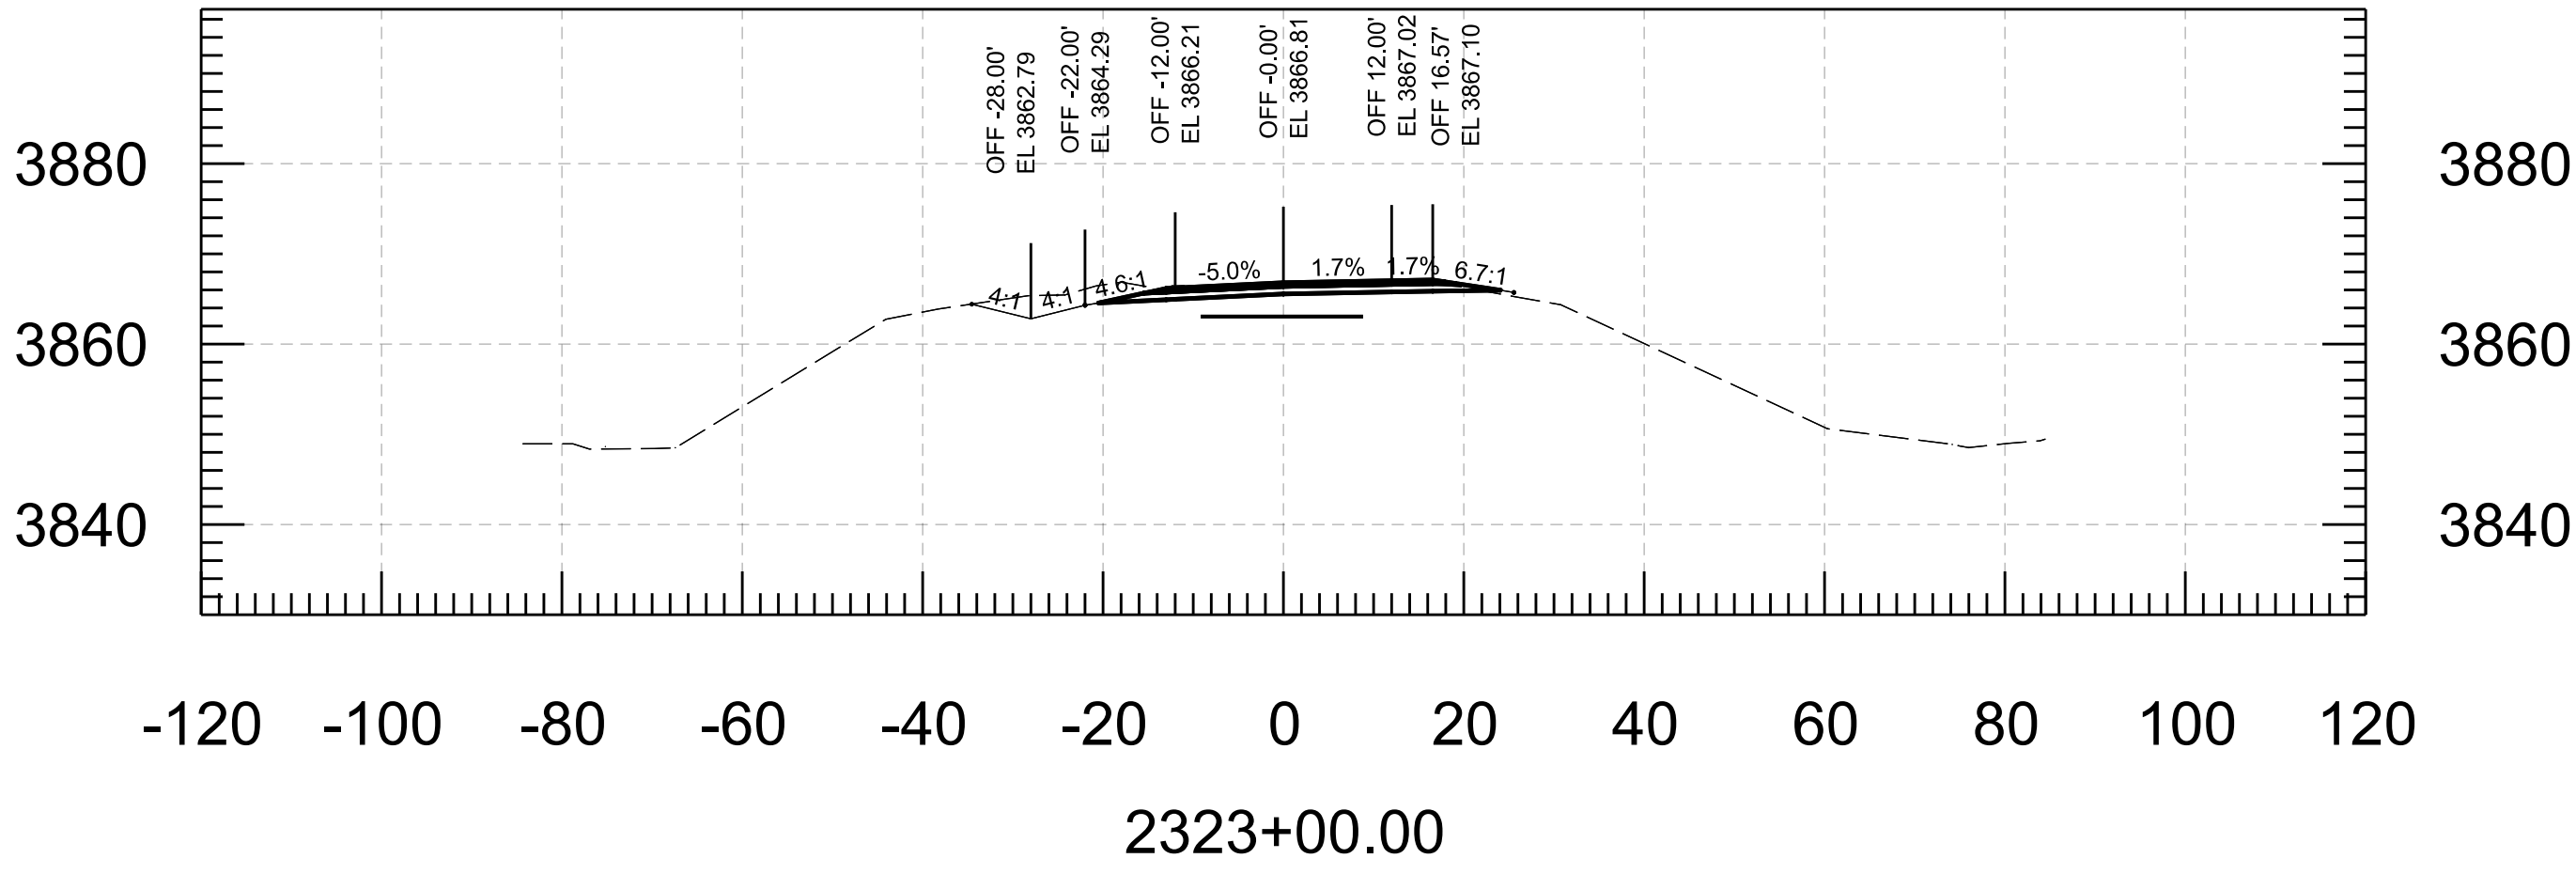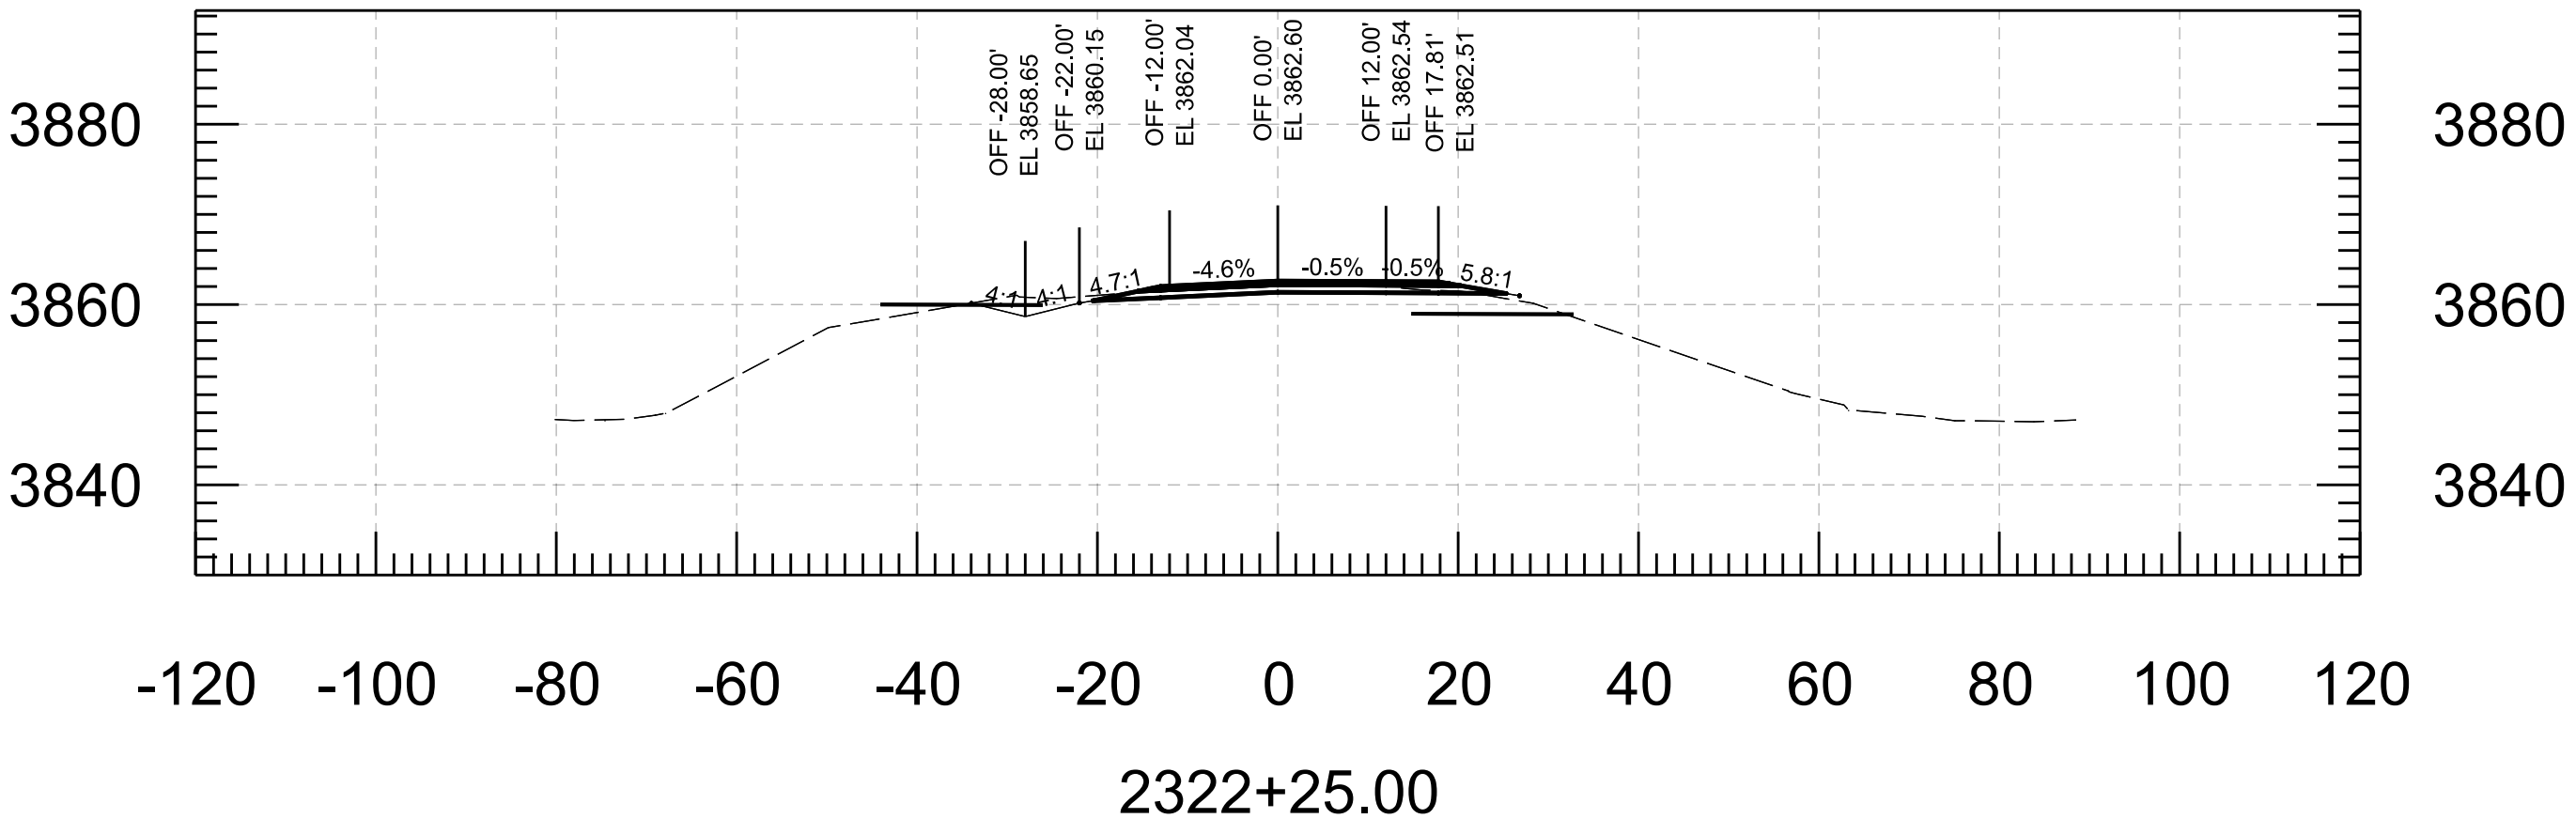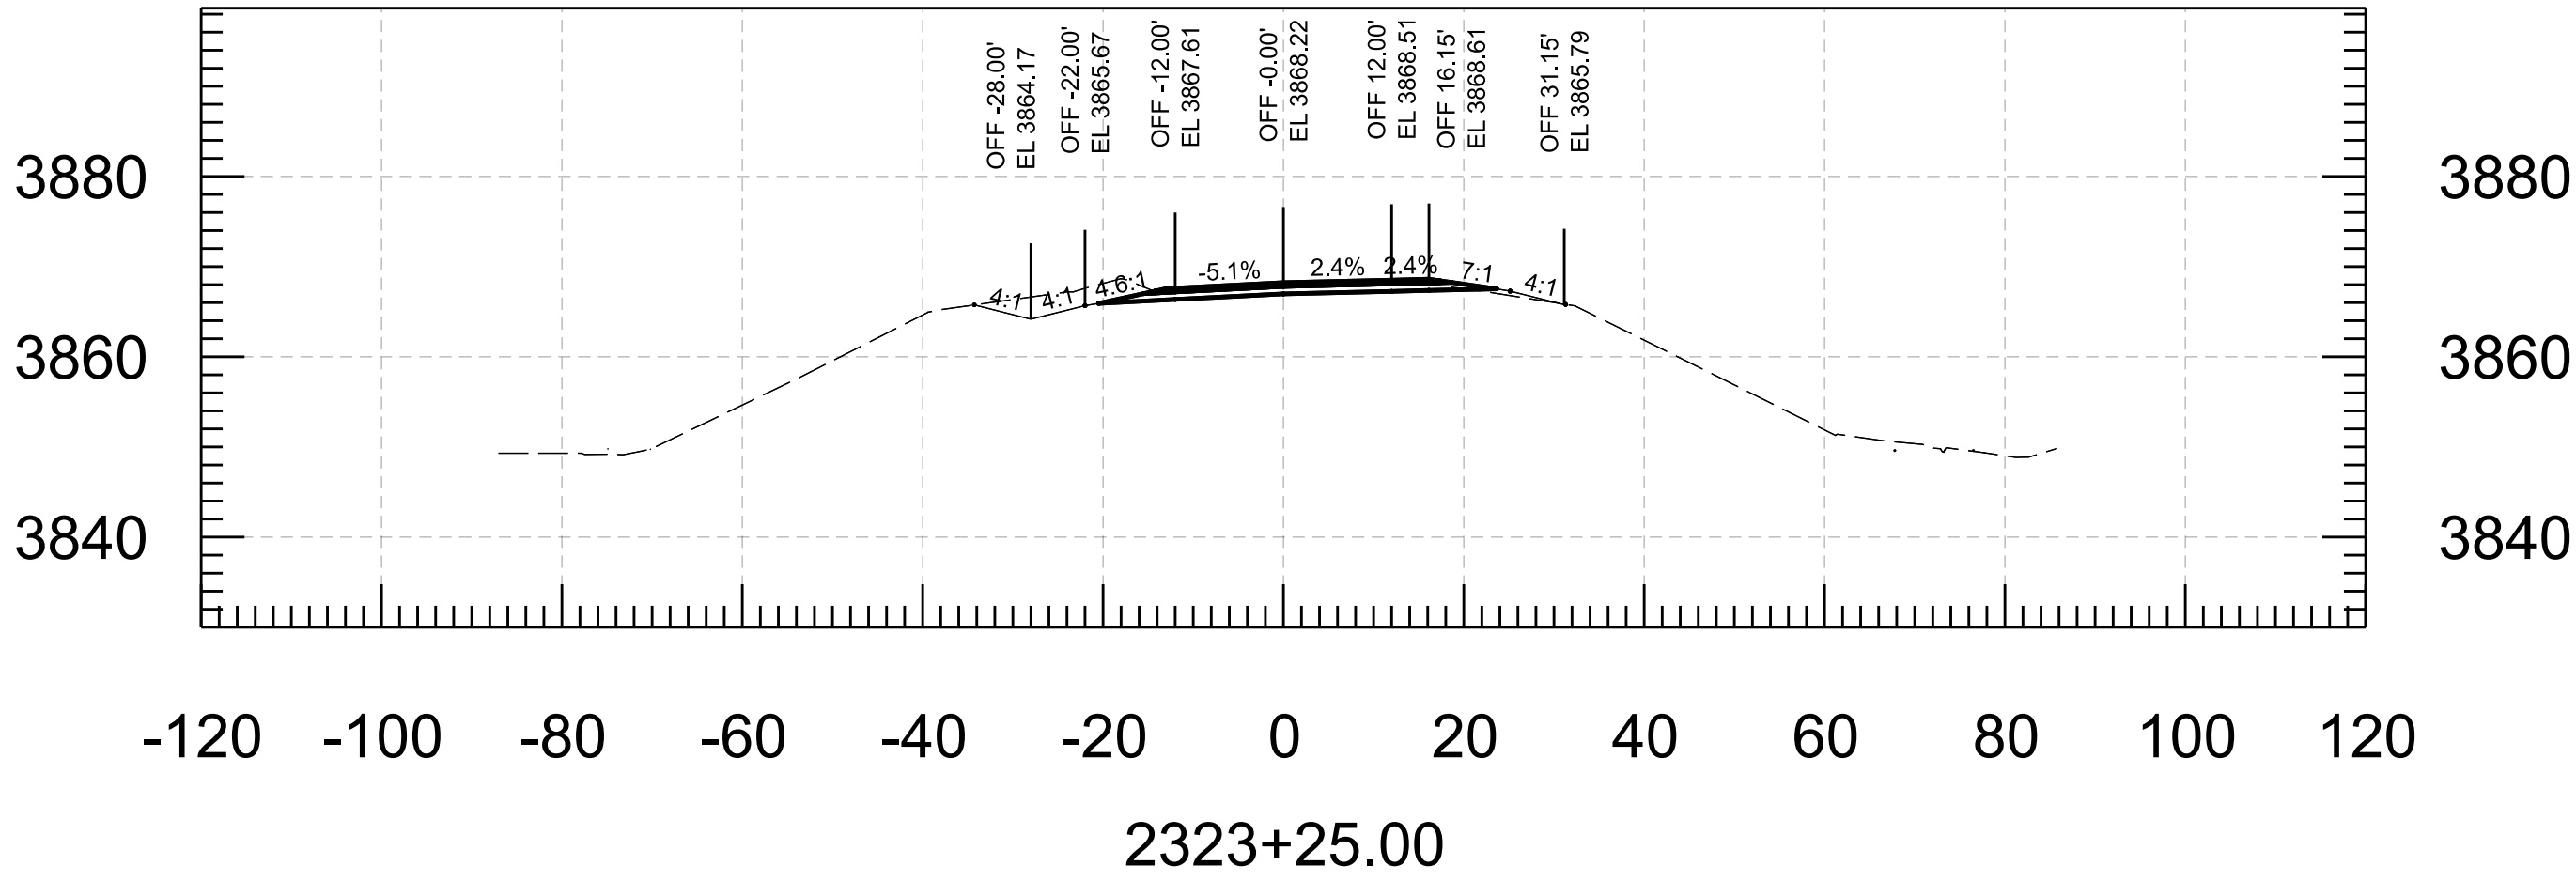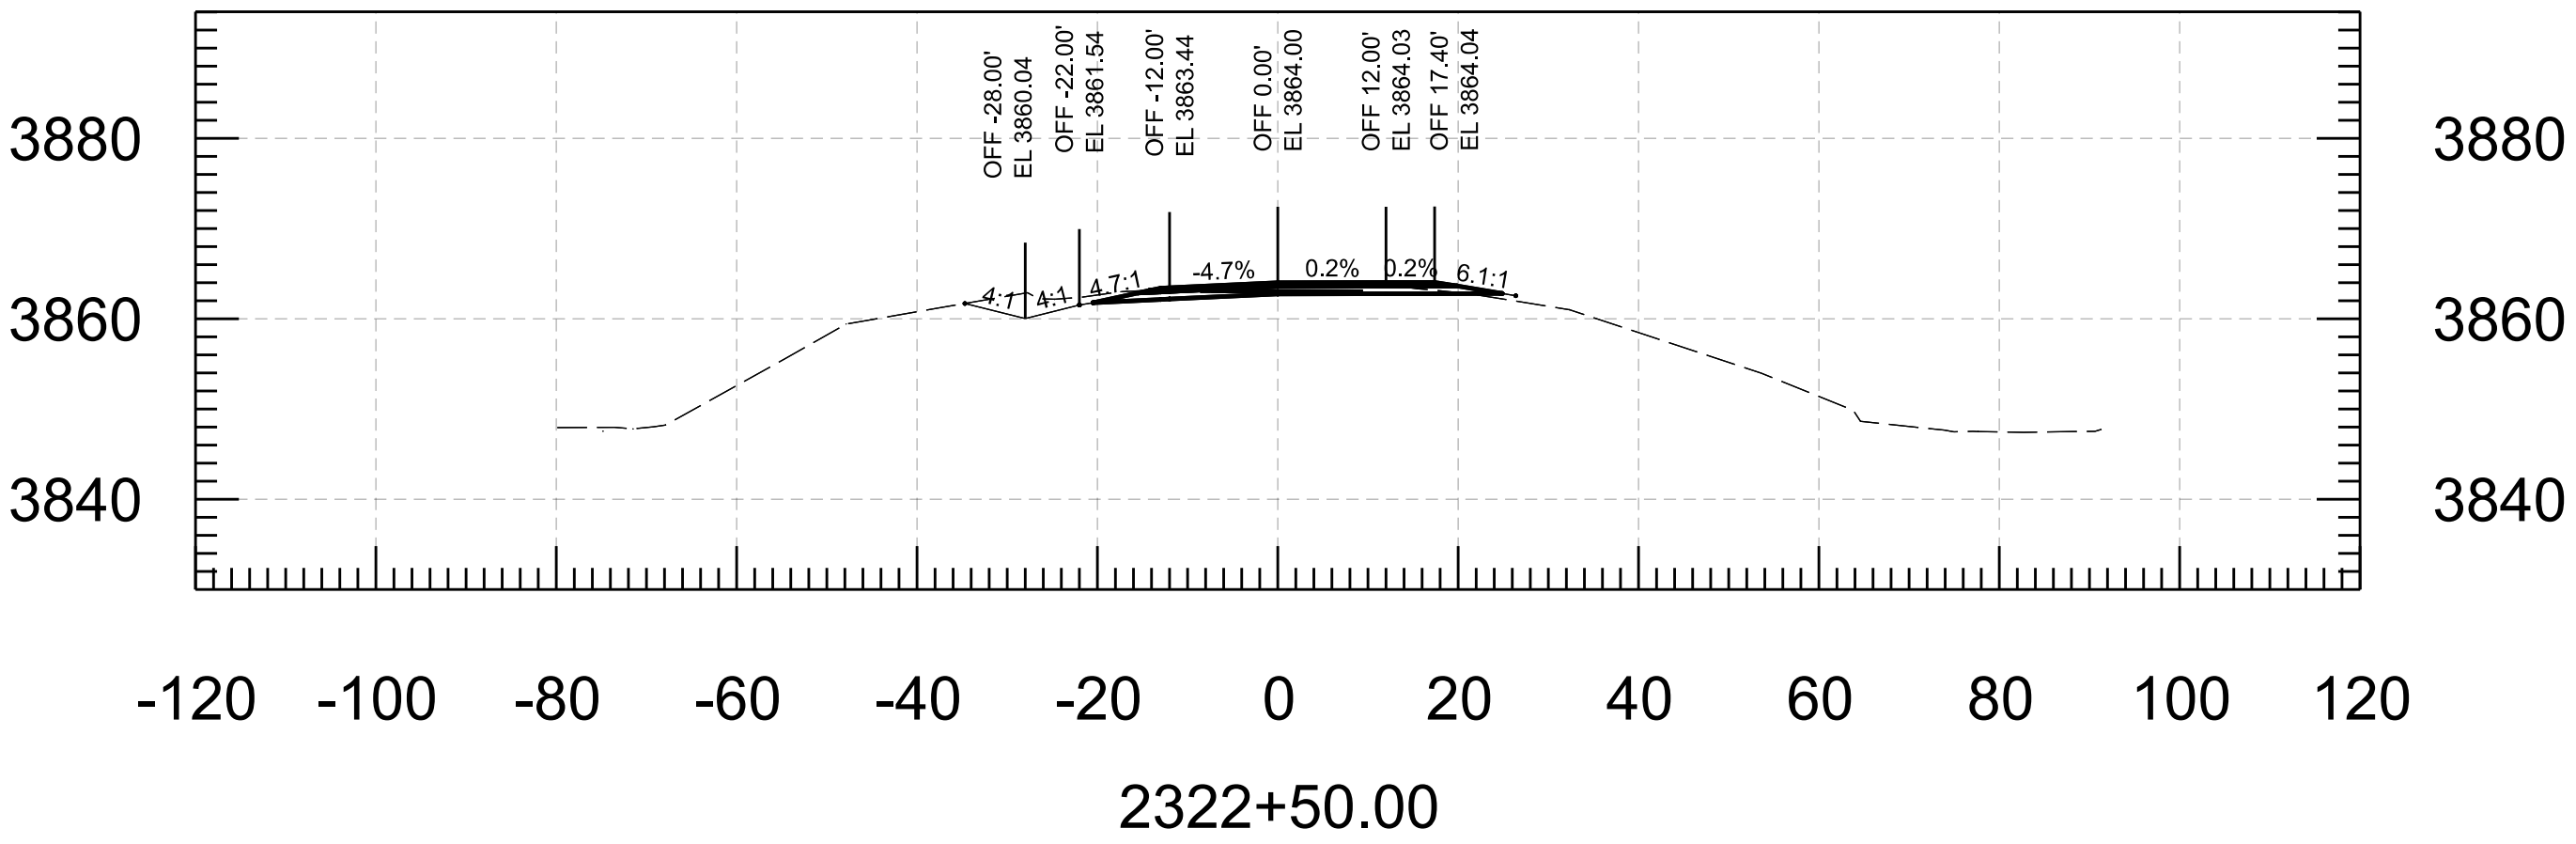

PRELIMINARY
STAGE V
Review
NOT FOR
CONSTRUCTION
OR RECORDING

	NAME	DATE
DESIGN	I. BYSTROV	3/26
DRAWN	P. MEEK	3/26
CHECKED	E. EGGEN	3/26
TEAM LEADER	E. EGGEN	3/26

ARIZONA DEPARTMENT OF TRANSPORTATION
PROJECT DELIVERY AND OPERATIONS DIVISION
ROADWAY DESIGN SECTION

CROSS SECTIONS

ROUTE
SR 82

MILEPOST

STRUCTURE NO.

F.H.W.A. Arizona Division

STATE
ARIZ.

PROJECT NO.
082 CH 061

FEDERAL ID NO.
082-A(210)T

SHEET
NO.

7

TOTAL
SHEETS

9







RECORD DRAWING

LOCATION
SAN PEDRO RIVER BRIDGE NO. 20310



TRACS NO. **F0522 01C**

SHEET OF

___ OF ___

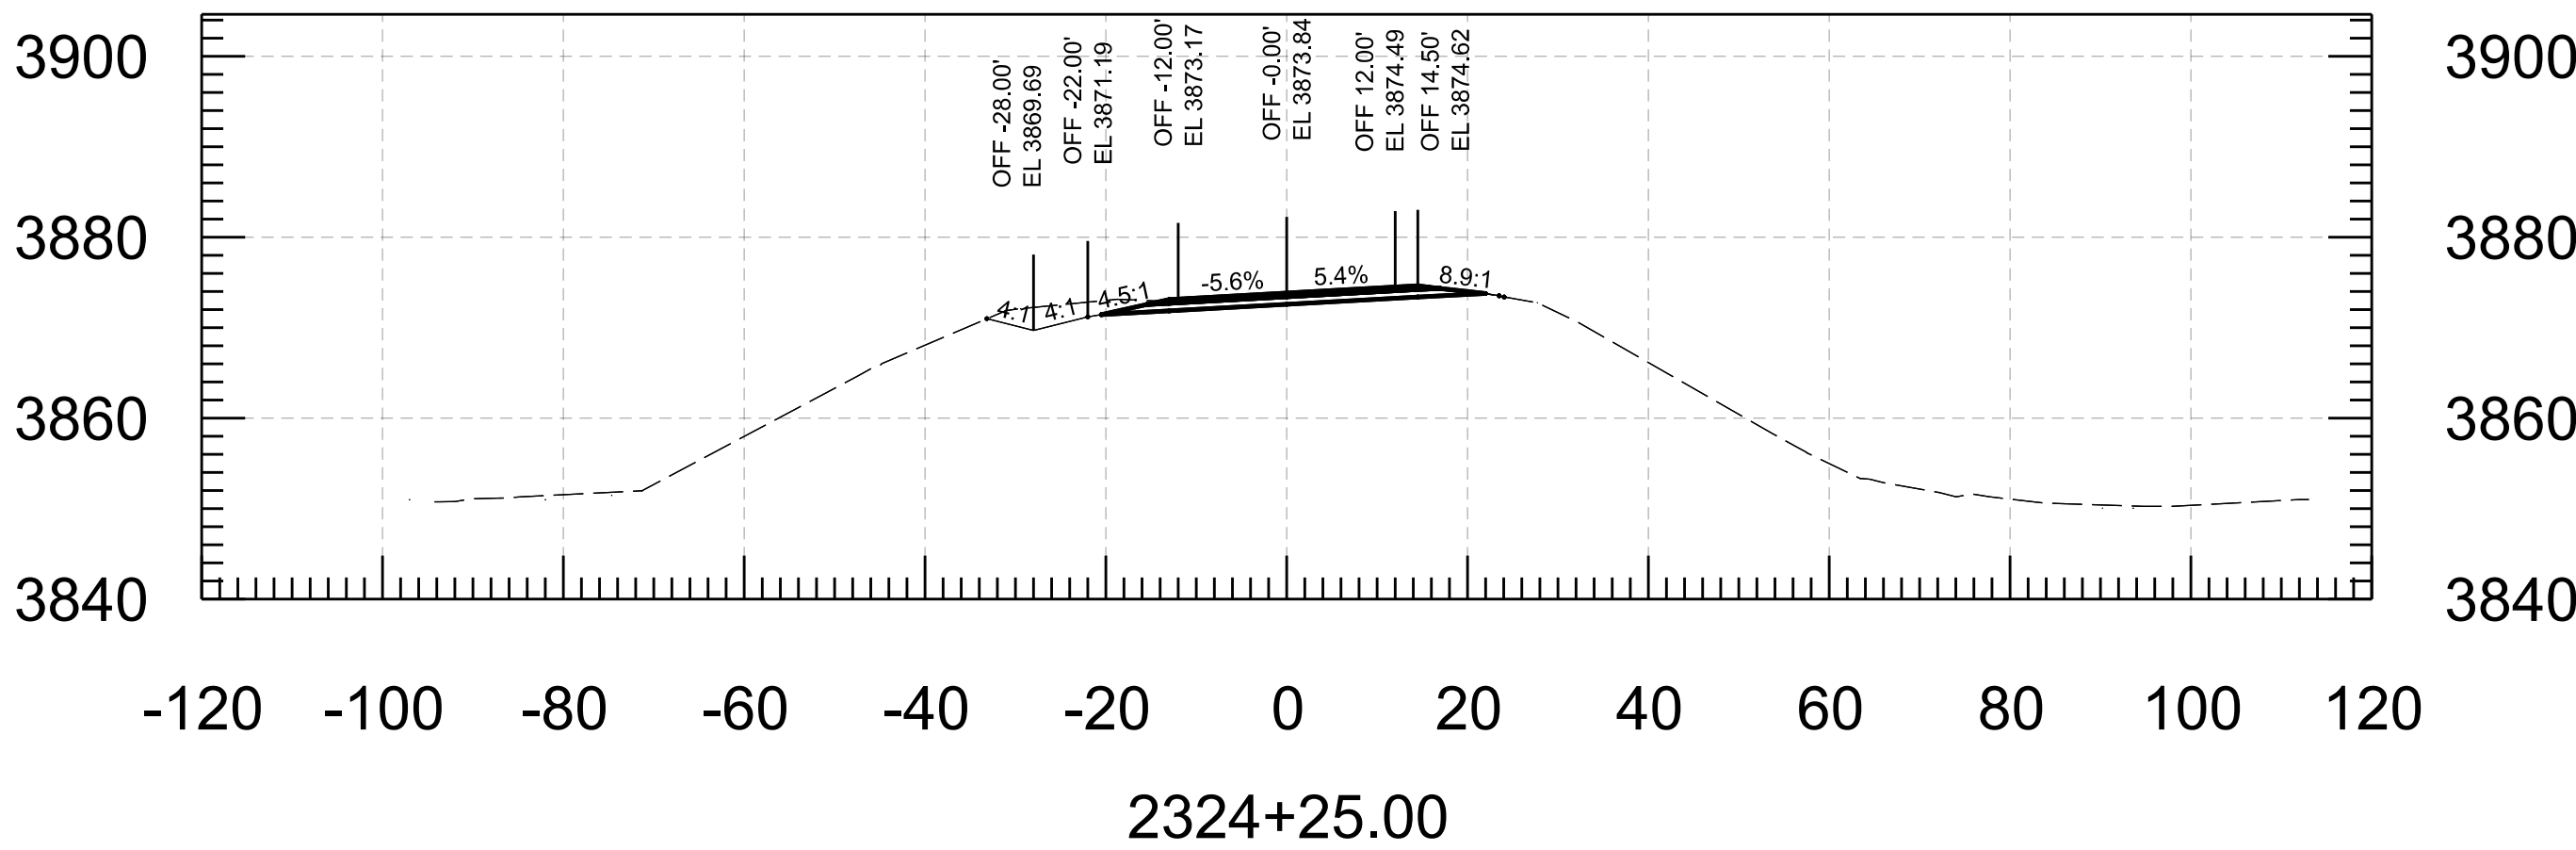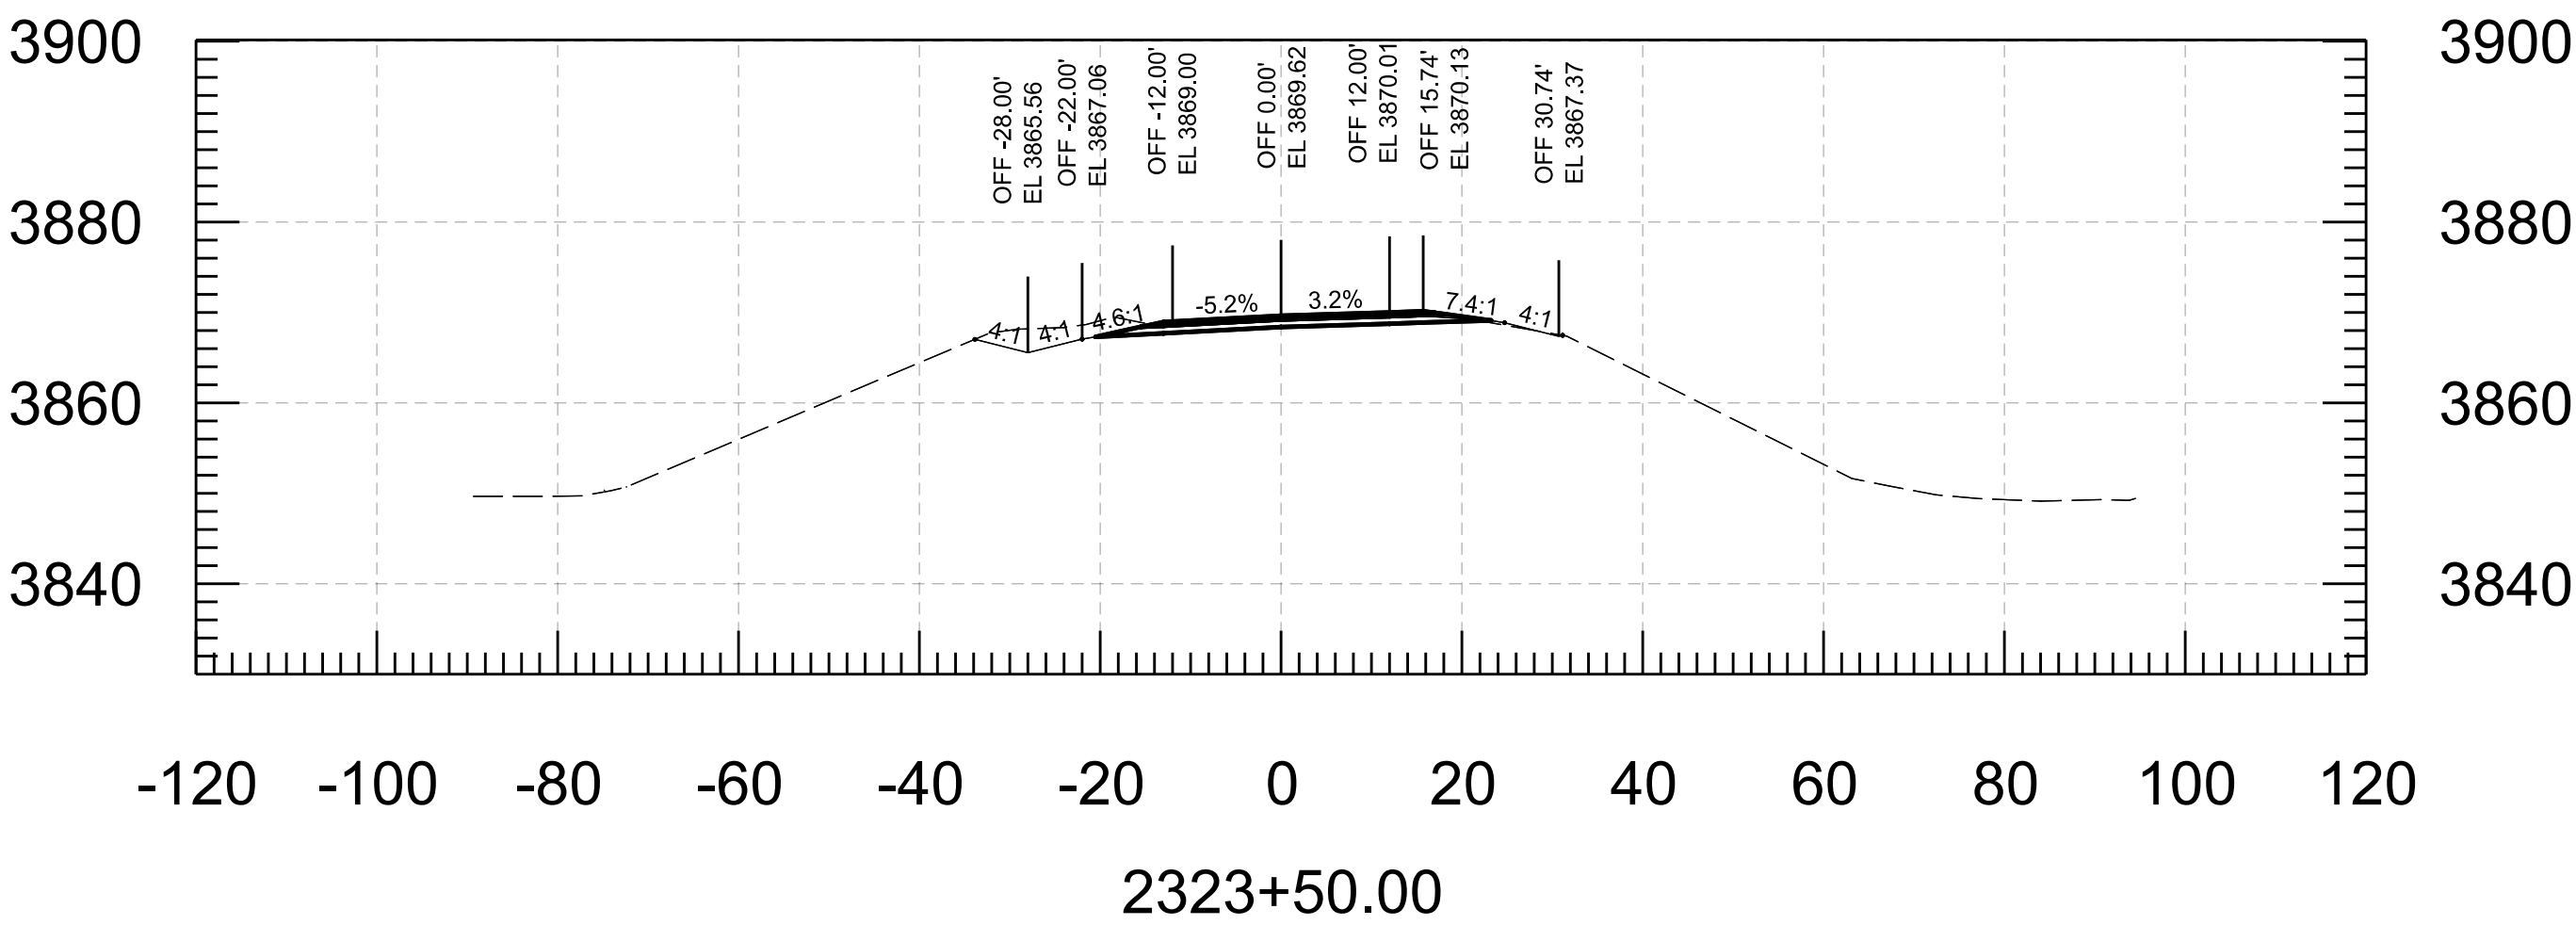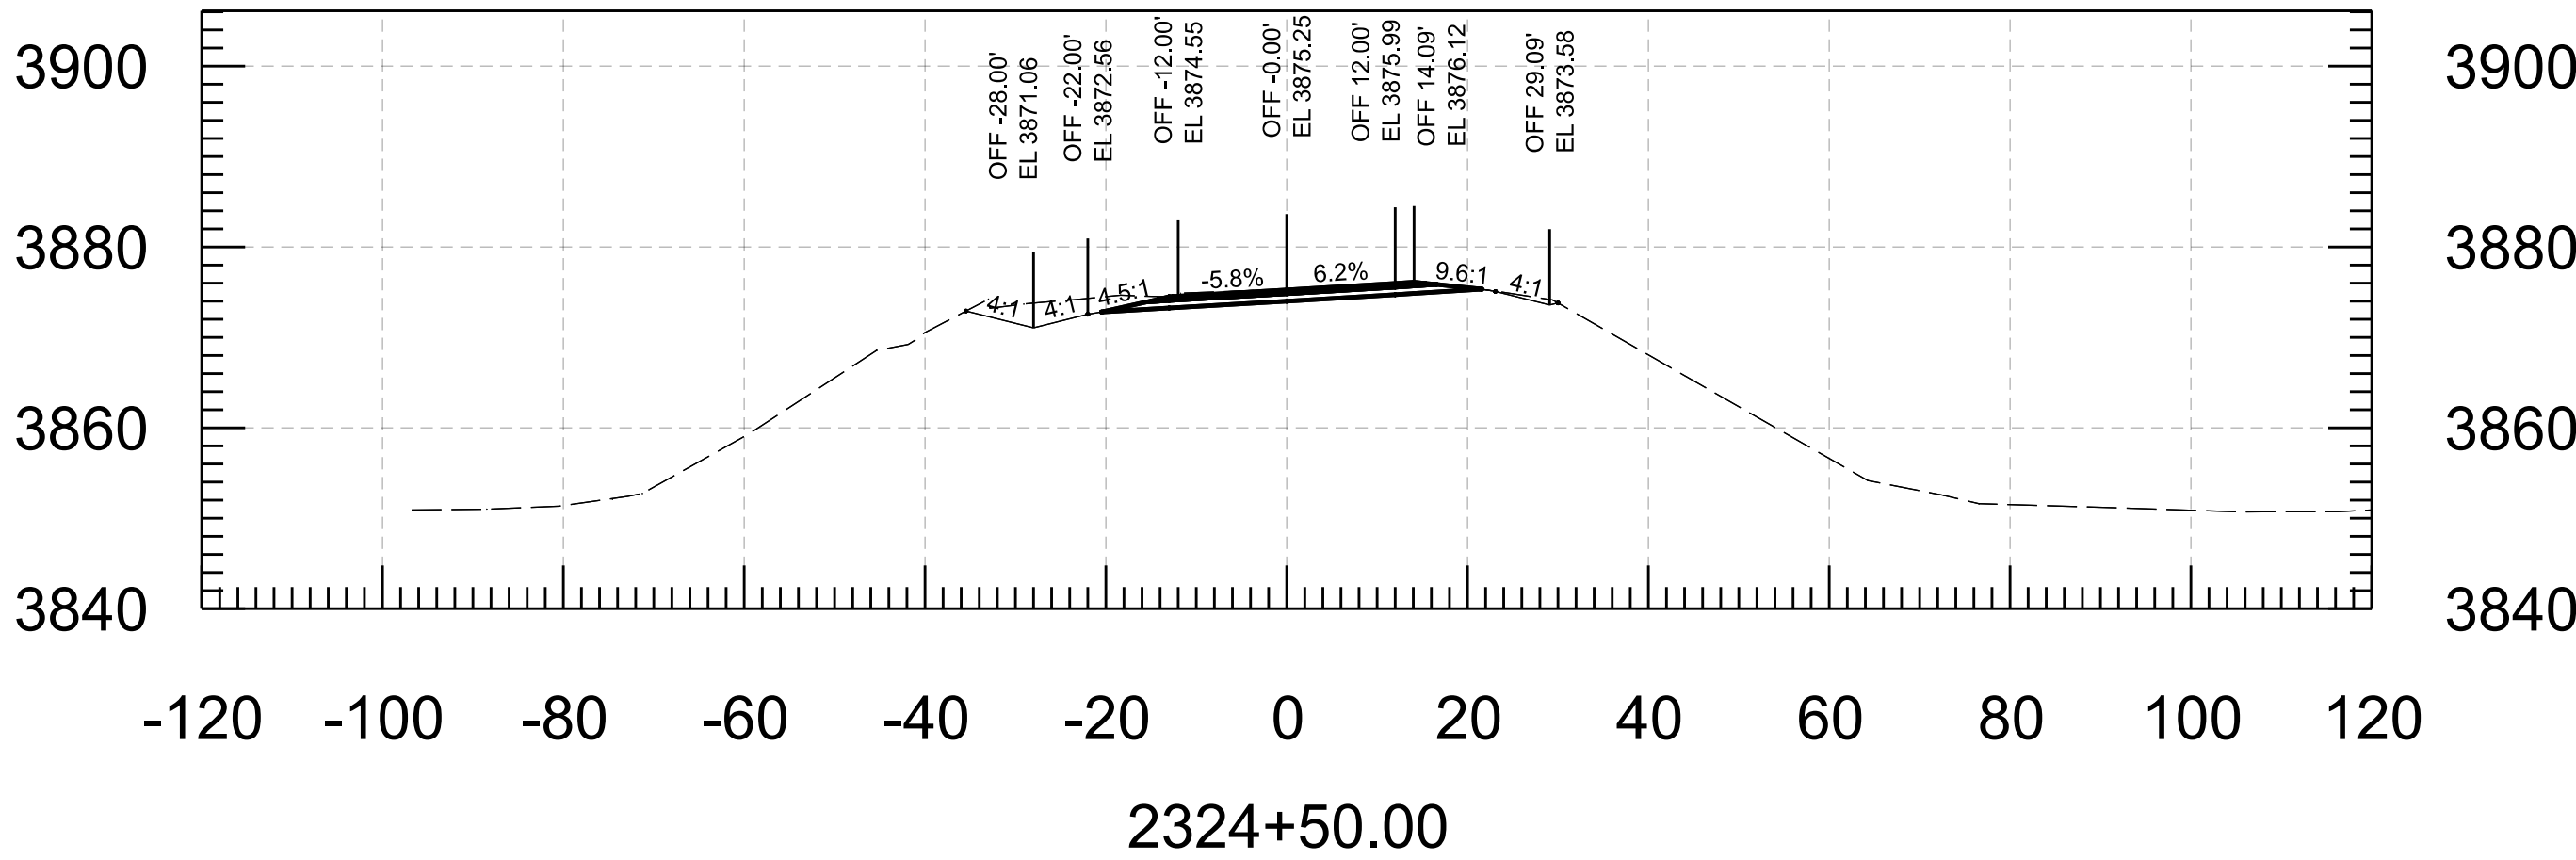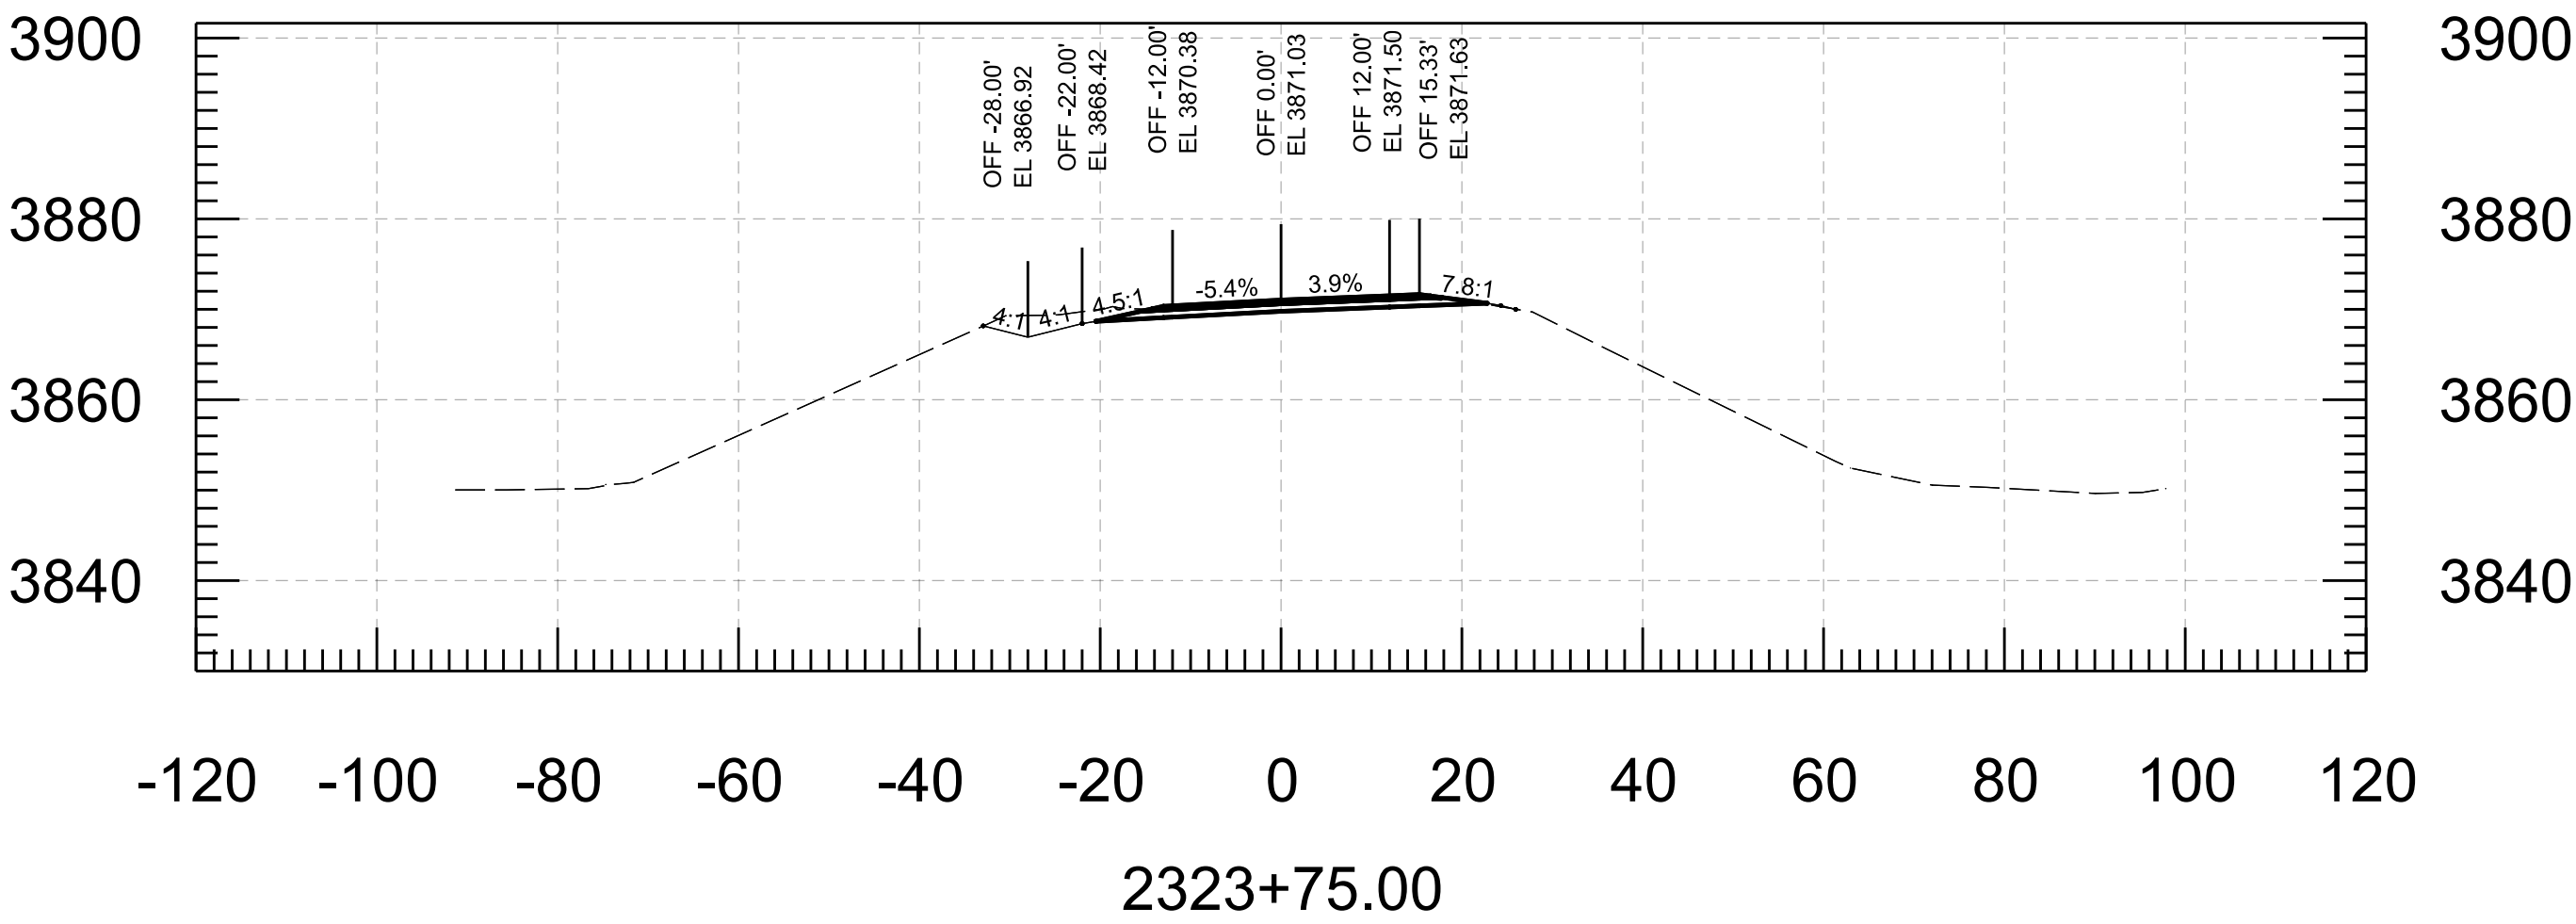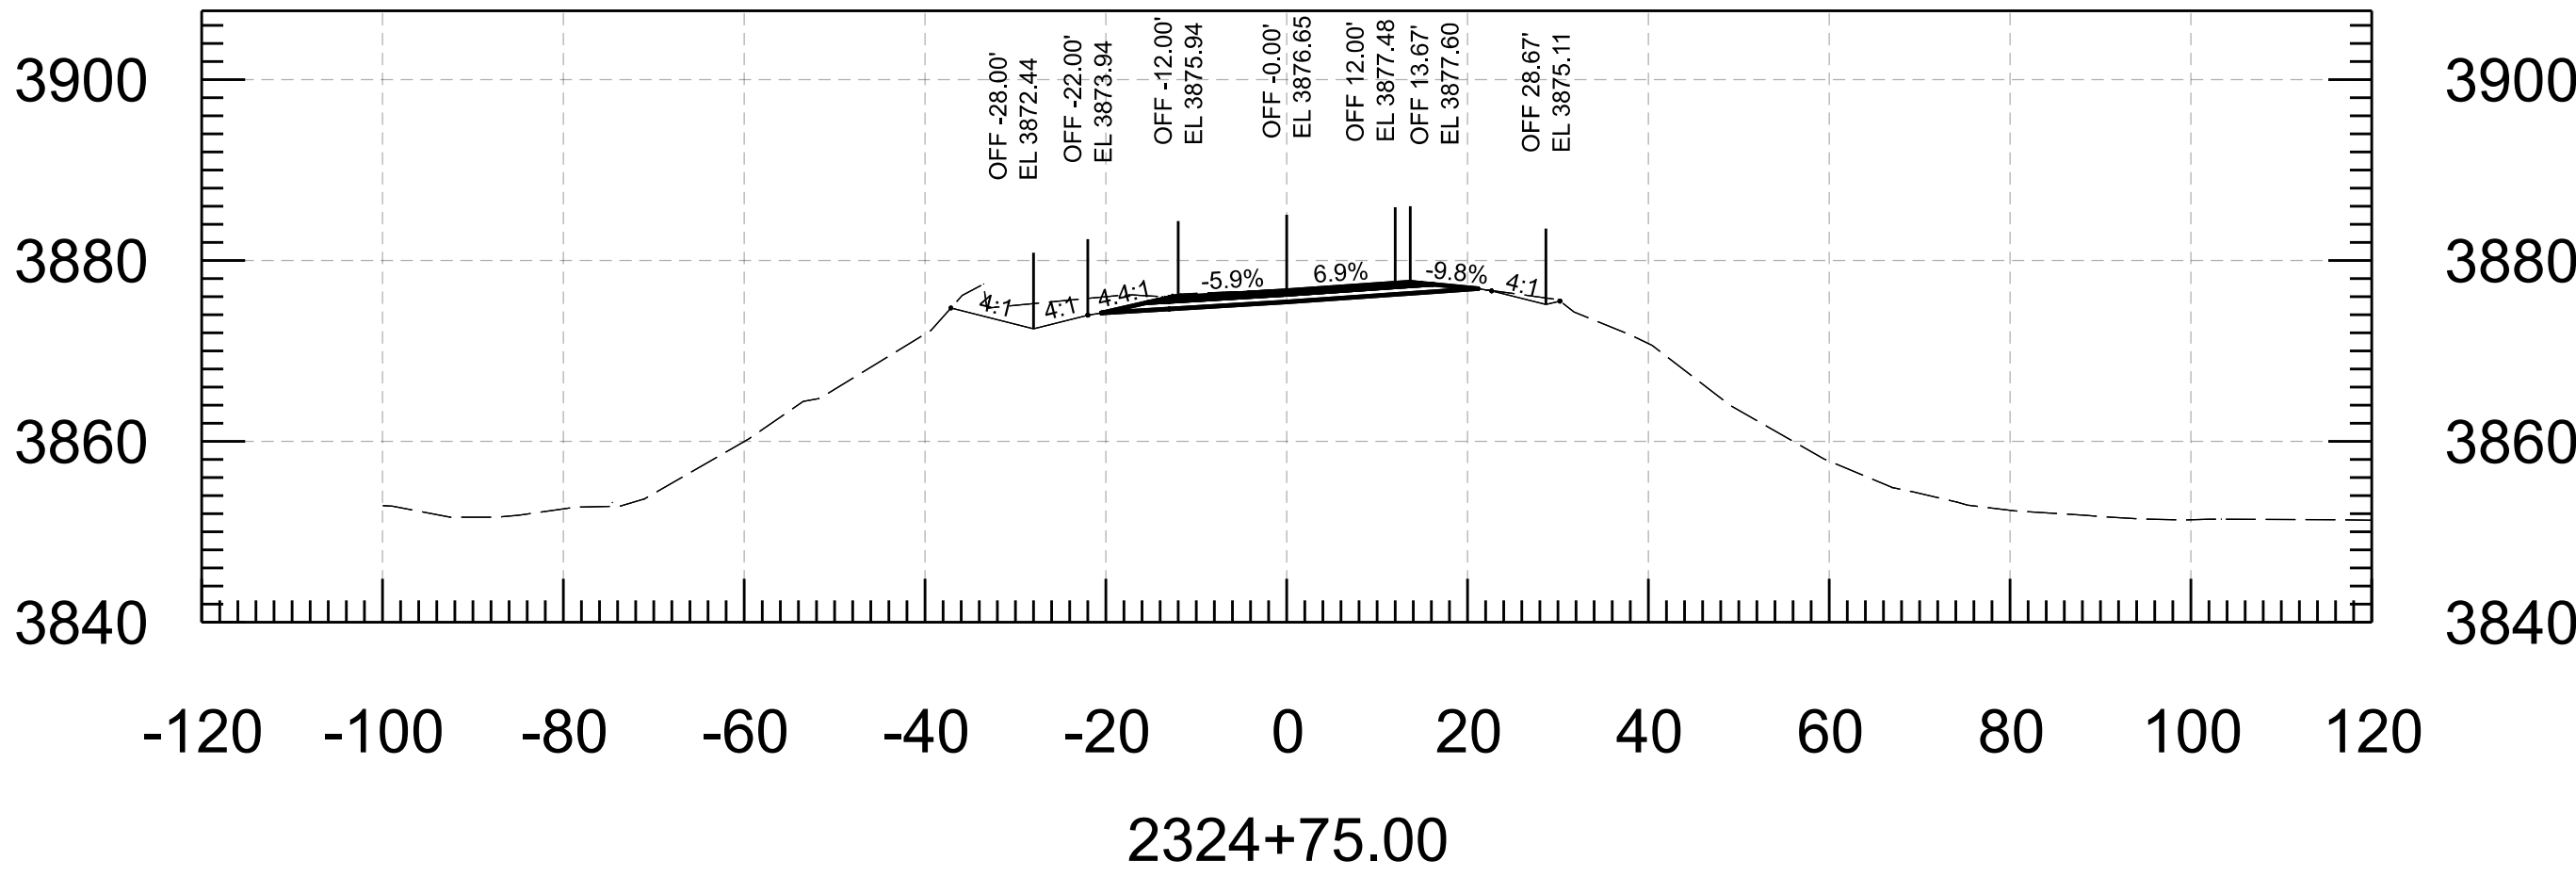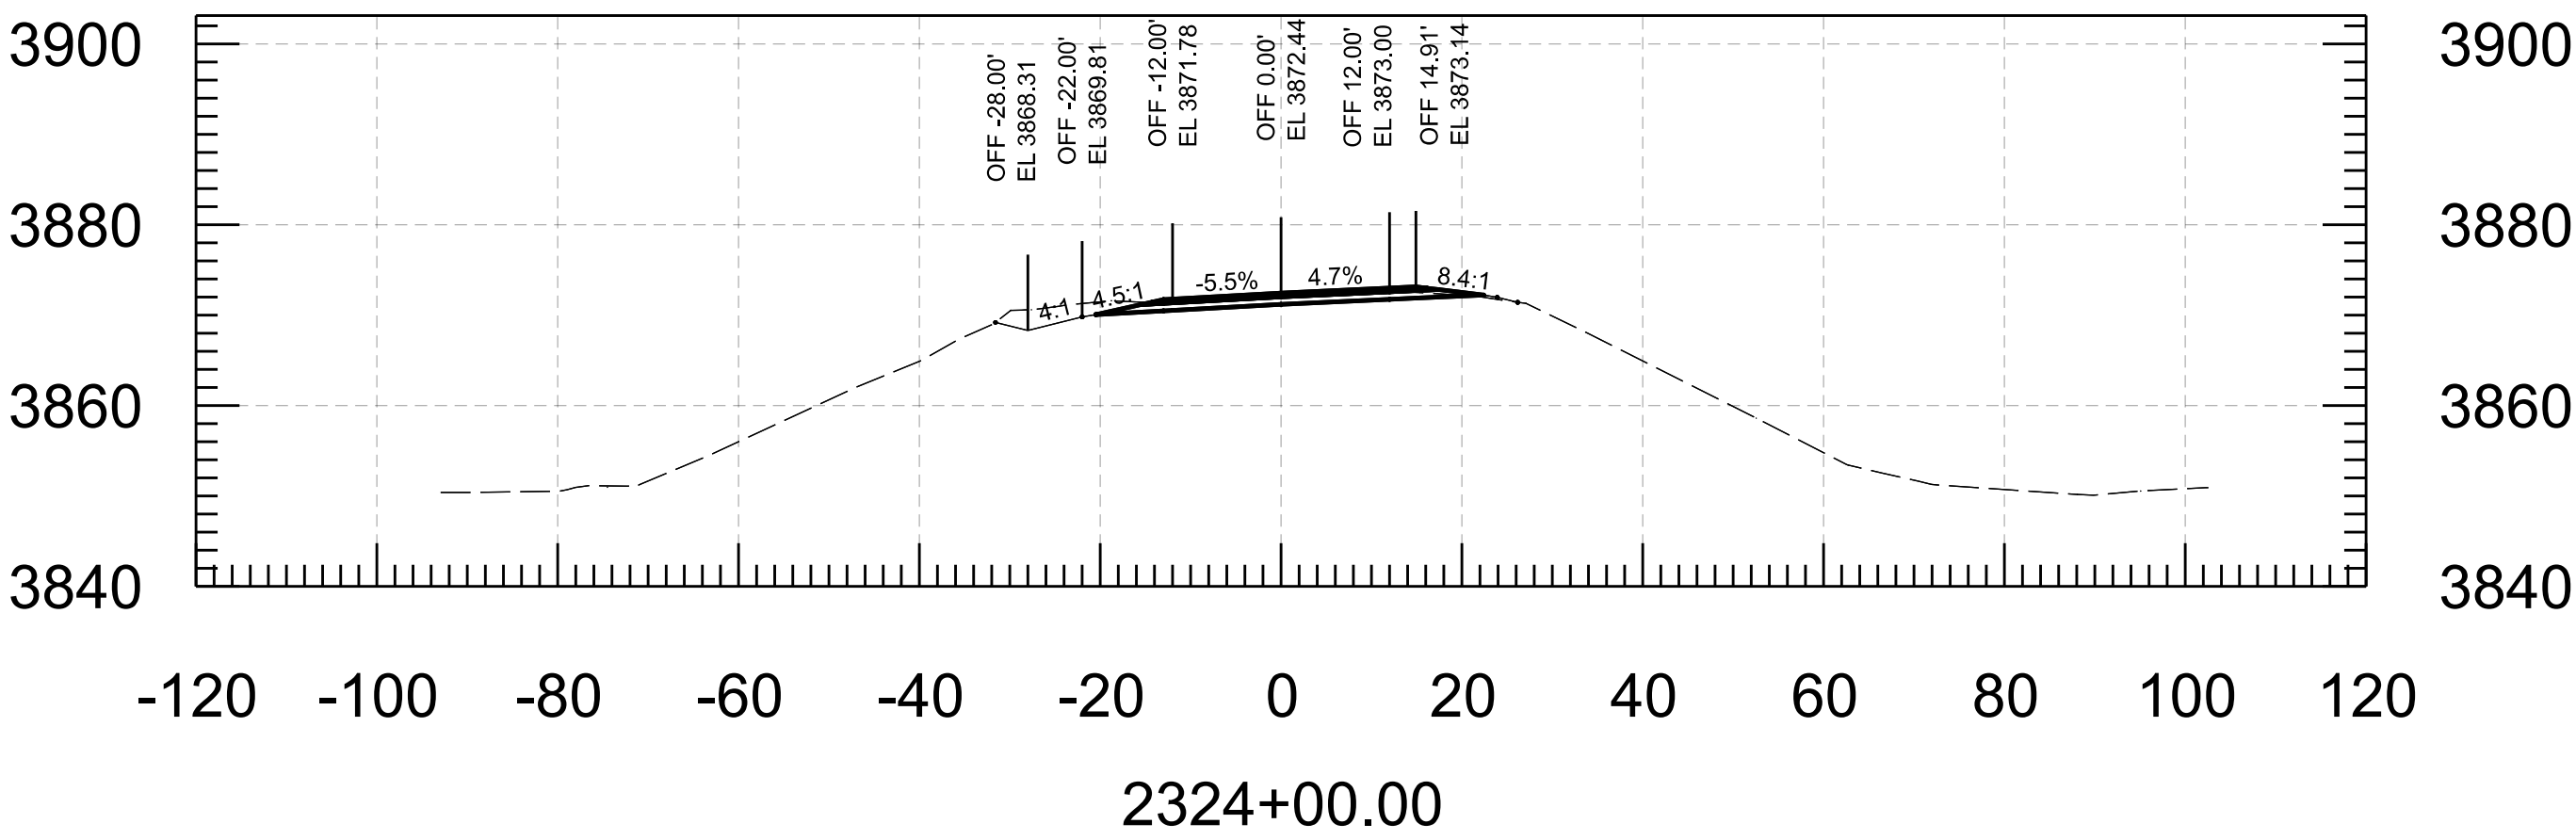

	PRELIMINARY STAGE V Review NOT FOR CONSTRUCTION OR RECORDING		NAME	DATE	ARIZONA DEPARTMENT OF TRANSPORTATION PROJECT DELIVERY AND OPERATIONS DIVISION ROADWAY DESIGN SECTION	ROUTE	F.H.W.A. Arizona Division	STATE	PROJECT NO.	FEDERAL ID NO.	SHEET NO.	TOTAL SHEETS	RECORD DRAWING
		DESIGN	I. BYSTROV	3/26		SR 82			082 CH 061	082-A(210)T	8	9	
		DRAWN	P. MEEK	3/26			MILEPOST						
		CHECKED	E. EGGEN	3/26		STRUCTURE NO.							
		TEAM LEADER	E. EGGEN	3/26	CROSS SECTIONS		LOCATION	SAN PEDRO RIVER BRIDGE NO. 20310					SHEET
						TRACS NO.		F0522 01C			___ OF ___		

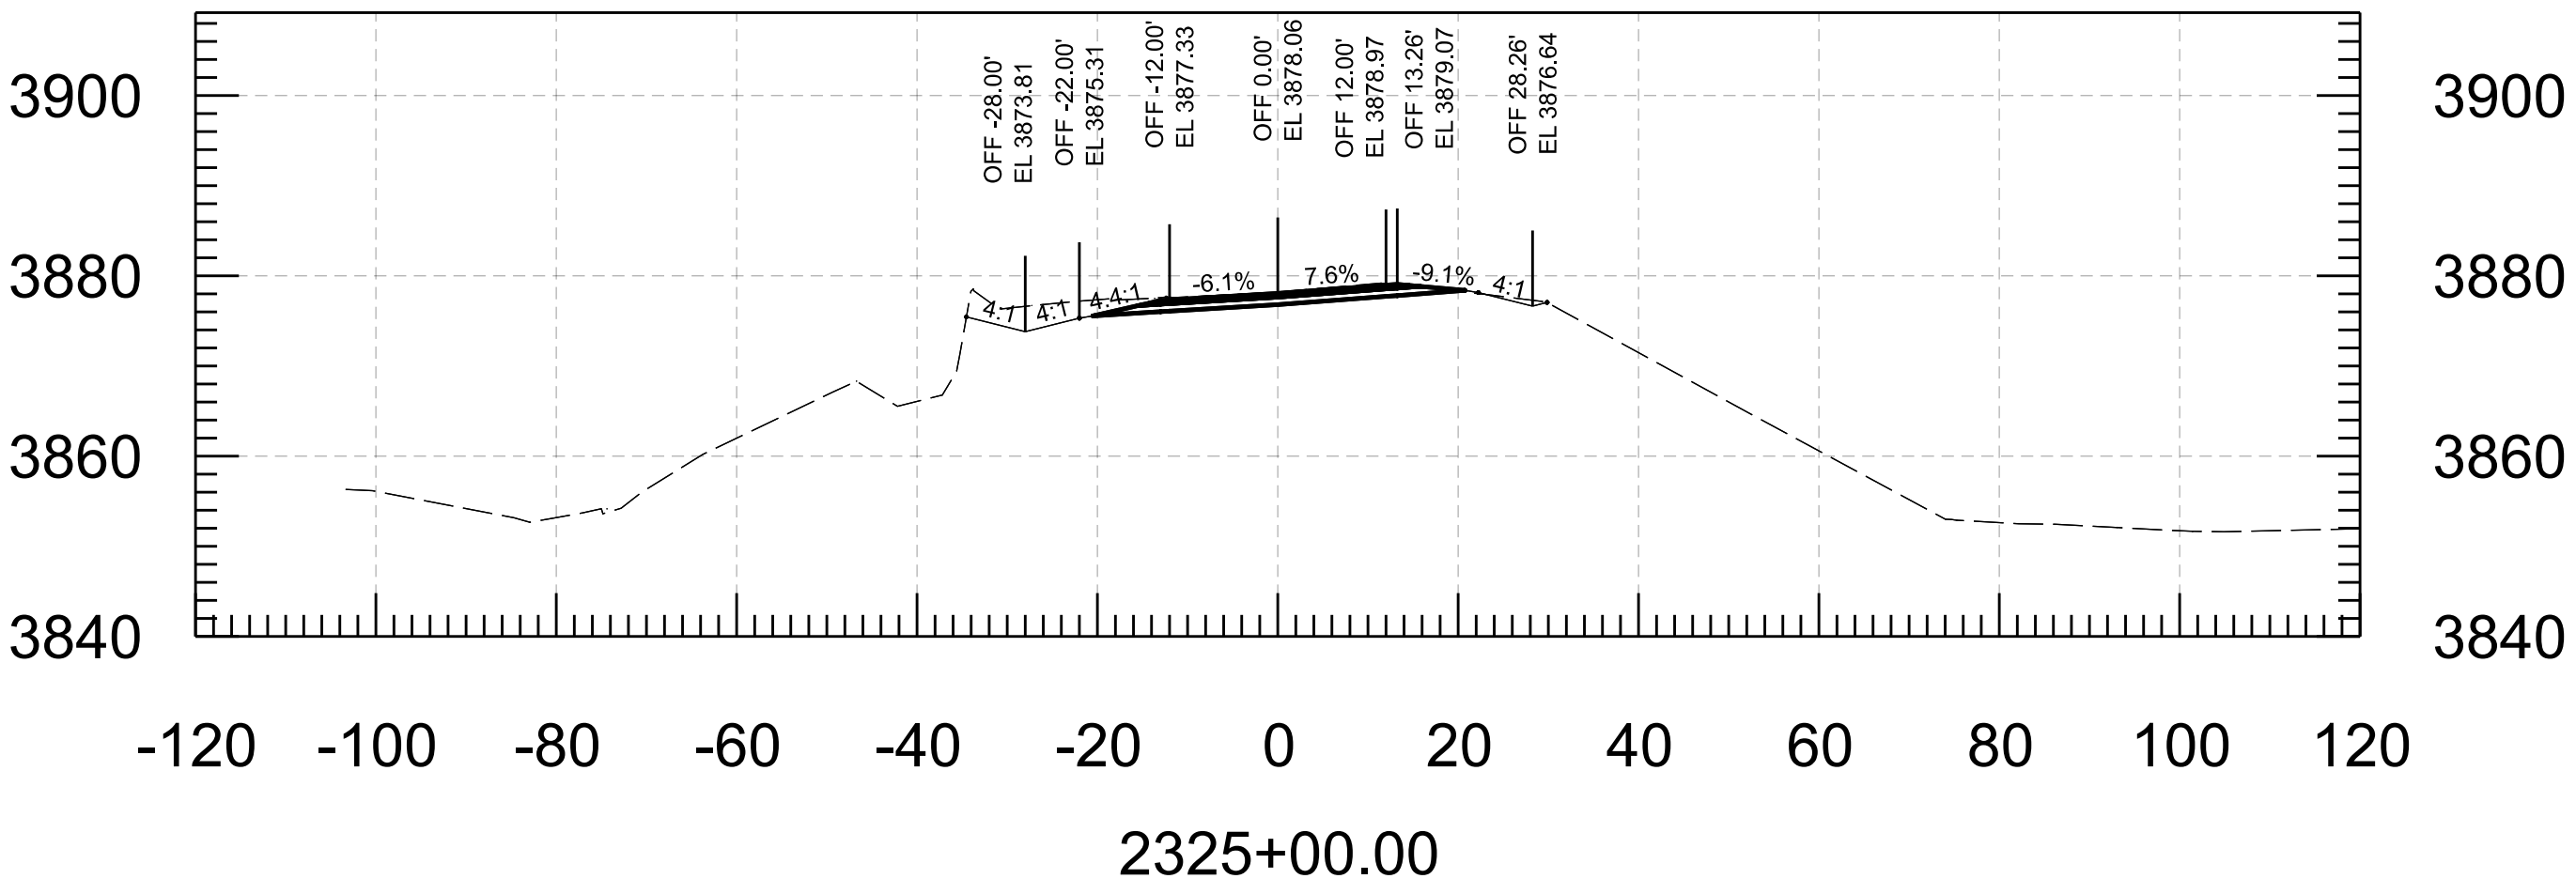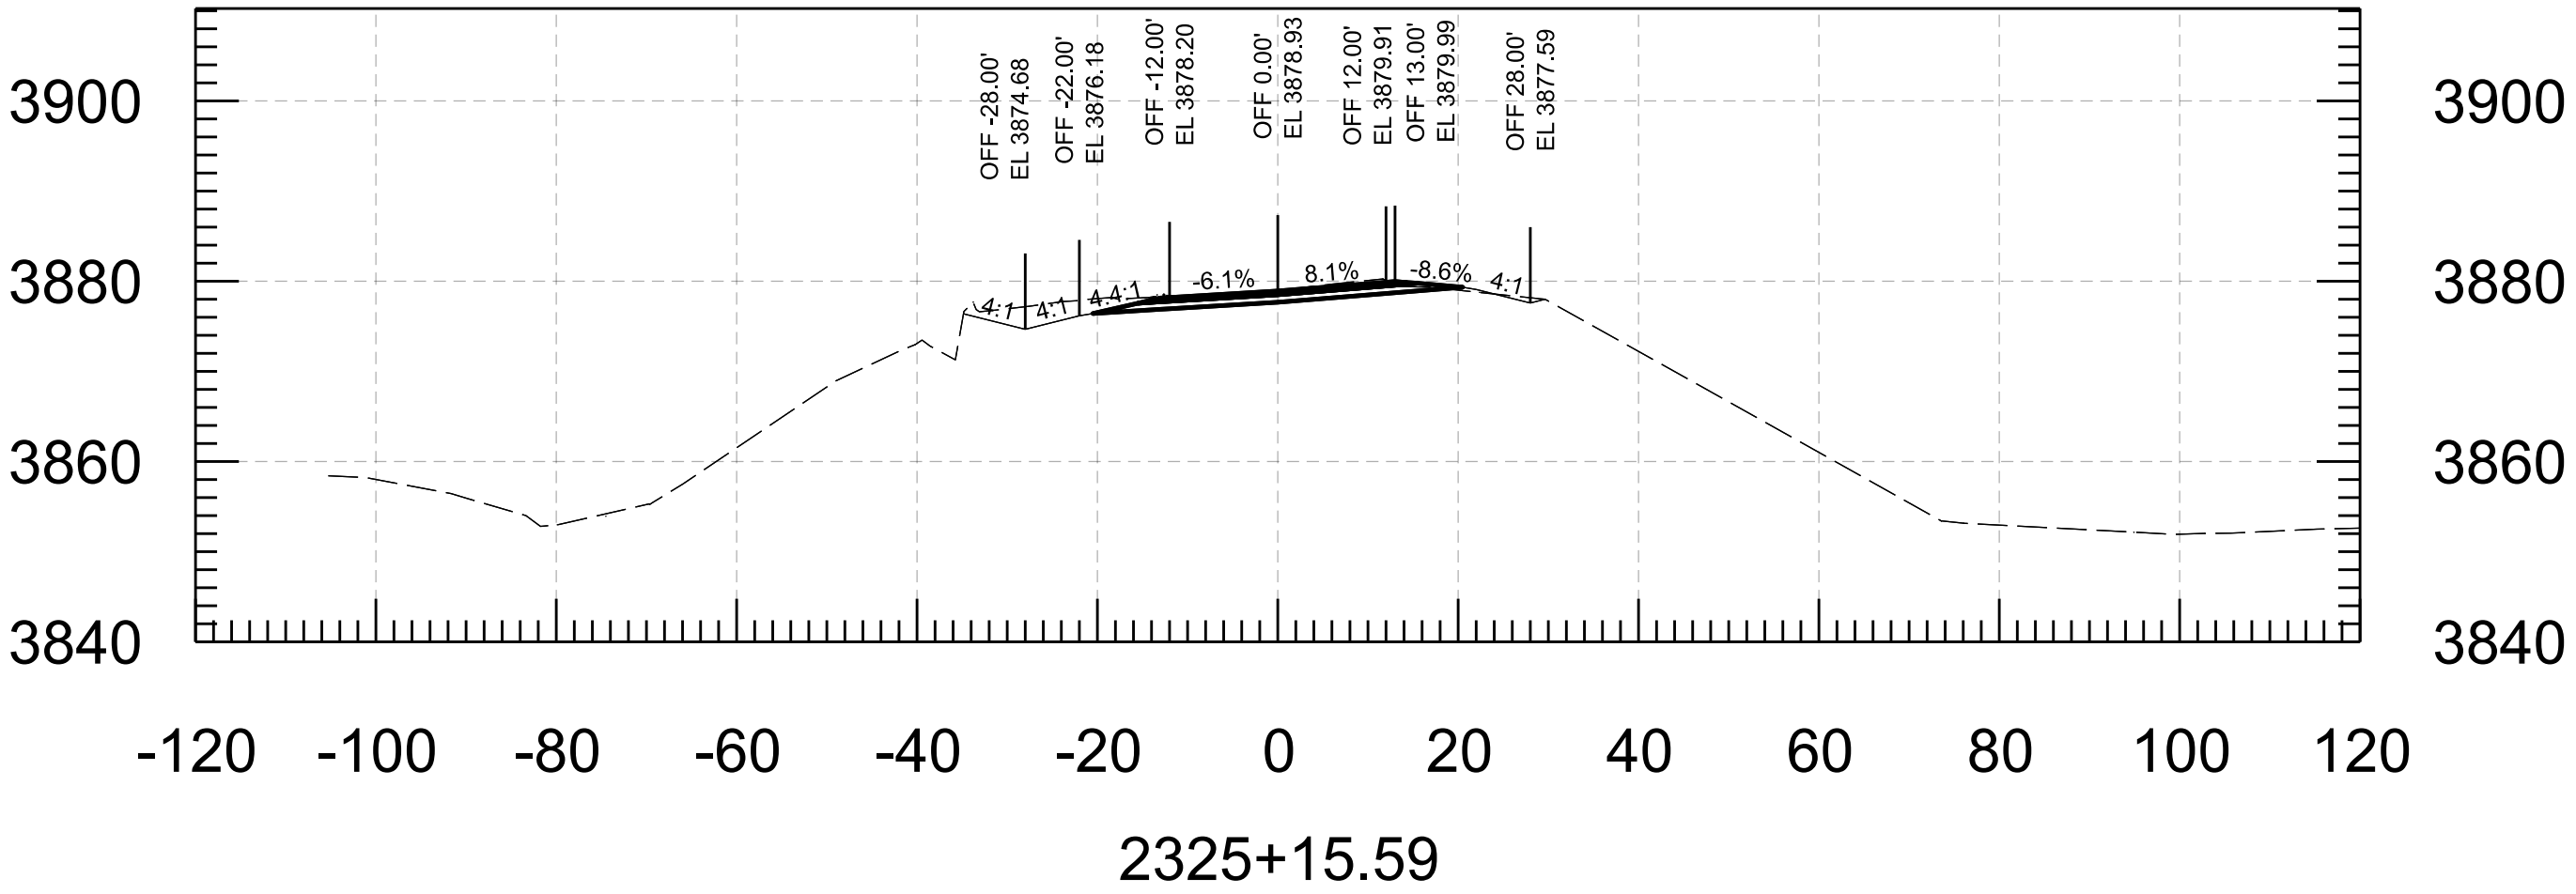

PRELIMINARY
STAGE V
Review
NOT FOR
CONSTRUCTION
OR RECORDING

	NAME	DATE
DESIGN	I. BYSTROV	3/26
DRAWN	P. MEEK	3/26
CHECKED	E. EGGEN	3/26
TEAM LEADER	E. EGGEN	3/26

ARIZONA DEPARTMENT OF TRANSPORTATION
PROJECT DELIVERY AND OPERATIONS DIVISION
ROADWAY DESIGN SECTION

CROSS SECTIONS

ROUTE
SR 82

MILEPOST

STRUCTURE NO.

F.H.W.A. Arizona Division

STATE

ARIZ.

PROJECT NO.

082 CH 061

FEDERAL ID NO.

082-A(210)T

SHEET NO.

9

TOTAL SHEETS

9

RECORD DRAWING

LOCATION SAN PEDRO RIVER BRIDGE NO. 20310

TRACS NO. F0522 01C

SHEET OF

___ OF ___